
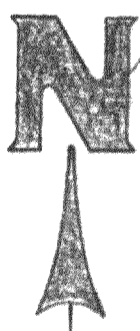
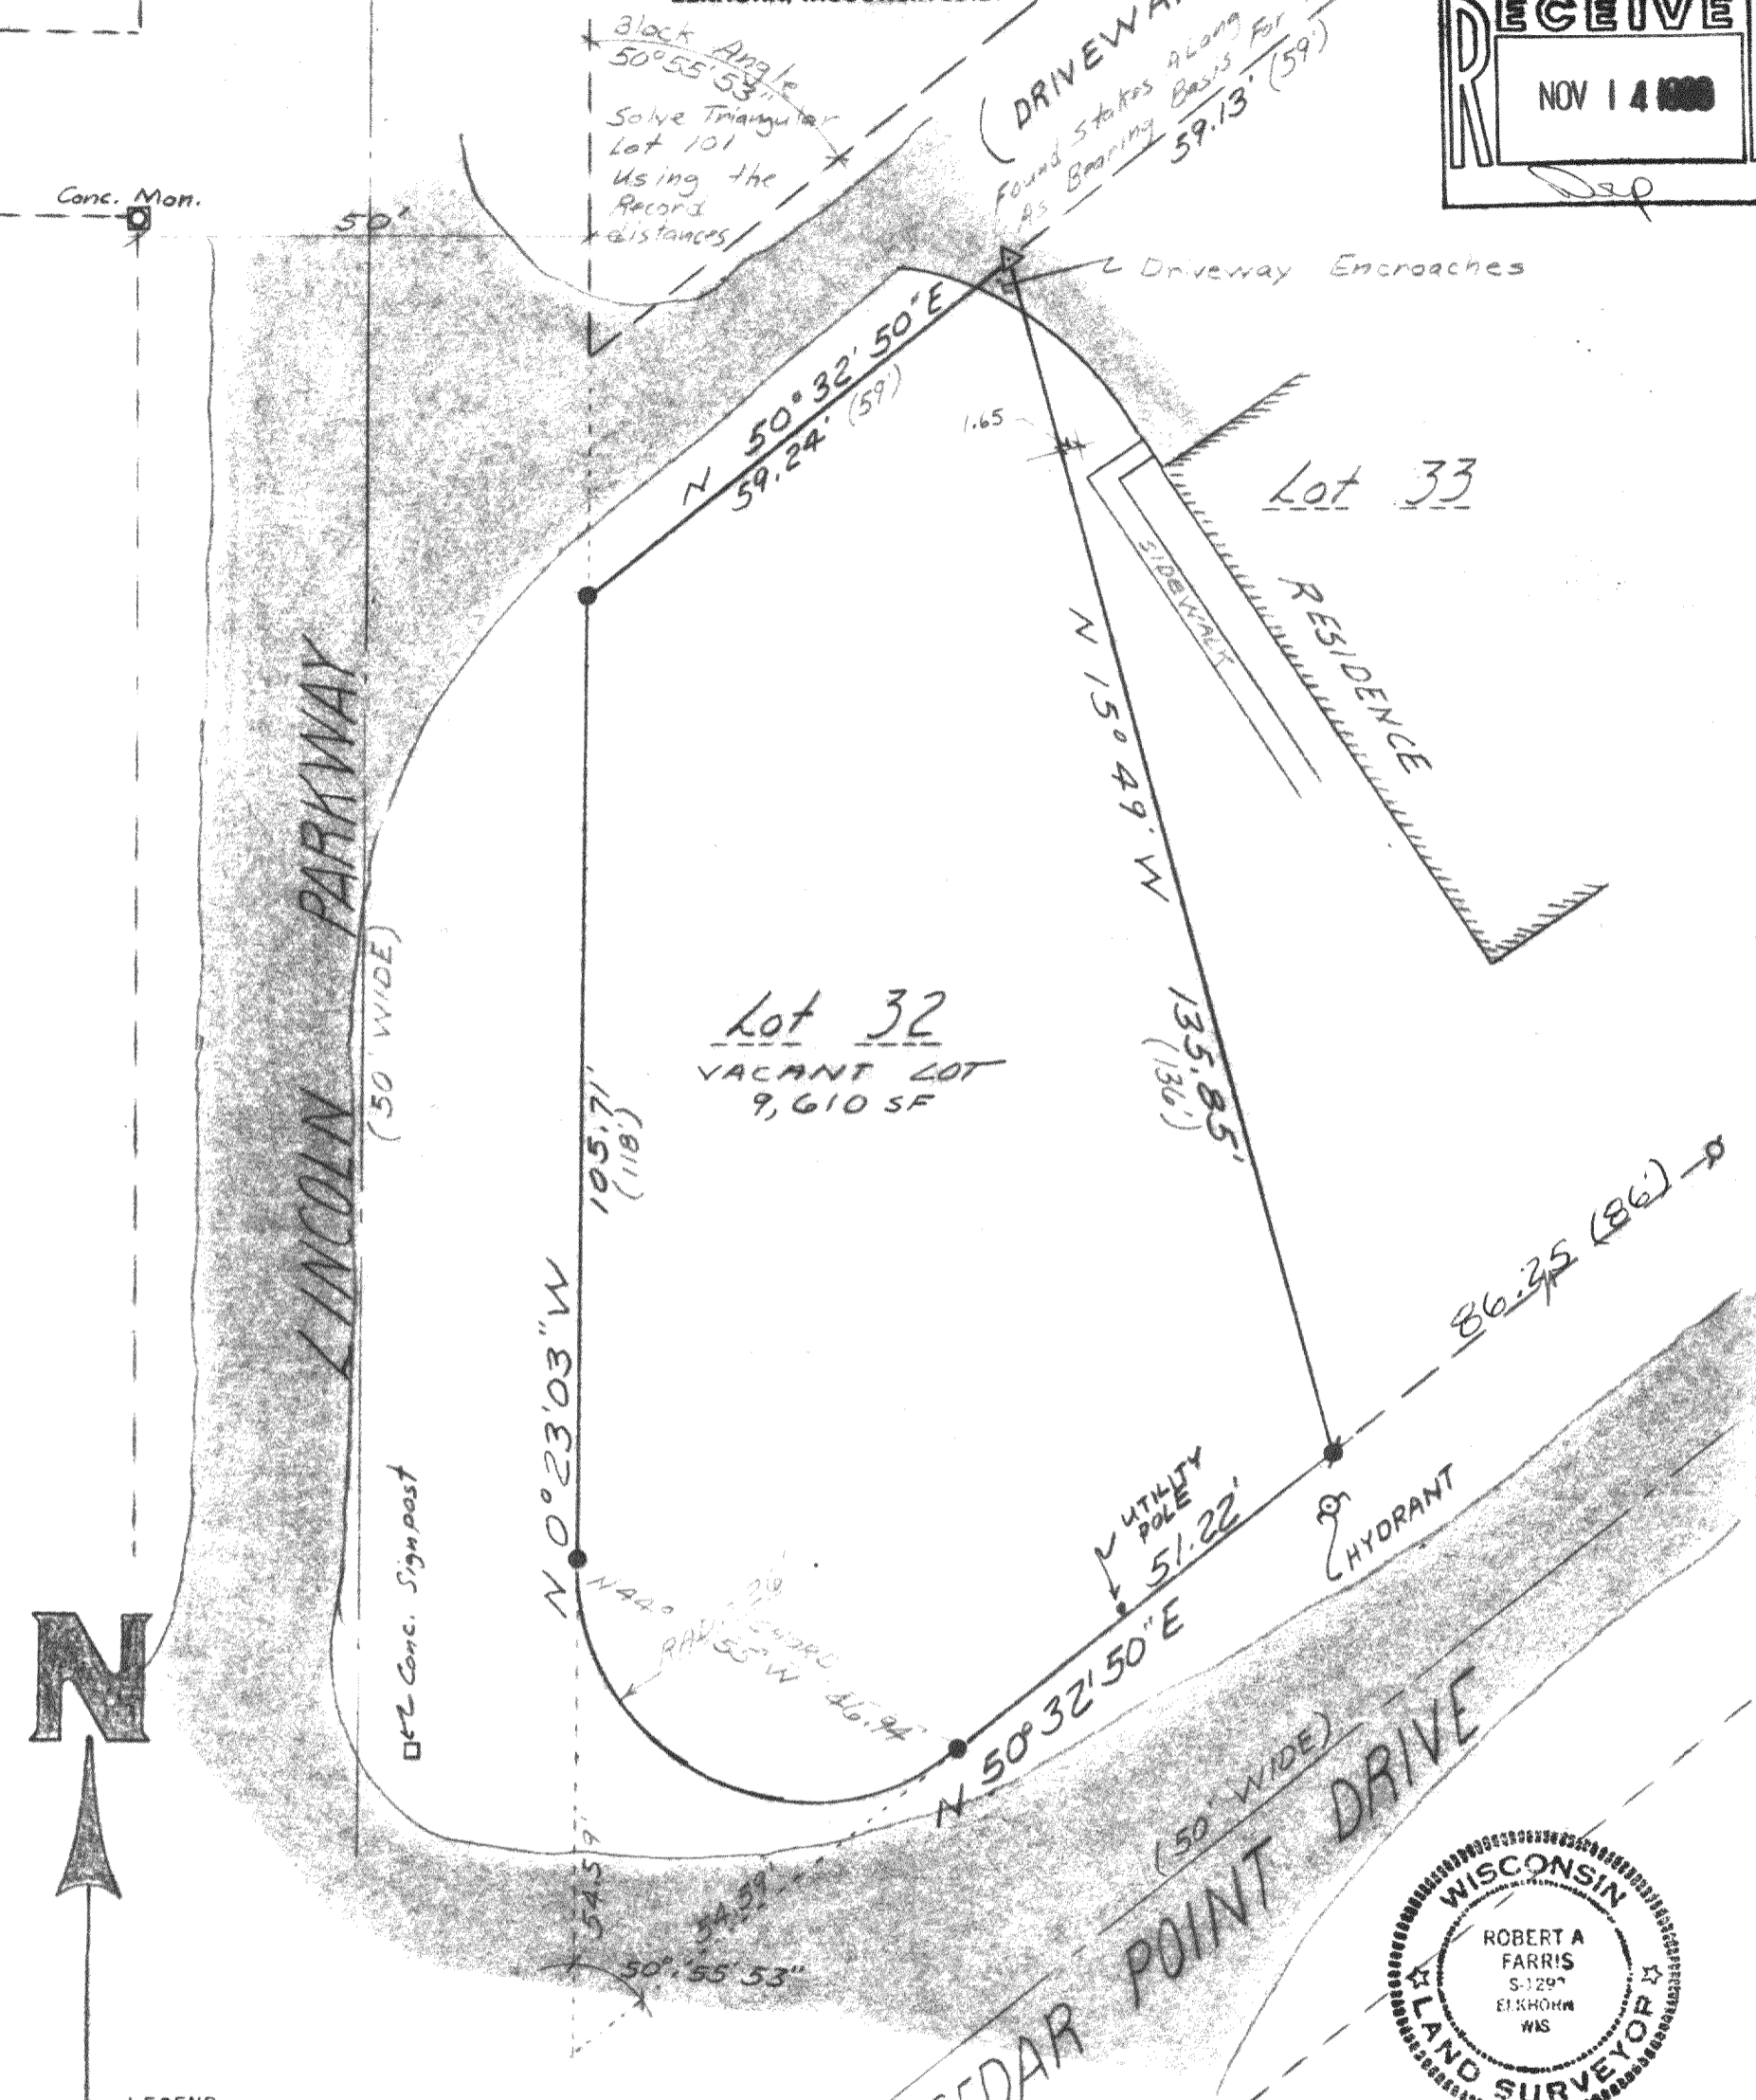


Farris, Hansen & Associates, Inc.

Engineers, Architects and Surveyors
 P.O. BOX 487
 7 RIDGEWAY COURT
 ELKHORN, WISCONSIN 53121

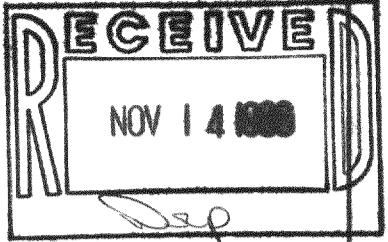

LEGEND

- ⊙ = Iron Pipe Survey Stake Found
- = Iron Pipe Survey Stake Set
- (x x x) = Record Dimension
- = Iron Rod Survey Stake Set
- ⊕ = Iron Rod Survey Stake Found

CERTIFICATE

I hereby certify that the above described property has been surveyed under my direction and that the above map is a true representation thereof and shows the size and location of the property, its exterior boundaries, the location of all visible structures and dimensions of all principal buildings thereon, boundary fences, apparent easements, roadways and visible encroachments, if any.
 This survey is made for the use of the present owners of the property, and also for those who purchase, mortgage, or guarantee the title thereto within one (1) year from the date hereof.

Robert A. Farris
 Robert A. Farris, R.L.S.

Dated this 13th day of NOV., 1988

PROJECT NO. 2691

WORK ORDERED BY MIDWEST REALTY



PLAT OF SURVEY
 LOT 32 CEDAR POINT PARK SUB.
 VILLAGE OF WILLIAMS BAY
 WALWORTH CO., WIS.