


WALWORTH COUNTY
SURVEYING & MAPPING
LAKE GENEVA, WISCONSIN



PLAT OF SURVEY OF
3rd add
LOT 206 AND THE NORTH 3/4 OF LOT
207 OF CEDAR POINT PARK, LOCATED
IN THE VILLAGE OF WILLIAMS BAY,
WALWORTH COUNTY, WISCONSIN.

ORDERED BY: COLDWELL BANKER
GENEVA LAKES AREA REALTORS
838 MAIN STREET
LAKE GENEVA, WISCONSIN 53147

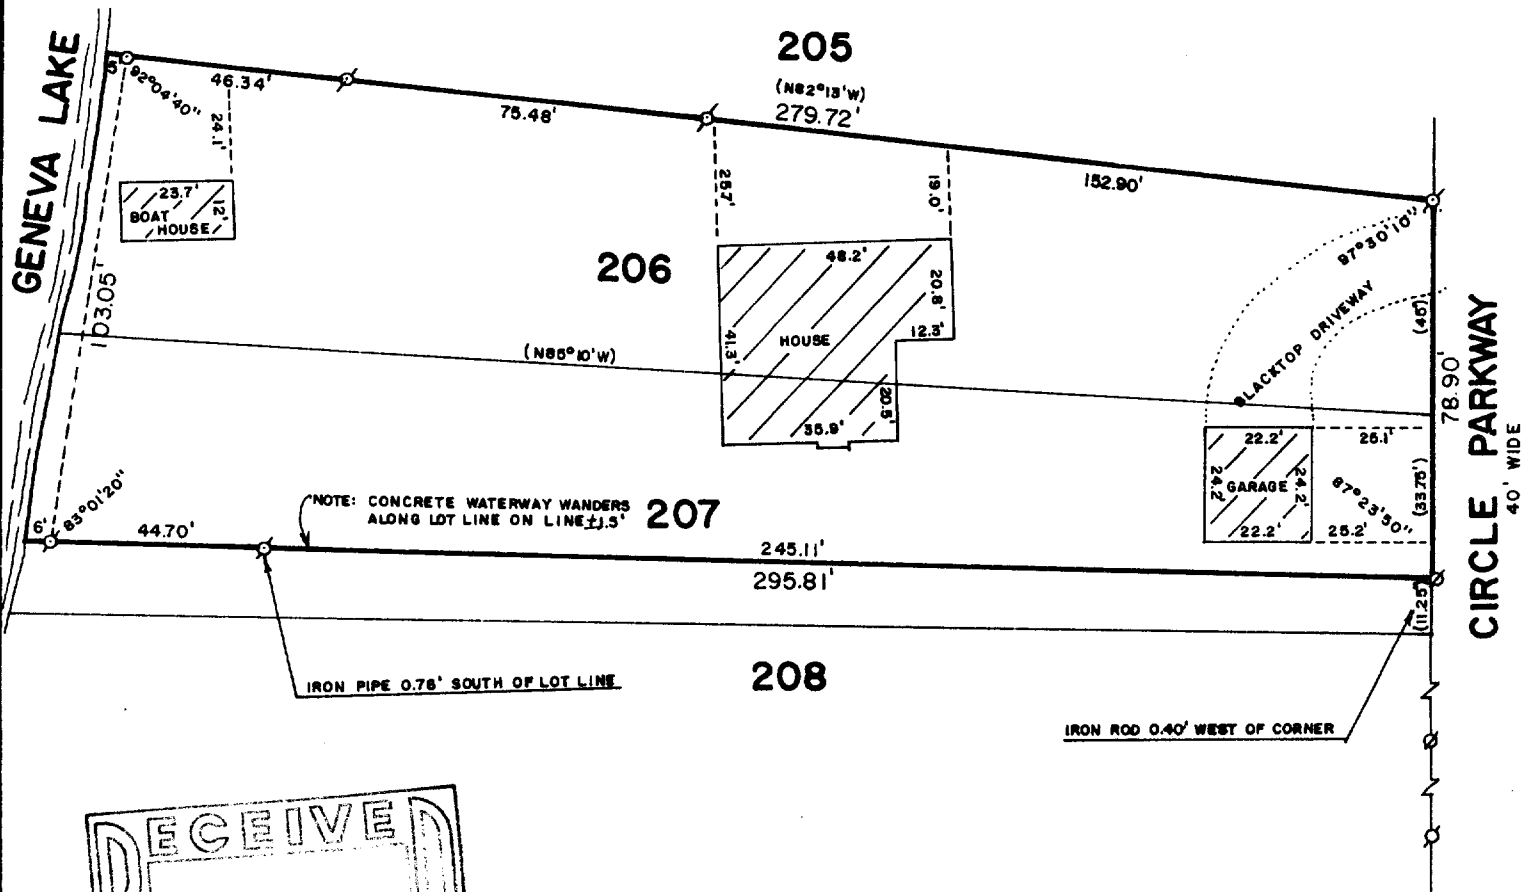

SCALE: 1"=40'

- ø - IRON PIPE FOUND
- ø - IRON ROD FOUND
- o - IRON ROD PLACED
- () - RECORDED AS

I, ROBERT M. BAERENWALD, DO HEREBY CERTIFY THAT I
HAVE SURVEYED THE PROPERTY HEREON DESCRIBED ACCORDING
TO THE OFFICIAL RECORDS AND THAT THE PLAT HEREON IS A
CORRECT REPRESENTATION OF THE PROPERTY LINES TO THE
BEST OF MY KNOWLEDGE AND BELIEF.

Robert M. Baerenwald
ROBERT M. BAERENWALD
WISCONSIN REGISTERED LAND SURVEYOR, S-1508

Oct. 23, 1986
DATE JOB NO. 0738

NOTE: THIS IS NOT A CERTIFIED COPY UNLESS SEALED.

WCP 3-6

11-5248