


## CIRCLE PARKWAY

ORDERED BY: GENEVA LAKEFRONT REALTY  
P. O. BOX 901  
WILLIAMS BAY, WISCONSIN 53191

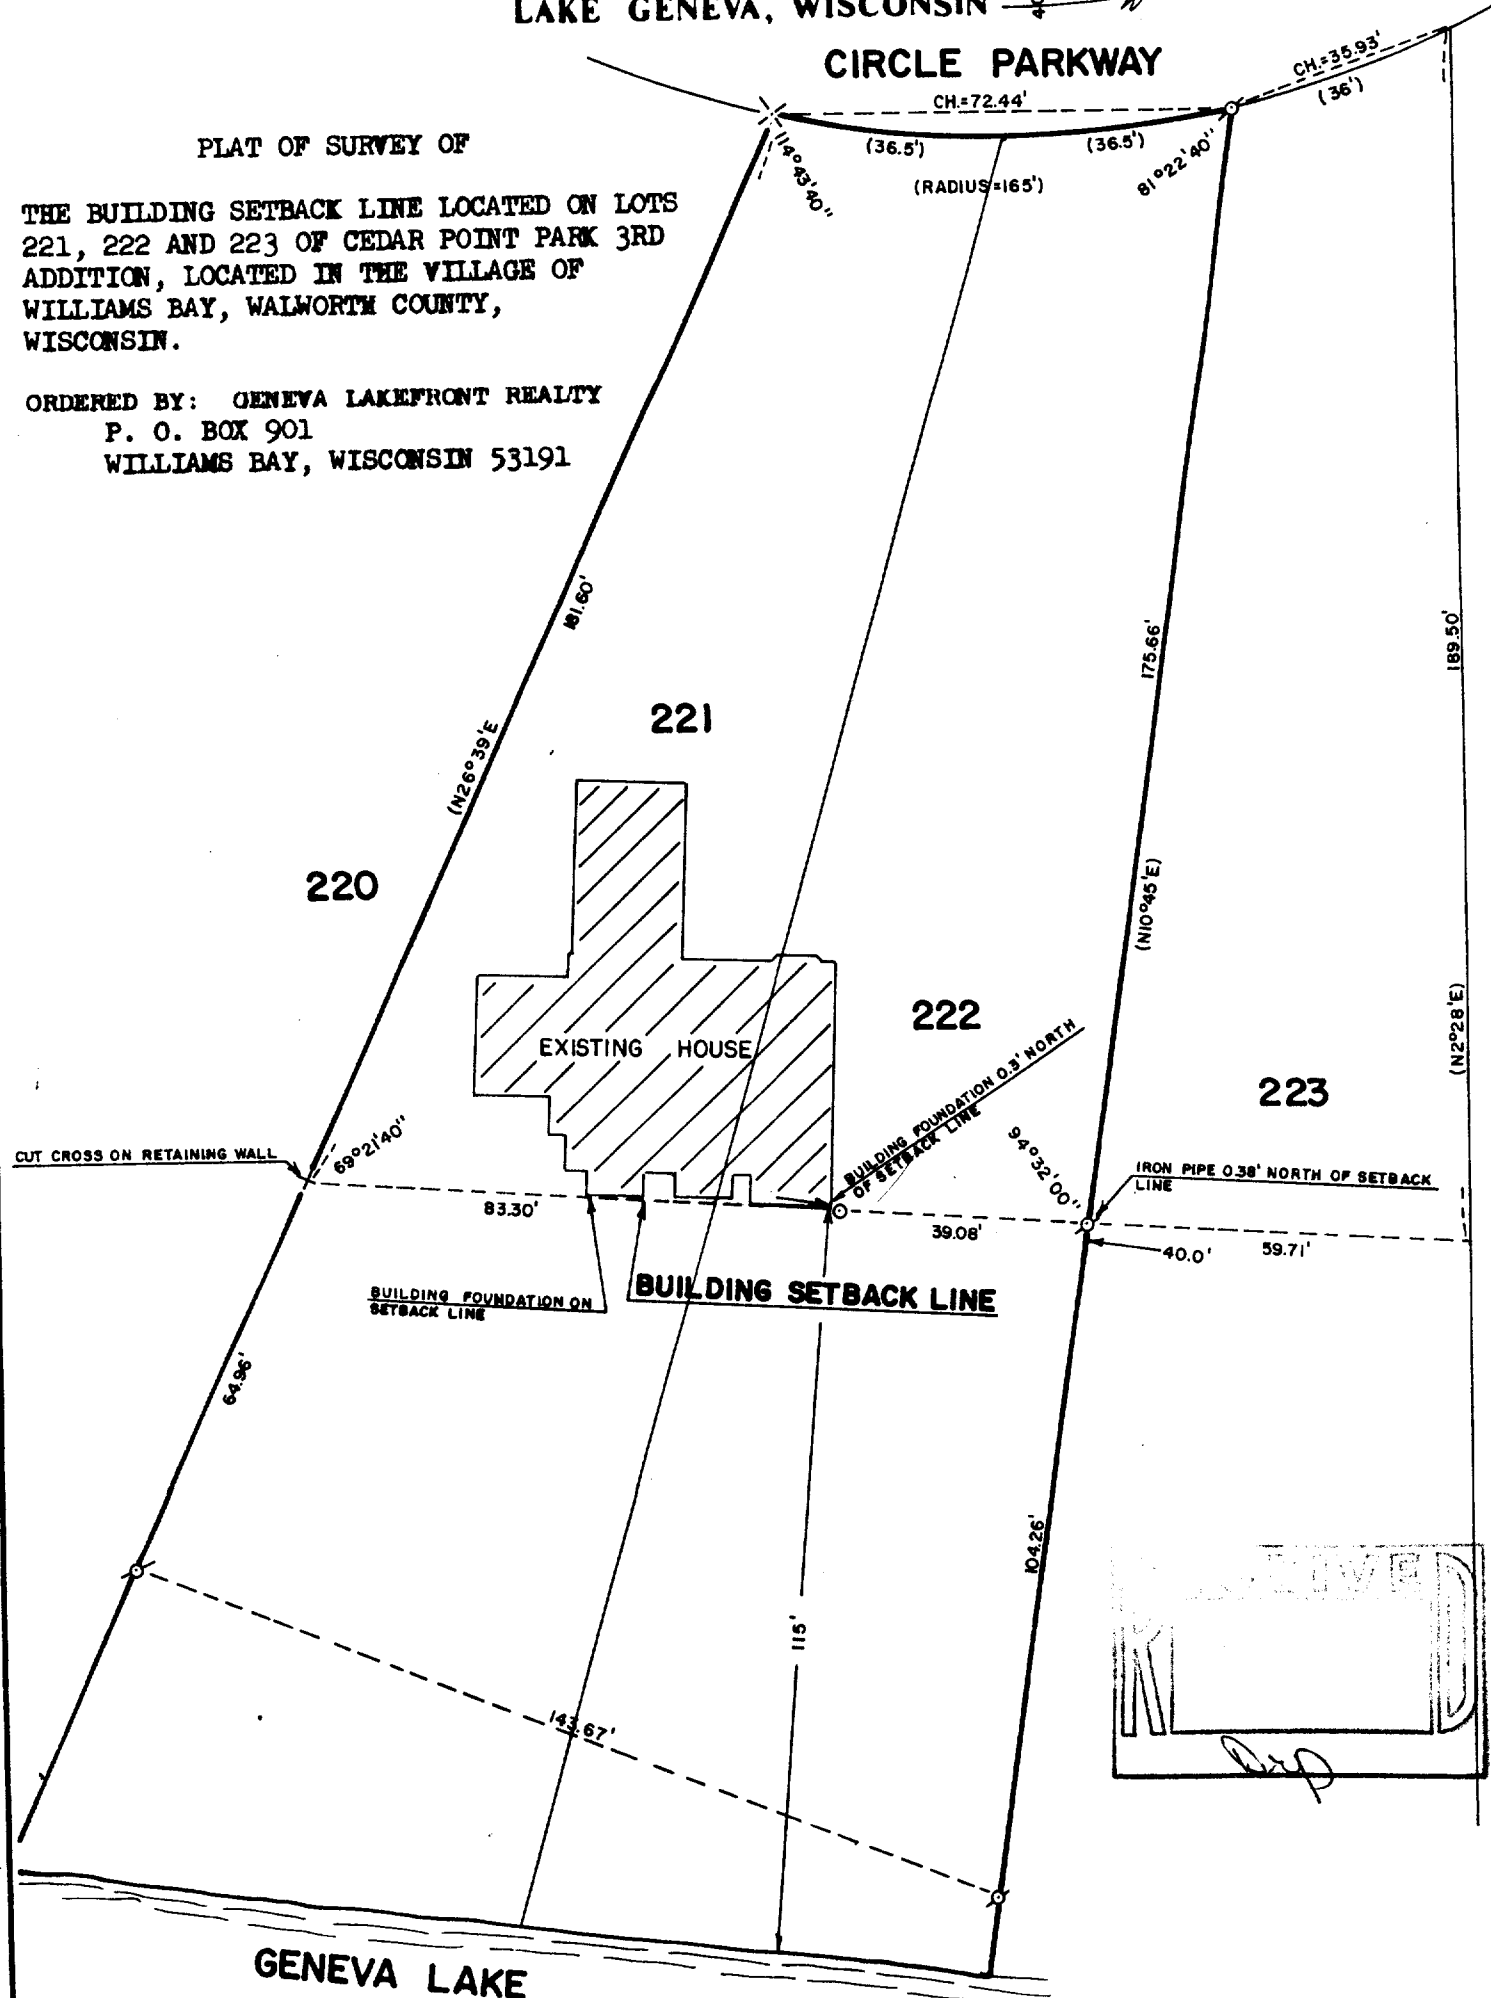

**GENEVA LAKE**



SCALE: 1"=30'

- ♂ - IRON PIPE FOUND  
 ✕ - RAILROAD SPIKE FOUND  
 ○ - IRON ROD PLACED  
 ( ) - RECORDED AS

I, ROBERT M. BAERENWALD, DO HEREBY CERTIFY THAT I HAVE SURVEYED THE PROPERTY HEREON DESCRIBED ACCORDING TO THE OFFICIAL RECORDS AND THAT THE PLAT HEREON IS A CORRECT REPRESENTATION OF THE PROPERTY LINES TO THE BEST OF MY KNOWLEDGE AND BELIEF.

*Robert M. Baerenwald*  
ROBERT M. BAERENWALD  
WISCONSIN REGISTERED LAND SURVEYOR, S-1508

Dec. 19, 1986

JOB NO. 0888

NOTE: THIS IS NOT A CERTIFIED COPY UNLESS SEALED.