
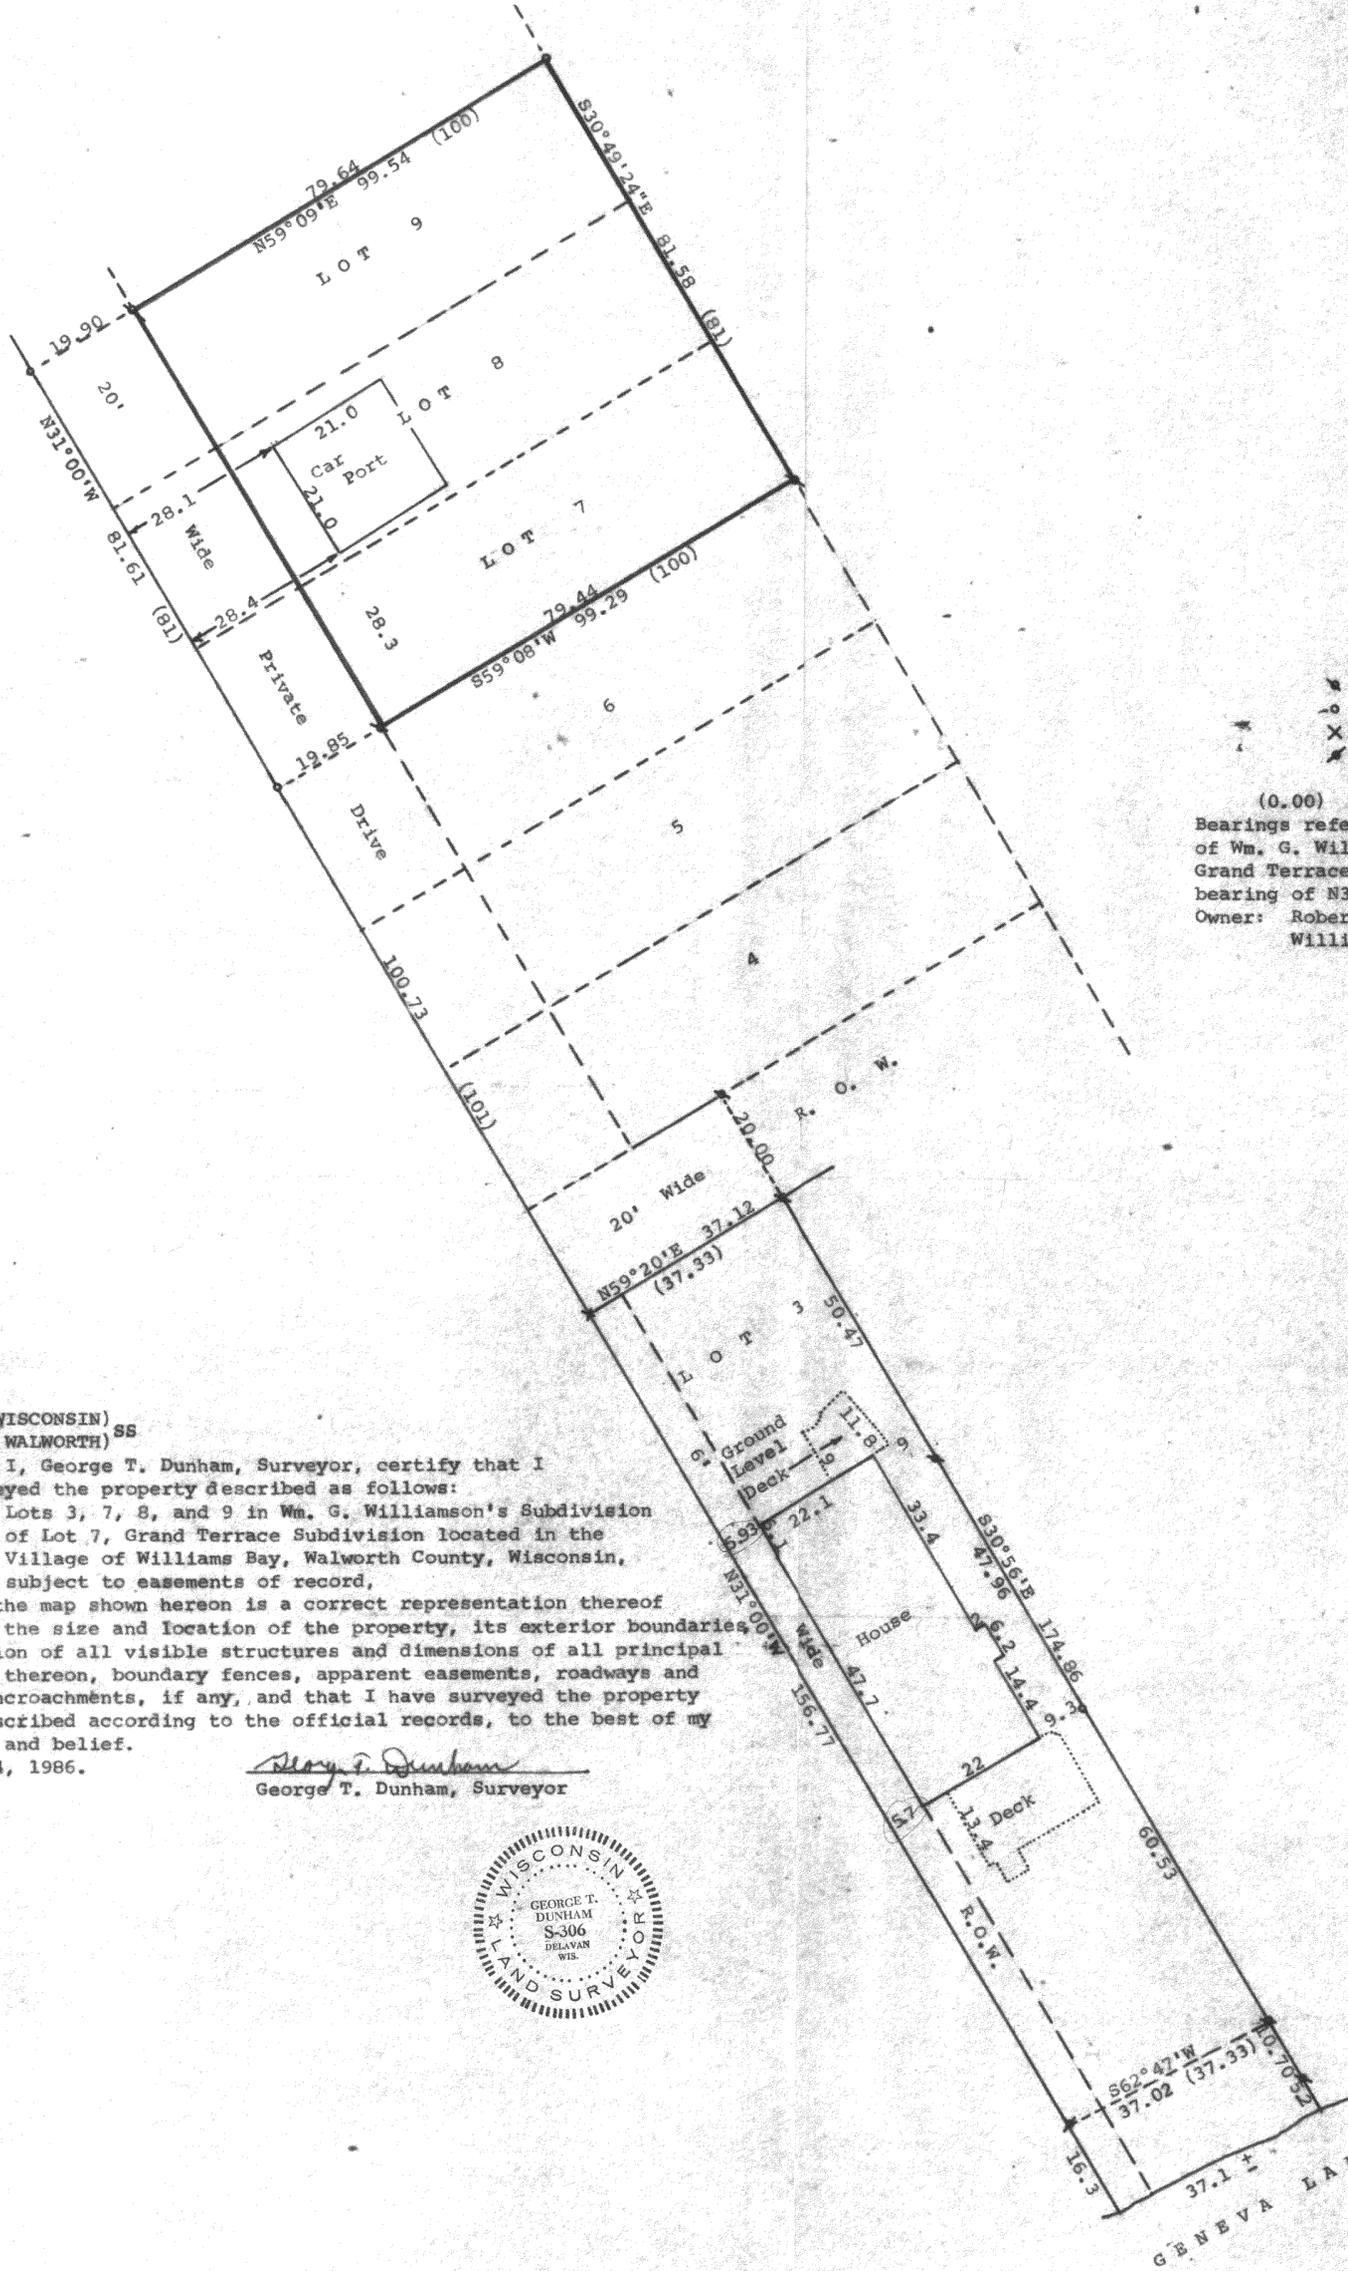


DUNHAM SURVEYING, S.C.
 SURVEYING & SUBDIVIDING
 DELAVAN, WISCONSIN 53115

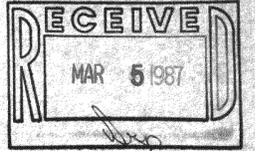

Scale - 1" = 20'
 * = 1" Iron Pipe Found
 o = 3/4" Iron Pipe Found
 X = cross in concrete found
 / = 1/2" Iron Pipe Found

(0.00) = recorded distance
 Bearings referenced to the southwesterly line
 of Wm. G. Williamson's Subdivision of Lot 7,
 Grand Terrace Subdivision, with the recorded
 bearing of N31°W
 Owner: Robert W. Harley
 Williams Bay, WI 53191

STATE OF WISCONSIN)
 COUNTY OF WALWORTH) SS
 I, George T. Dunham, Surveyor, certify that I
 have surveyed the property described as follows:
 Lots 3, 7, 8, and 9 in Wm. G. Williamson's Subdivision
 of Lot 7, Grand Terrace Subdivision located in the
 Village of Williams Bay, Walworth County, Wisconsin,
 subject to easements of record,
 and that the map shown hereon is a correct representation thereof
 and shows the size and location of the property, its exterior boundaries,
 the location of all visible structures and dimensions of all principal
 buildings thereon, boundary fences, apparent easements, roadways and
 visible encroachments, if any, and that I have surveyed the property
 hereon described according to the official records, to the best of my
 knowledge and belief.
 October 24, 1986.

George T. Dunham
 George T. Dunham, Surveyor

