


RECEIVED
MAR 5
Love



George T. Dunham, Surveyor

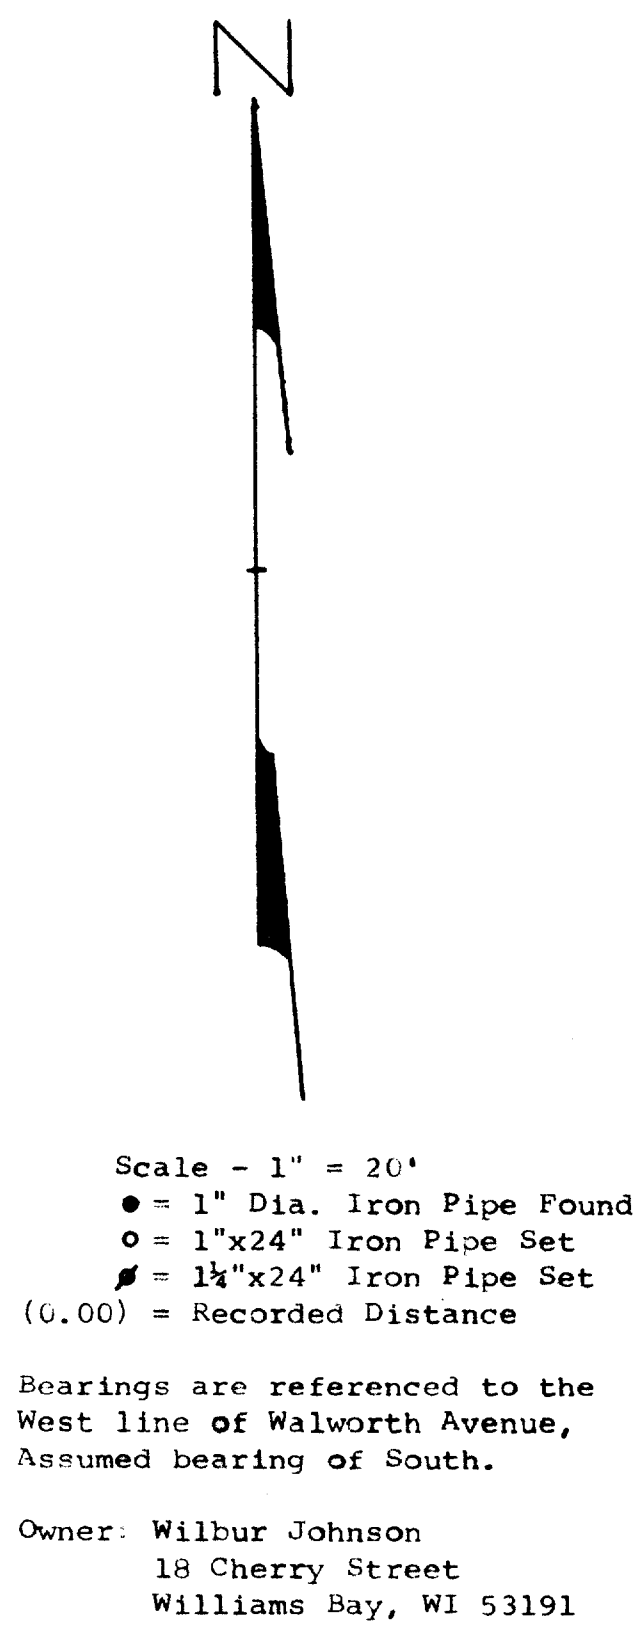