


RECEIVED
APR 21 1987
W. J. P.



LOT 182, CEDAR POINT PARK, 2nd
ADDITION, VILLAGE OF WILLIAMS
BAY, WALWORTH COUNTY, WISCONSIN.

ORDERED BY: ANCHOR SAVINGS &
LOAN
201 BROAD ST.
LAKE GENEVA, WI.
53147

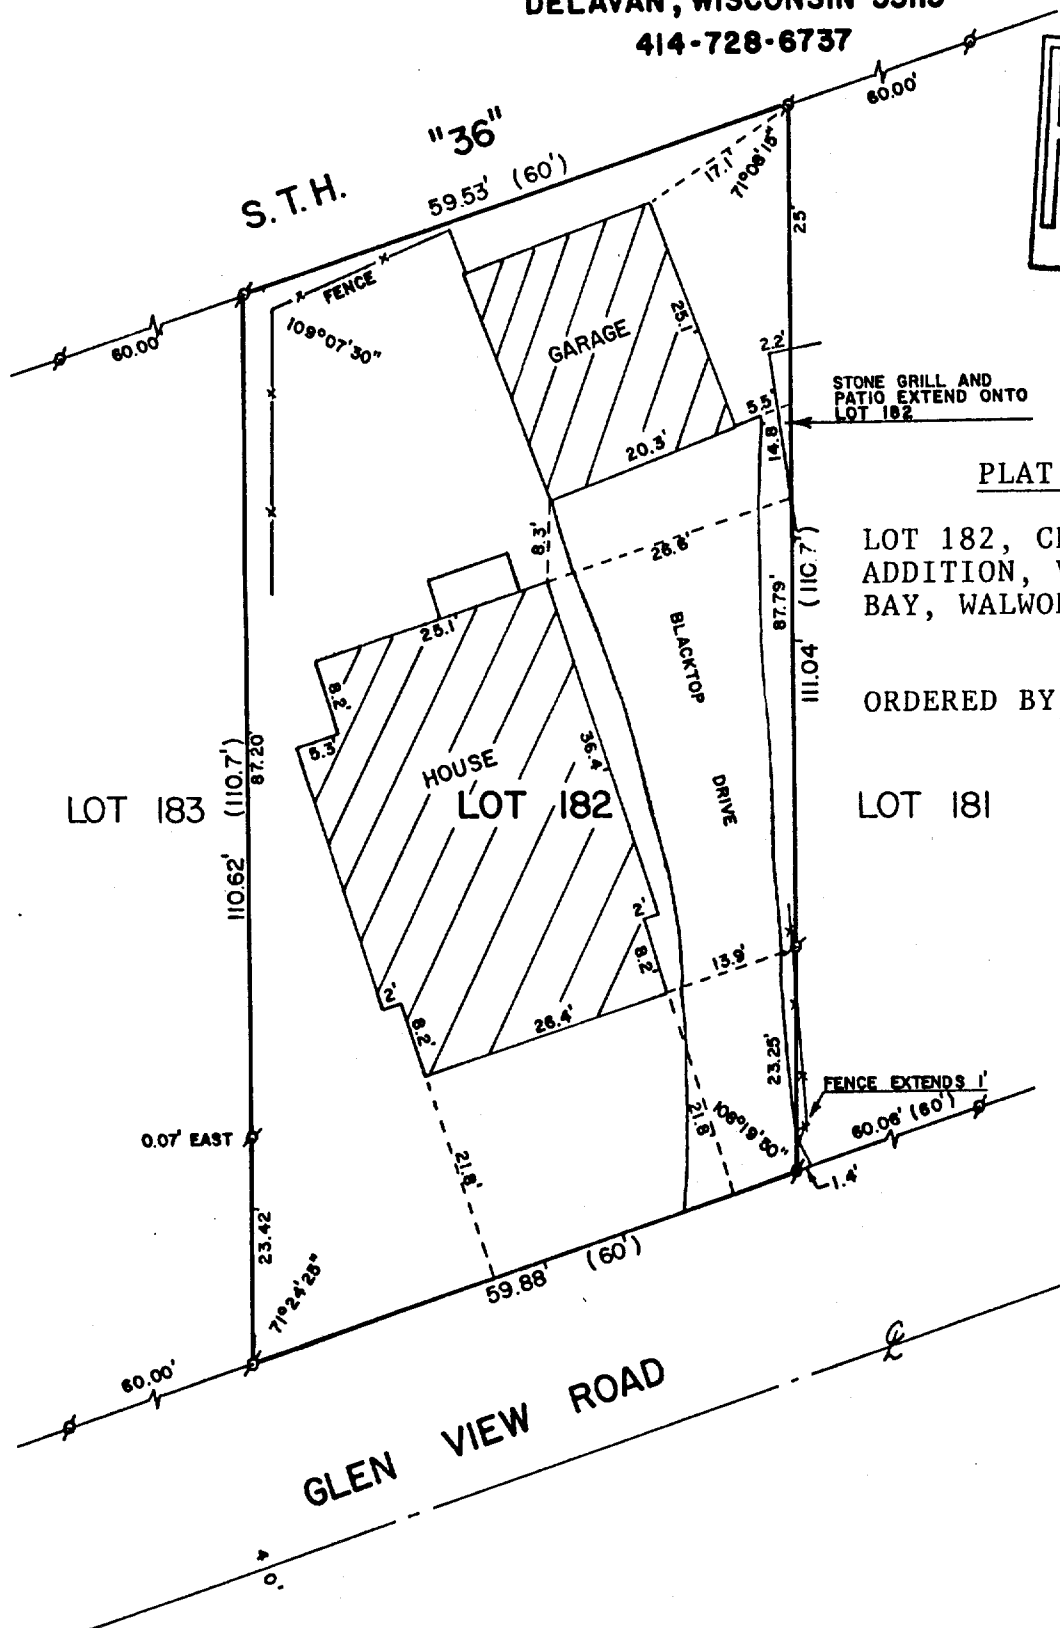

LEGEND

- ♂ - IRON PIPE FOUND
 ♀ - CONCRETE MONUMENT FOUND
 () - RECORDED AS

I, DAVID F. ABELL, DO HEREBY CERTIFY THAT I HAVE SURVEYED THE PROPERTY HEREON DESCRIBED ACCORDING TO THE OFFICIAL RECORDS AND THAT THE PLAT HEREON IS A CORRECT REPRESENTATION OF THE PROPERTY LINES TO THE BEST OF MY KNOWLEDGE AND BELIEF.

David F. Abell
 DAVID F. ABELL
 WISCONSIN REGISTERED LAND SURVEYOR, S-1596

February 16, 1987
DATE _____ JOB NUMBER - 87013
NOTE: THIS IS NOT A CERTIFIED COPY UNLESS SEALED.