



# ORCHARD STREET

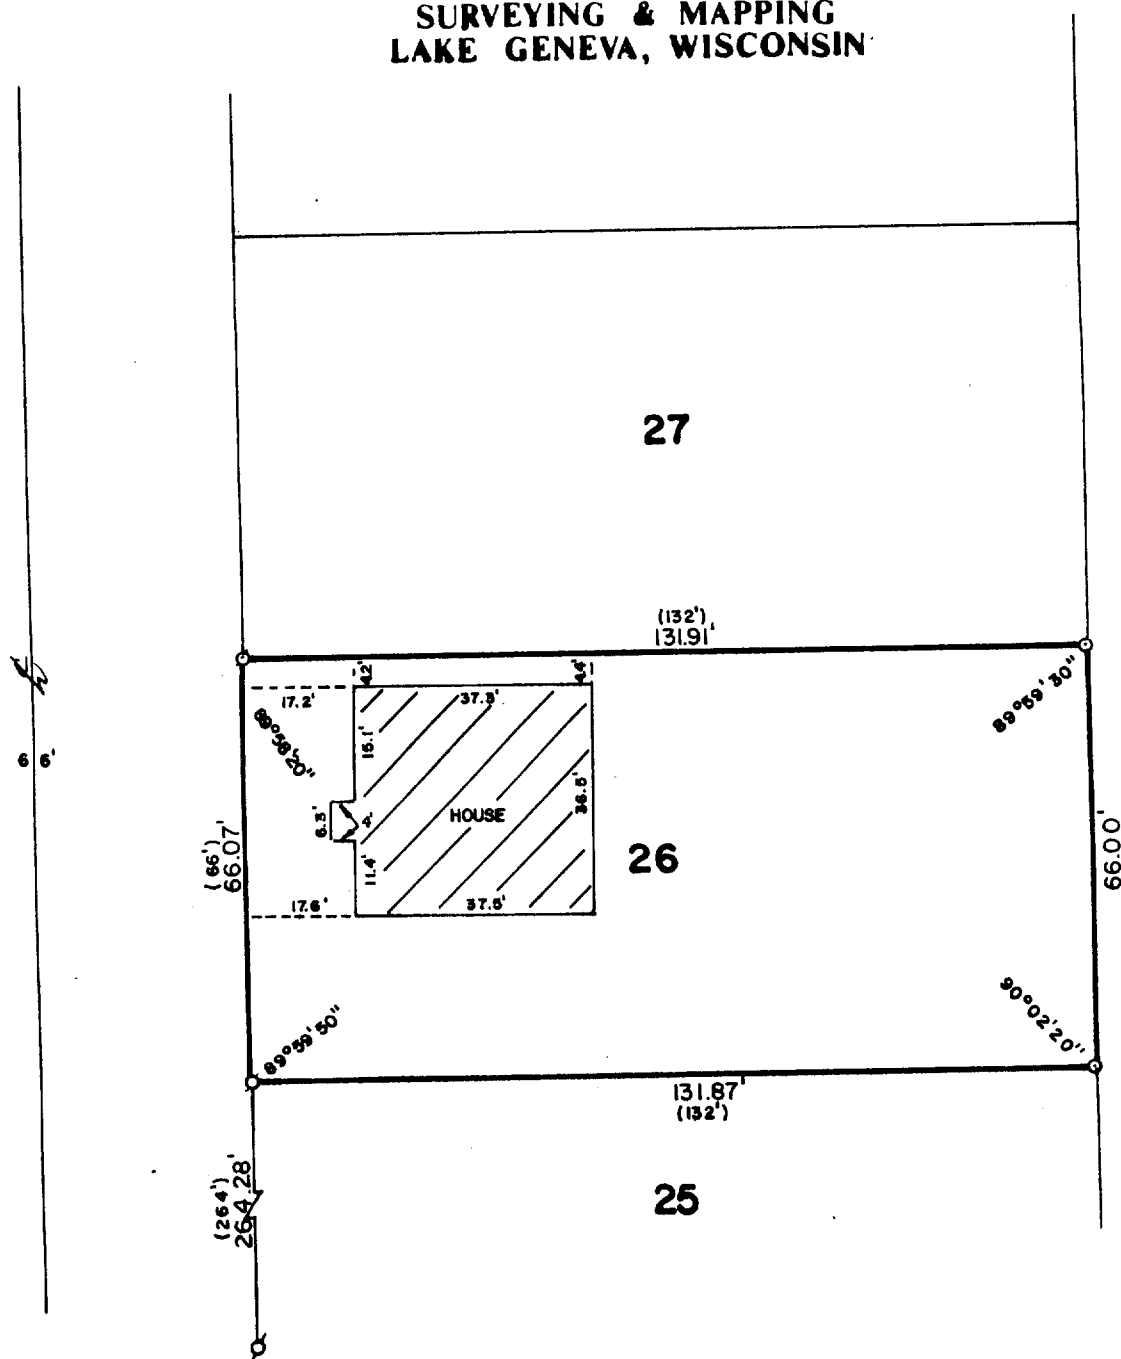

LOT 26 OF LOCKWOODS ADDITION TO THE  
VILLAGE OF WILLIAMS BAY, WALWORTH  
COUNTY, WISCONSIN.

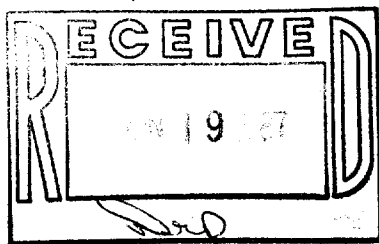

ORDERED BY: ASSURED REALTY  
P. O. BOX 367  
WILLIAMS BAY, WISCONSIN



♂ - IRON PIPE FOUND  
 ○ - IRON ROD PLACED  
 ( ) - RECORDED AS

I, ROBERT M. BAERENWALD, DO HEREBY CERTIFY THAT I HAVE SURVEYED THE PROPERTY HEREON DESCRIBED ACCORDING TO THE OFFICIAL RECORDS AND THAT THE PLAT HEREON IS A CORRECT REPRESENTATION OF THE PROPERTY LINES TO THE BEST OF MY KNOWLEDGE AND BELIEF.

BEST OF MY KNOWLEDGE AND BELIEF.

Robert M. Baerenwald

ROBERT M. BAERENWALD  
WISCONSIN REGISTERED LAND SURVEYOR, S-1508

DATE May 8, 1987 JOB NO. 1036

NOTE: THIS IS NOT A CERTIFIED COPY UNLESS SEALED.