


CIRCLE PARKWAY

PLAT REVISED TO SHOW HOUSE
ADDITION MAY 1, 1987.



GENEVA LAKE

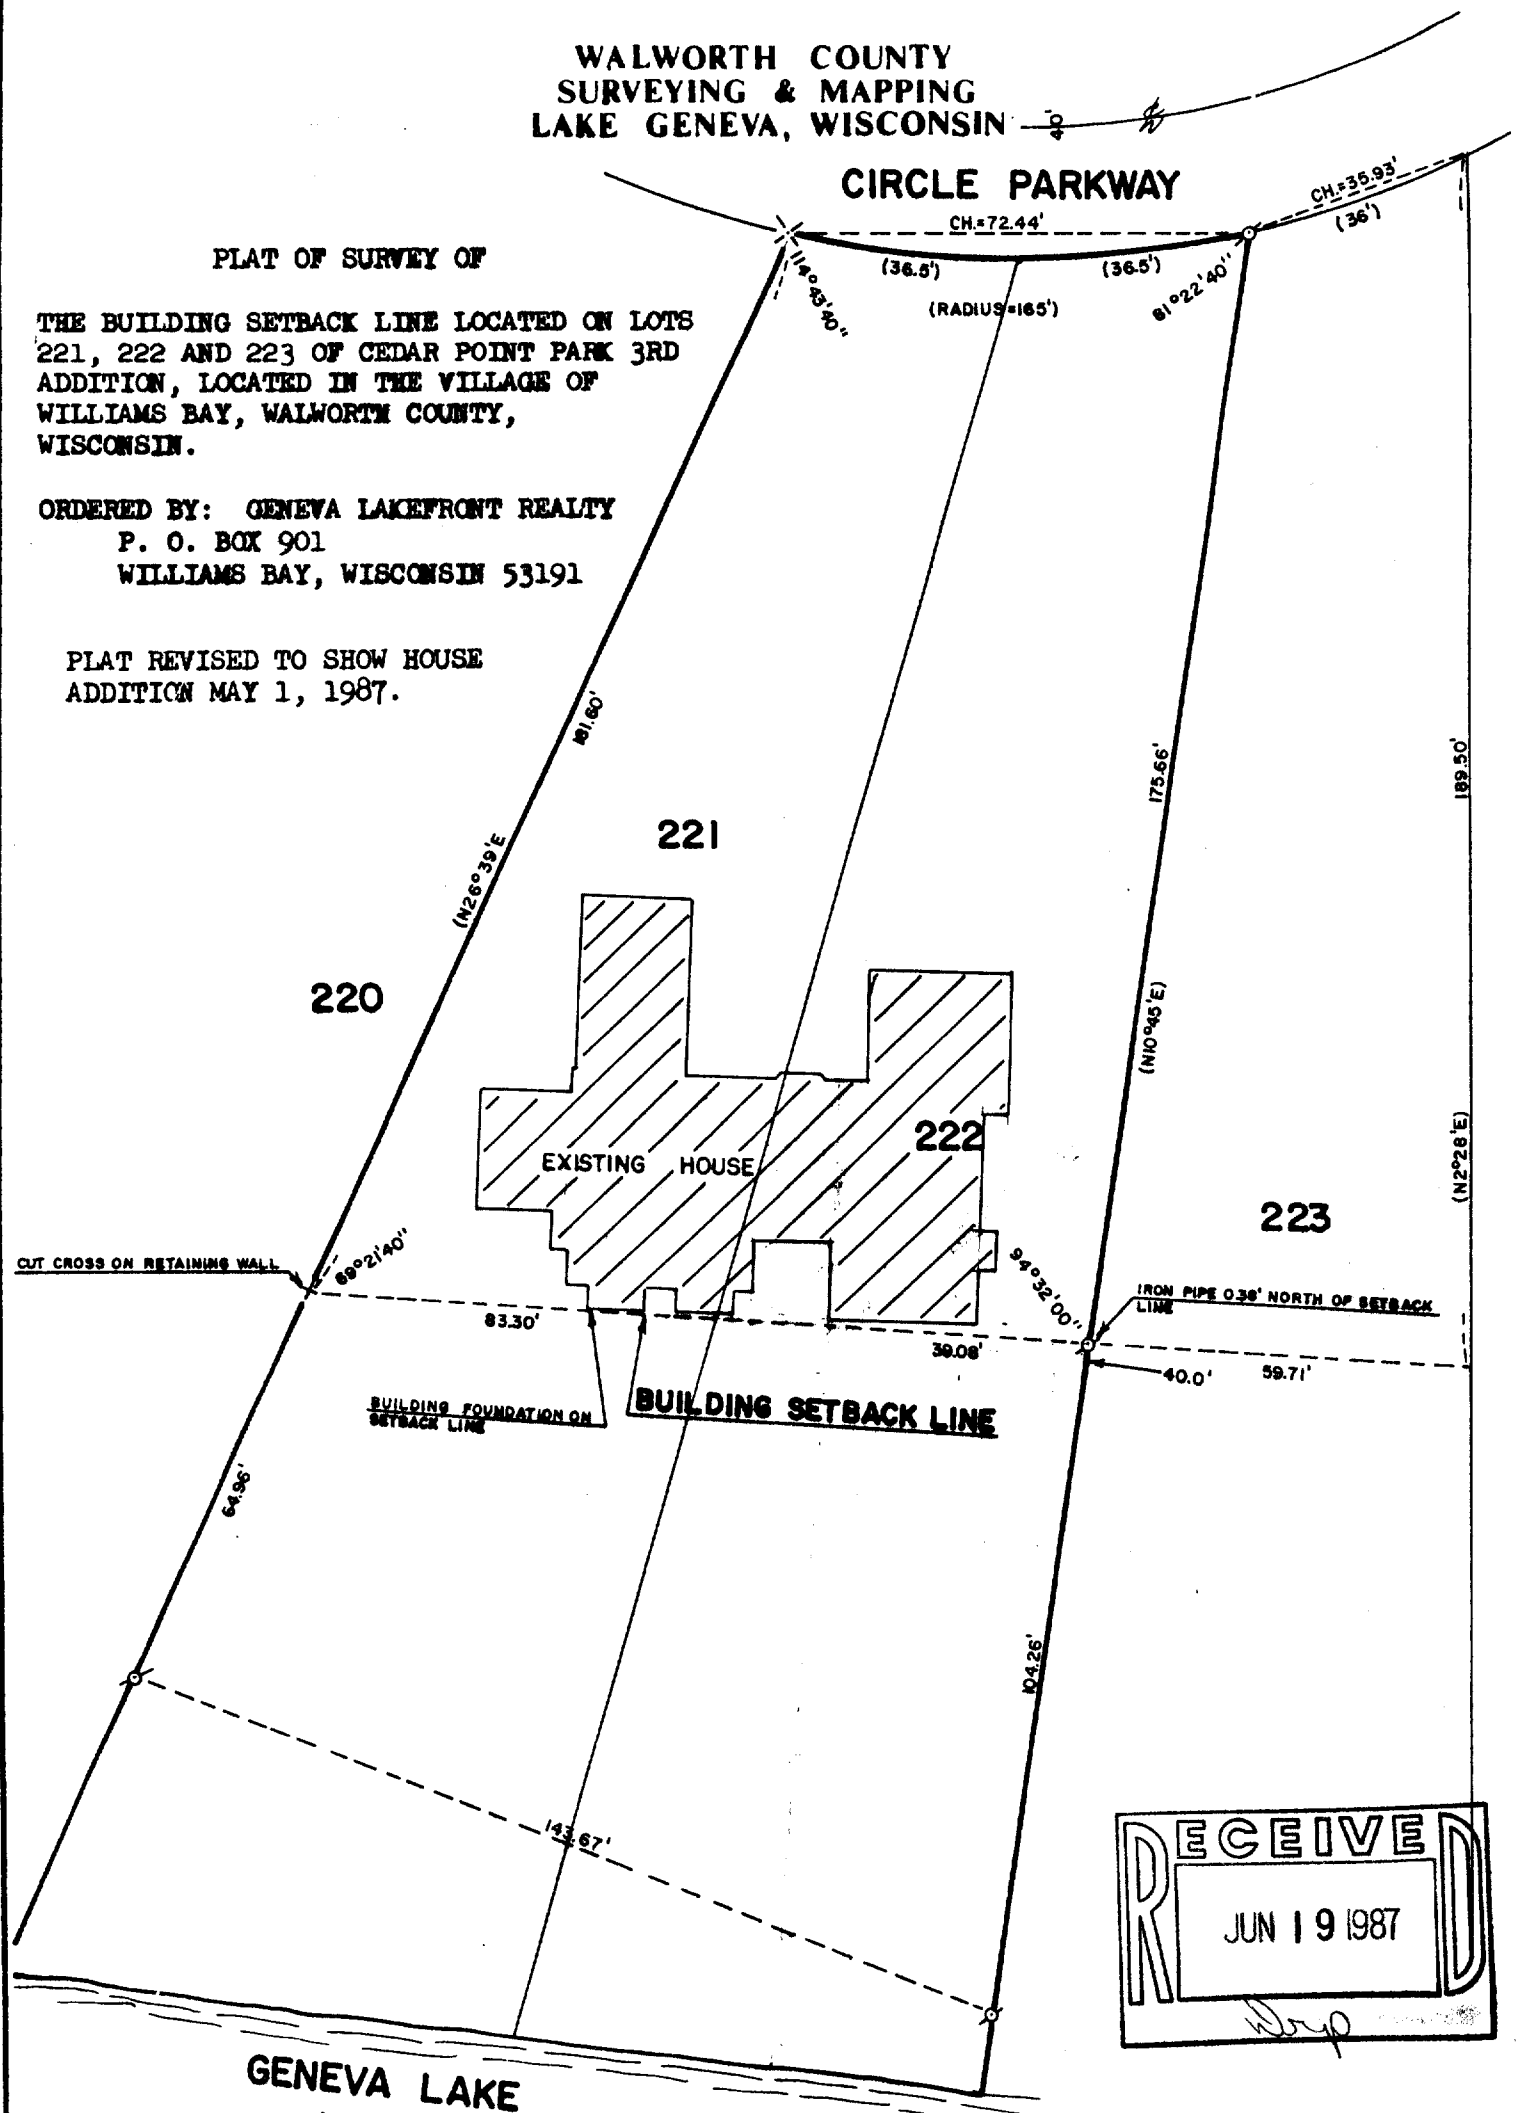

WCP 3-19, 20

NOTE: THIS IS NOT A CERTIFIED COPY UNLESS SEALED.

RECEIVED
JUN 19 1987

11-5641