

WALWORTH COUNTY  
SURVEYING & MAPPING  
LAKE GENEVA, WISCONSIN



CIRCLE PARKWAY

PLAT OF SURVEY OF

THE BUILDING SETBACK LINE LOCATED ON LOTS  
221, 222 AND 223 OF CEDAR POINT PARK 3RD  
ADDITION, LOCATED IN THE VILLAGE OF  
WILLIAMS BAY, WALWORTH COUNTY,  
WISCONSIN.

ORDERED BY: GENEVA LAKEFRONT REALTY  
P. O. BOX 901  
WILLIAMS BAY, WISCONSIN 53191

PLAT REVISED TO SHOW HOUSE  
ADDITION MAY 1, 1987.

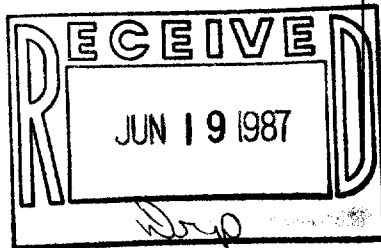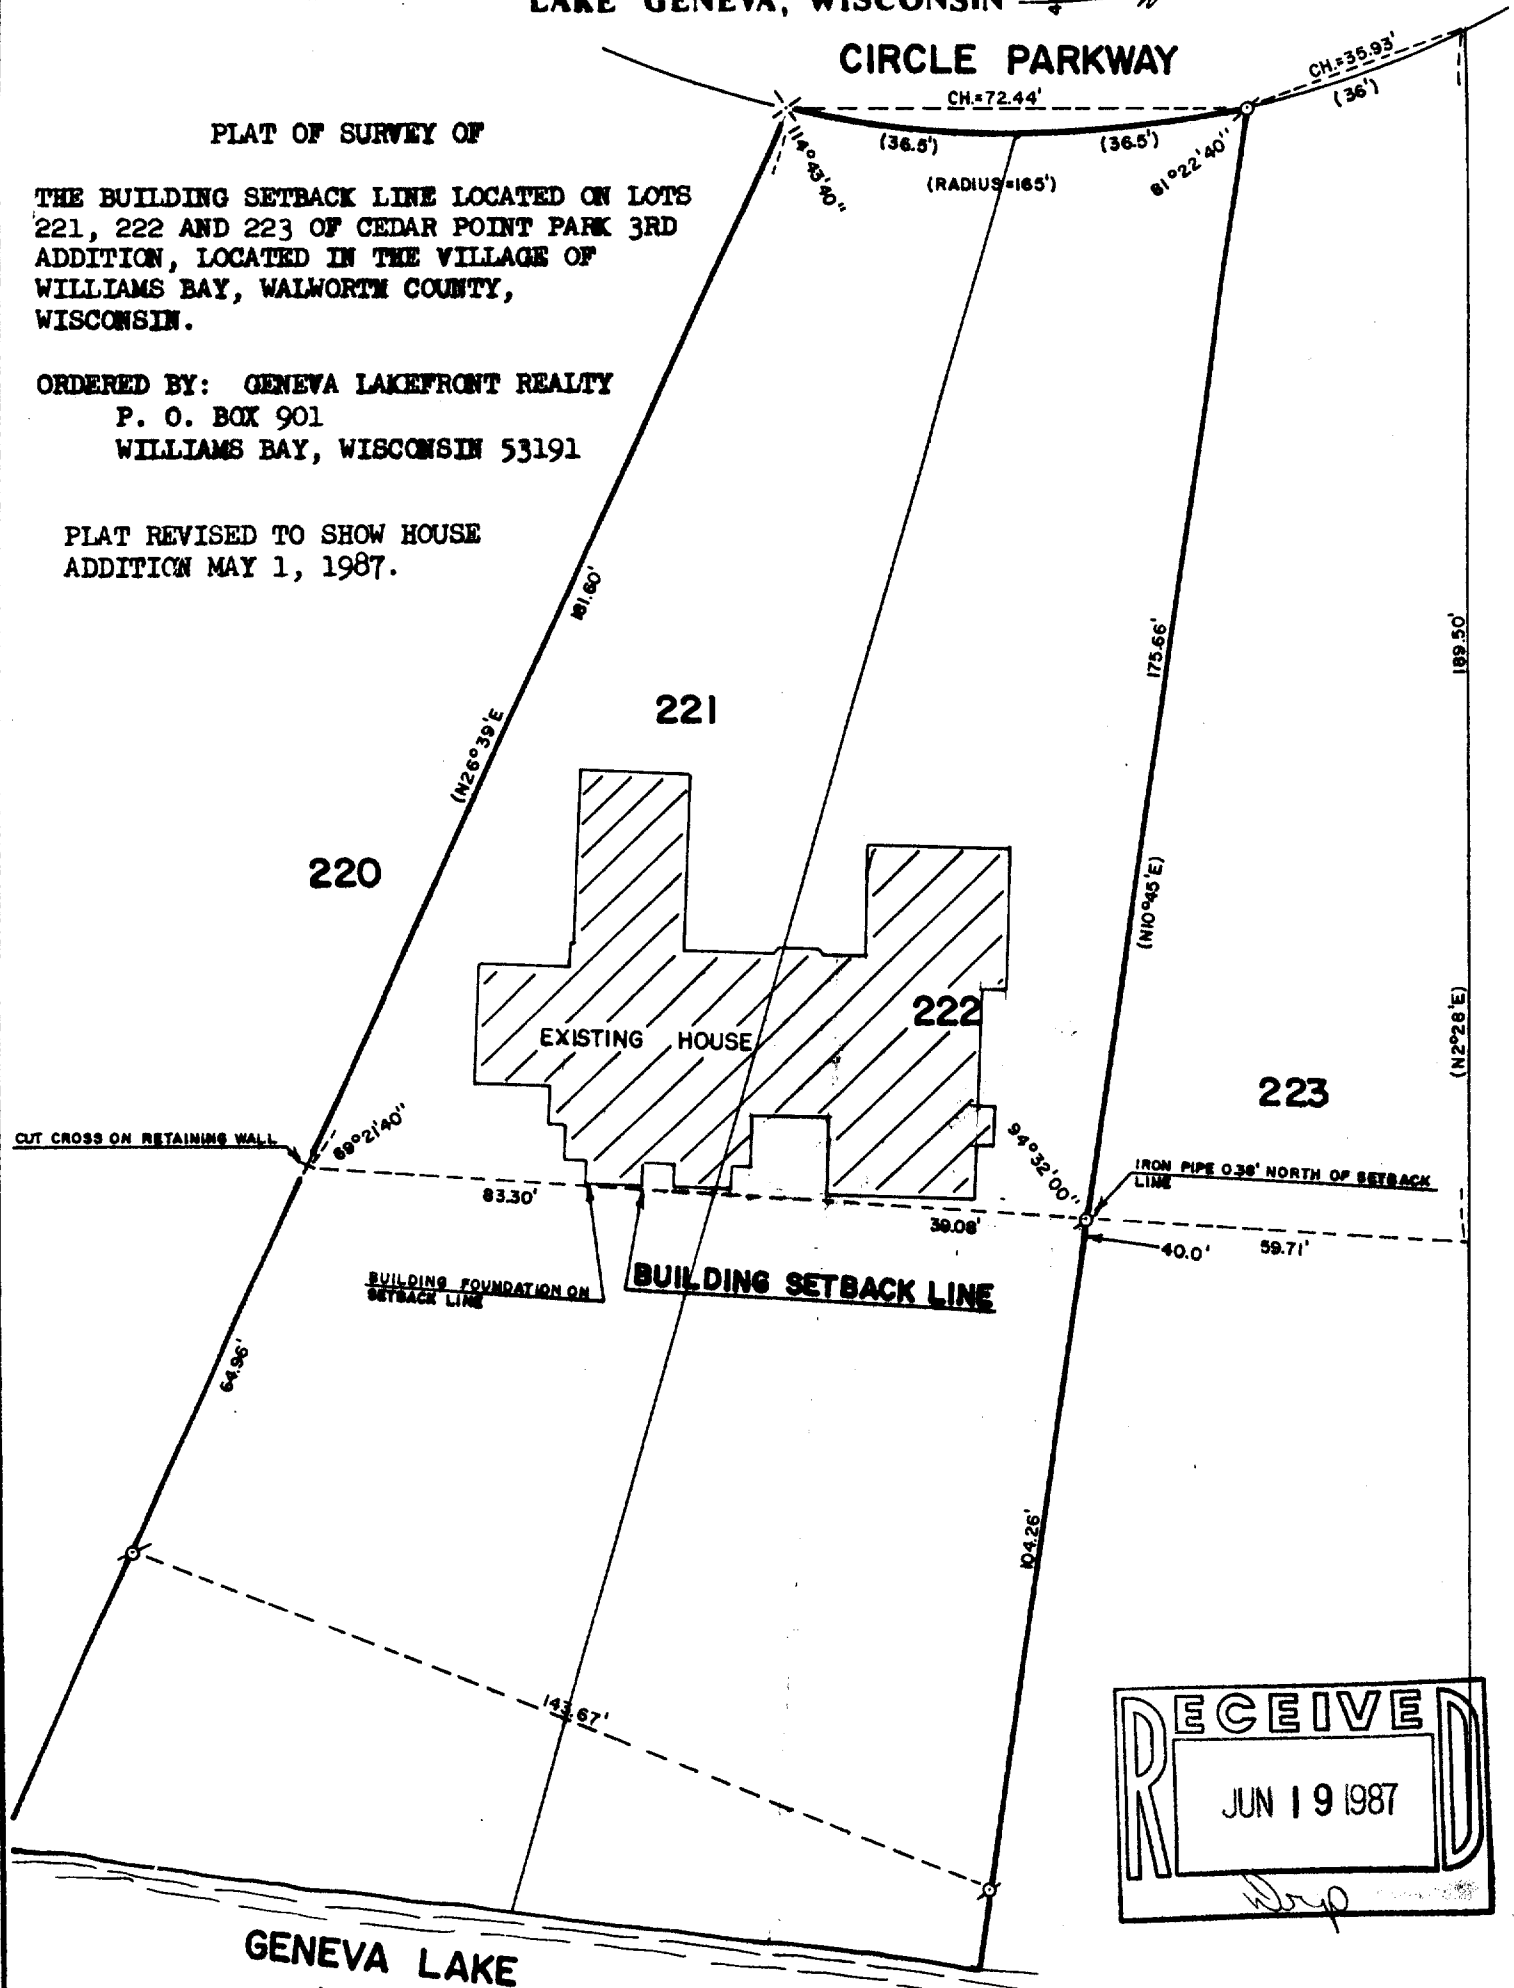

GENEVA LAKE



SCALE: 1"=30'

- o - IRON PIPE FOUND
- x - RAILROAD SPIKE FOUND
- o - IRON ROD PLACED
- ( ) - RECORDED AS

WCP3-19, 80

I, ROBERT M. BAERENWALD, DO HEREBY CERTIFY THAT I  
HAVE SURVEYED THE PROPERTY HEREON DESCRIBED ACCORDING  
TO THE OFFICIAL RECORDS AND THAT THE PLAT HEREON IS A  
CORRECT REPRESENTATION OF THE PROPERTY LINES TO THE  
BEST OF MY KNOWLEDGE AND BELIEF.

*Robert M. Baerenwald*  
ROBERT M. BAERENWALD  
WISCONSIN REGISTERED LAND SURVEYOR, S-1508

*Dec. 19, 1986*  
DATE JOB NO. 0888

NOTE: THIS IS NOT A CERTIFIED COPY UNLESS SEALED.

11-564