


**ABELL
SURVEYING & MAPPING
DELAVAN, WISCONSIN 53115
414-728-6737**

SPRING STREET

SET IRON ROD 1.50' EAST OF CORNER
ON LINE. CONCRETE AT BASE OF FENCE
POST ON CORNER.

FOUND IRON ROD 0.30'
SOUTH OF CORNER

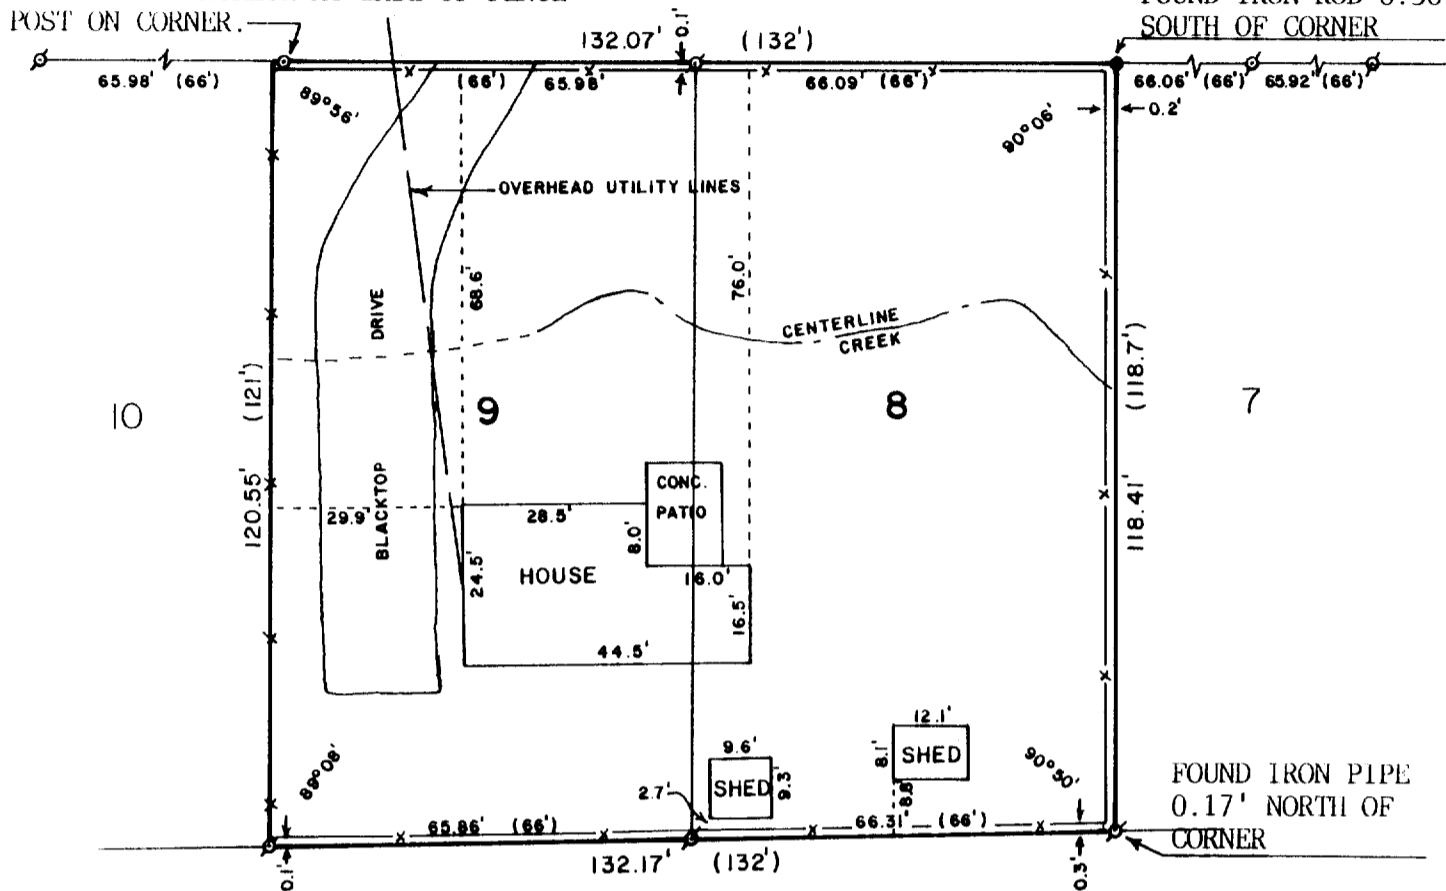


FOUND IRON PIPE
0.17' NORTH OF
CORNER

PLAT OF SURVEY OF

LOTS 8 AND 9 OF JOHNSON'S ADDITION TO THE VILLAGE
OF WILLIAMS BAY, WALWORTH COUNTY, WISCONSIN.

ORDERED BY: THE RAULAND AGENCY
118 KENOSHA ST.
WALWORTH, WI 53184

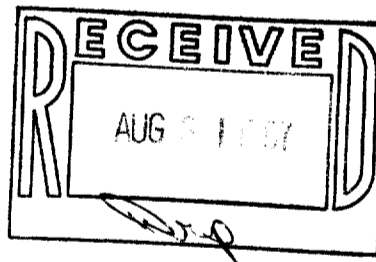

I HEREBY CERTIFY THAT I HAVE SURVEYED THE ABOVE DESCRIBED PROPERTY AND THAT THE ABOVE MAP IS A TRUE REPRESENTATION THEREOF AND SHOWS THE SIZE AND LOCATION OF THE PROPERTY, ITS EXTERIOR BOUNDARIES, THE LOCATION OF ALL VISIBLE STRUCTURES AND DIMENSIONS OF ALL PRINCIPAL BUILDINGS THEREON, BOUNDARY FENCES, APPARENT EASEMENTS, ROADWAYS AND VISIBLE ENCROACHMENTS, IF ANY, TO THE BEST OF MY KNOWLEDGE AND BELIEF.

THIS SURVEY IS MADE FOR THE USE OF THE PRESENT OWNERS OF THE PROPERTY, AND ALSO THOSE WHO PURCHASE, MORTGAGE, OR GUARANTEE THE TITLE THERETO WITHIN ONE (1) YEAR FROM DATE HEREOF.



SCALE - 1"=30'

- LEGEND**
- ⊘ - IRON PIPE FOUND
 - - IRON ROD FOUND
 - - 3/4" DIA. IRON ROD SET
 - x— - CHAINLINK FENCE
 - () - RECORDED AS

David F. Abell
DAVID F. ABELL
WISCONSIN REGISTERED LAND SURVEYOR, S-1596

August 12, 1987
DATE JOB NUMBER - 87111

NOTE: THIS IS NOT A CERTIFIED COPY UNLESS SEALED.