

WALWORTH COUNTY SURVEYING & MAPPING LAKE GENEVA, WISCONSIN

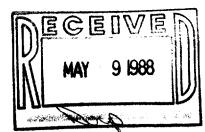

NOTE: INSERTS NOT TO SCALE

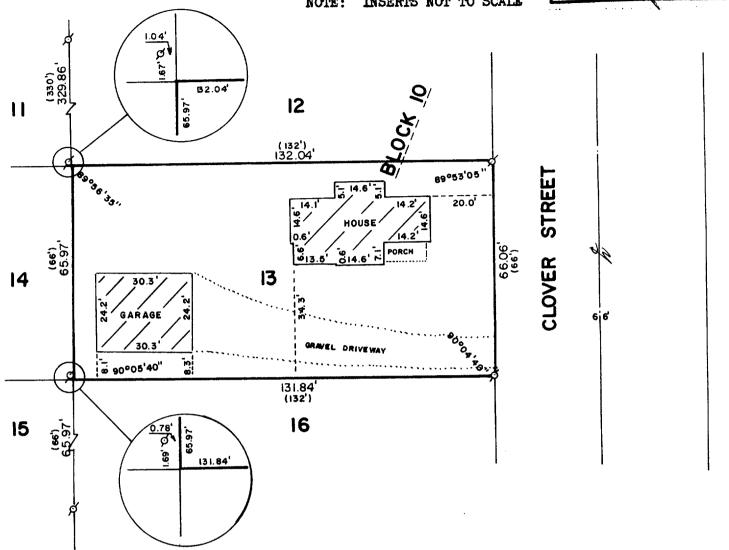

PLAT OF SURVEY OF

LOT 13, BLOCK 10 OF WILLIAM'S SECOND ADDITION TO THE VILLAGE OF WILLIAMS BAY, WALWORTH COUNTY, WISCONSIN.

ORDERED BY: ROBERT SPOTS
P. O. BOX 258

WILLIAMS BAY, WISCONSIN

53191



SCALE: 1"=30'

ø-IRON PIPE FOUND ()-RECORDED AS I, ROBERT M. BAERENWALD, DO HEREBY CERTIFY THAT I HAVE SURVEYED THE PROPERTY HEREON DESCRIBED ACCORDING TO THE OFFICIAL RECORDS AND THAT THE PLAT HEREON IS A CORRECT REPRESENTATION OF THE PROPERTY LINES TO THE BEST OF MY KNOWLEDGE AND BELIEF.

ROBERT M. BAERENWALD

WISCONSIN REGISTERED LAND SURVEYOR, S-1508

DATE JOB NO. 1403

NOTE: THIS IS NOT A CERTIFIED COPY UNLESS SEALED.

w0P-145