

WALWORTH COUNTY SURVEYING & MAPPING LAKE GENEVA, WISCONSIN

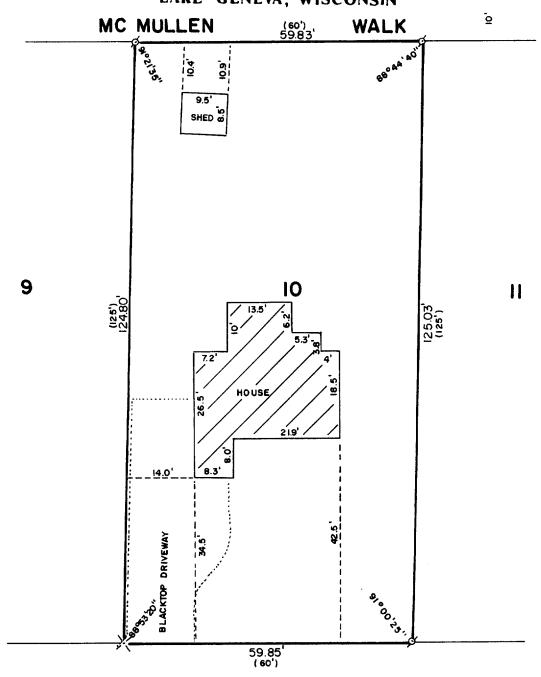

HEALY DRIVE

PLAT OF SURVEY OF

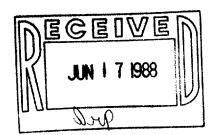

LOT 10 OF LACKEY BROTHERS SUBDIVISION, LOCATED IN THE VILLAGE OF WILLIAMS BAY, WALWORTH COUNTY, WISCONSIN.

ORDERED BY: KEEFE REAL ESTATE

704 MAIN STREET

LAKE GENEVA, WISCONSIN 53147



SCALE: 1"=20'

ø-IRON PIPE FOUND X-PK NAIL PLACED
()-RECORDED AS

I, ROBERT M. BAERENWALD, DO HEREBY CERTIFY THAT I HAVE SURVEYED THE PROPERTY HEREON DESCRIBED ACCORDING TO THE OFFICIAL RECORDS AND THAT THE PLAT HEREON IS A CORRECT REPRESENTATION OF THE PROPERTY LINES TO THE BEST OF MY KNOWLEDGE AND BELIEF.

ROBERT M. BAERENWALD
WISCONSTRU

WISCONSIN REGISTERED LAND SURVEYOR, S-1508

NOTE: THIS IS NOT A CERTIFIED COPY UNLESS SEAT

01-<u>8-10</u>