
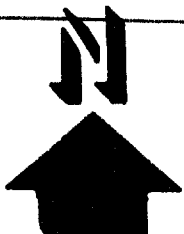


PLAT OF SURVEY OF

Situated in the Village of Williams Bay to-wit: A piece of land in the Southeast 1/4 of Section 1, T1N, R16E, Walworth County, Wisconsin, described as follows to-wit: Beginning at the Southwest corner of Lackey Brothers Subdivision as recorded in Volume 7 of Plats on Page 113 in the Office of the Register of Deeds in and for said County; thence East along the South line of said Subdivision 808.60 feet to the East line of Lincoln Drive, a private road in said Subdivision; thence South in the East line of said Drive extended, 40 feet to a point; thence East in a line parallel with the South line of said Subdivision to the West line of a public road known as Conference Point Road; thence South 12° 51' West along said West line to a point that is 187.82 feet South 12° 51' West of a point where the West line of said public road intersects the South line of Lackey Brothers Subdivision; thence Westerly 954.87 feet to the North-South 1/8 Section line in said Southeast 1/4; thence North along said 1/8 Section line 187.1 feet to the place of beginning; except the North 20 feet of the East 108.60 feet adjacent to and bordering Healy Drive, and except the West 700 feet of the above described parcel of land, as recorded in Volume 218 on Page 956 and Volume 62 on Page 710, respectively.

Tax Key No. WWUP 00076

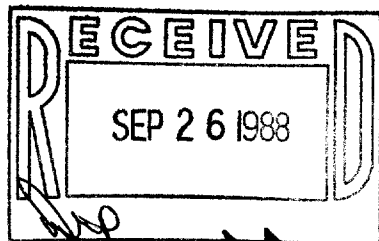

SCALE: 1"=40'

- ⊘ - IRON PIPE FOUND
- ⊘ - IRON ROD FOUND
- - IRON ROD PLACED
- ( ) - RECORDED AS

ORDERED BY: KEEFE REAL ESTATE  
704 MAIN STREET  
LAKE GENEVA, WISCONSIN 53147

I HEREBY CERTIFY THAT I HAVE SURVEYED THE ABOVE DESCRIBED PROPERTY AND THAT THE ABOVE MAP IS A TRUE REPRESENTATION THEREOF AND SHOWS THE SIZE AND LOCATION OF THE PROPERTY, ITS EXTERIOR BOUNDARIES, THE LOCATION OF ALL VISIBLE STRUCTURES AND DIMENSIONS OF ALL PRINCIPAL BUILDINGS THEREON, BOUNDARY FENCES, APPARENT EASEMENTS AND ROADWAYS AND VISIBLE ENCROACHMENTS, IF ANY.

THIS SURVEY IS MADE FOR THE EXCLUSIVE USE OF THE PRESENT OWNERS OF THE PROPERTY, AND ALSO THOSE WHO PURCHASE, MORTGAGE, OR GUARANTEE THE TITLE THERETO WITHIN ONE (1) YEAR FROM DATE HEREOF.

*Robert M. Baerenwald*  
ROBERT M. BAERENWALD  
WISCONSIN REGISTERED LAND SURVEYOR, S-1508

DATE *July 22, 1988* JOB NO. 1619

NOTE: THIS IS NOT A CERTIFIED COPY UNLESS SEALED.

11-659