
WALWORTH COUNTY SURVEYING & MAPPING LAKE GENEVA, WISCONSIN

GENEVA STREET

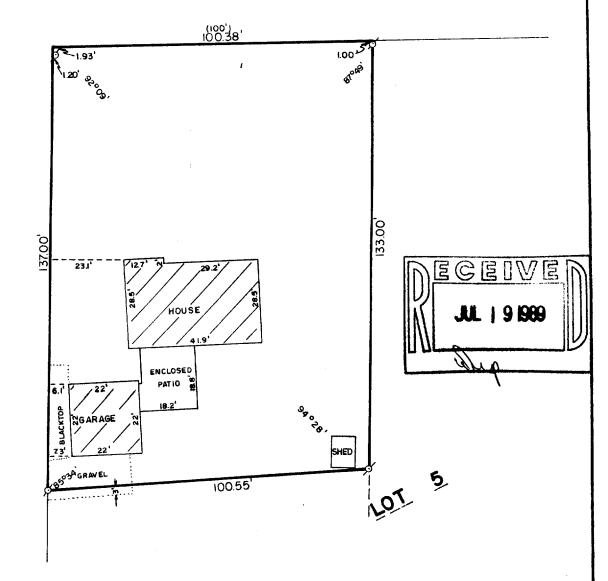

PLAT OF SURVEY OF

A PARCEL OF LAND LOCATED IN THE VILLAGE OF WILLIAMS
BAY, WALWORTH COUNTY, WISCONSIN, DESCRIBED AS FOLLOWS:
BEGINNING AT THE NORTHWEST CORNER OF PEARSON'S SUBDIVISION,
EHENCE EAST ON THE NORTH LINE OF SAID SUBDIVISION 100
FEET; THENCE SOUTH PARALLEL WITH THE WEST LINE OF SAID
SUBDIVISION 133 FEET; THENCE WESTERLY LOO FEET MOKE OR
LESS TO THE WEST LINE OF SAID SUBDIVISION; THENCE NORTH
ON TAID WEST LINE OF SEET TO THE LOTAT OF BEGINNING.

ORDERED BY: LAKESHORE REAL ESTATE

101 BROAD STREET

LAKE GENEVA, WISCONSIN 53147



DARTMOUTH STREET

SCALE: 1"=30"

Ø-IRON PIPE FOUND ()-RECORDED AS THEREBY CENTIFY THAT THAVE SURVEYED THE ABOVE DESCRIBED PROPERTY AND THAT THE ABOVE MAP IS A TRUE REPRESENTATION THEREOF AND BHOWS THE SIZE AND LOCATION OF THE PROPERTY, ITS EXTERIOR BOUNDARIES, THE LOCATION OF ALL VISIBLE STRUCTURES AND DIMENSIONS OF ALL PRINCIPAL BUILDINGS THEREON, BOUNDARY FENCES, APPARENT EASEMENTS AND HOADWAYS AND VISIBLE ENCROACHMENTS, IF ANY.

THIS SURVEY IS MADE FOR THE EXCLUSIVE USE OF THE PRESENT OWNERS OF THE PHOPERTY, AND ALSO THOSE WHO PURCHASE, MORTGAGE, OR QUARANTES THE TITLE THERE IO WITHIN ONE (1) YEAR FHUM DATE REFEOR.

ROBERT M. BAERENWALD

WISCONSIN REGISTERED LAND SURVEYOR, S-1508

DATE JOB NO. 1885

NOTE: THIS IS NOT A CERTIFIED COPY UNLESS SEALED.

2-29W