



DARTMOUTH ROAD

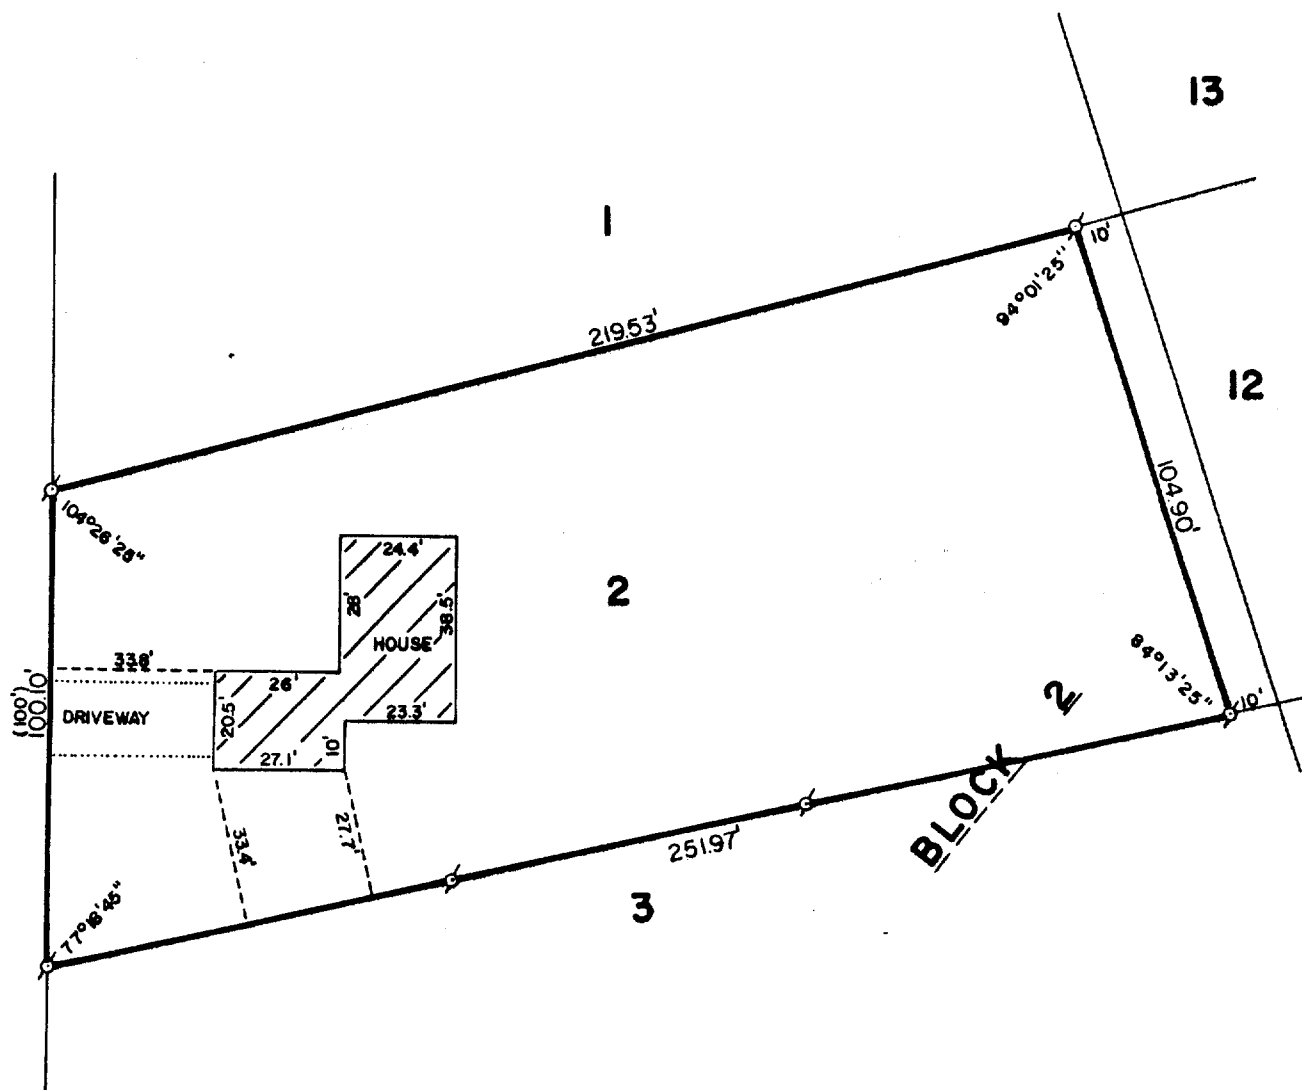

LOT 2, EXCEPT THE EAST 10 FEET, BLOCK
2 OF UNIVERSITY HEIGHTS, LOCATED IN
THE VILLAGE OF WILLIAMS BAY, WALWORTH
COUNTY, WISCONSIN.

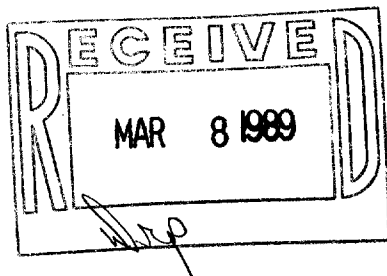

ORDERED BY: ASSURED REALTY
P. O. BOX 367
WILLIAMS BAY, WISCONSIN



♂ - IRON PIPE FOUND
() - RECORDED AS

THIS SURVEY IS MADE FOR THE EXCLUSIVE USE OF THE PRESENT OWNERS OF THE PROPERTY, AND ALSO THOSE WHO PURCHASE, MORTGAGE, OR GUARANTEE THE TITLE THERETO WITHIN ONE (1) YEAR FROM DATE HEREOF.

Robert M. Baerenwald
ROBERT M. BAERENWALD
WISCONSIN REGISTERED LAND SURVEYOR, S-1508

DATE Nov. 15, 1988 JOB NO. 1755

NOTE: THIS IS NOT A CERTIFIED COPY UNLESS SEALED.