

WALWORTH COUNTY SURVEYING & MAPPING LAKE GENEVA, WISCONSIN

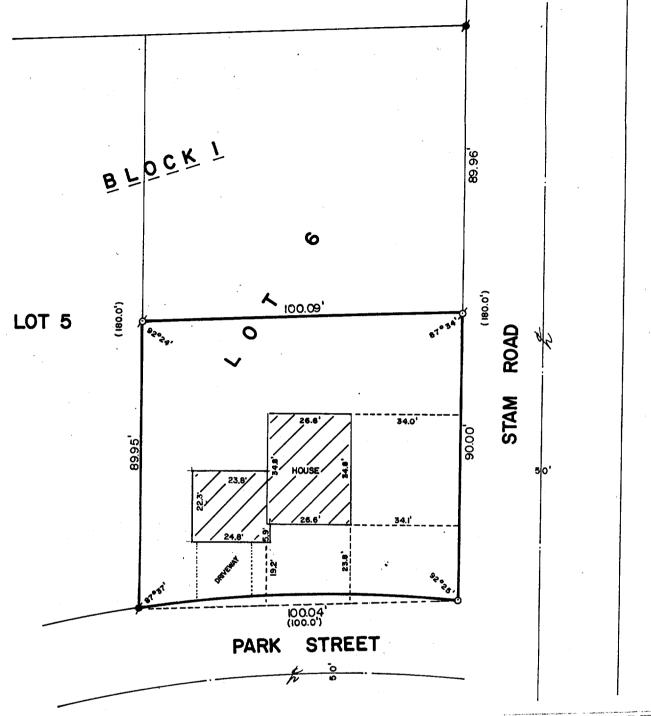

PLAT OF SURVEY OF

RECERTIFIED: SEPT. 6, 1990 FOR: ASSURED REALTY 50 WEST GENEVA STREET WILLIAMS BAY, WISCONSIN

THE SOUTH 1/2 OF LOT 6, BLOCK 1 OF UNIVERSITY HEIGHTS, A SUBDIVISION LOCATED IN THE VILLAGE OF WILLIAMS BAY, WALWORTH COUNTY, WISCONSIN.

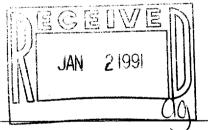



SCALE: 1"=30'

ø - IRON PIPE FOUND

☞ -CONCRETE MONUMENT FOUND

o - IRON ROD PLACED

()-RECORDED AS

I HEREBY CERTIFY THAT I HAVE SURVEYED THE ABOVE DESCRIBED PROPERTY AND THAT THE ABOVE MAP IS A TRUE REPRESENTATION THEREOF AND SHOWS THE SIZE AND LOCATION OF THE PROPERTY, ITS EXTERIOR BOUNDARIES, THE LOCATION OF ALL VISIBLE STRUCTURES AND DIMENSIONS OF ALL PRINCIPAL BUILDINGS THEREON, BOUNDARY FENCES, APPARENT EASEMENTS, ROADINAYS AND VISIBLE ENCROACHMENTS, IF ANY, TO THE BEST OF MY KNOWLEDGE AND BELIEF.

THIS SURVEY IS MADE FOR THE USE OF THE PRESENT OWNERS OF THE PROPERTY AND ALSO THOSE WHO PURCHASE, MORTGAGE OR GUARANTEE THE TITLE THERETO WITHIN ONE (1) YEAR FROM DATE HEREOF.

ROBERT M. BAERENWALD

WISCONSIN REGISTERED LAND SURVEYOR, S-1508

JOB NO. 0945 NOTE: THIS IS NOT A CERTIFIED COPY UNLESS SEALED.

Survey# 011-773