 

WALWORTH COUNTY SURVEYING & MAPPING LAKE GENEVA, WISCONSIN



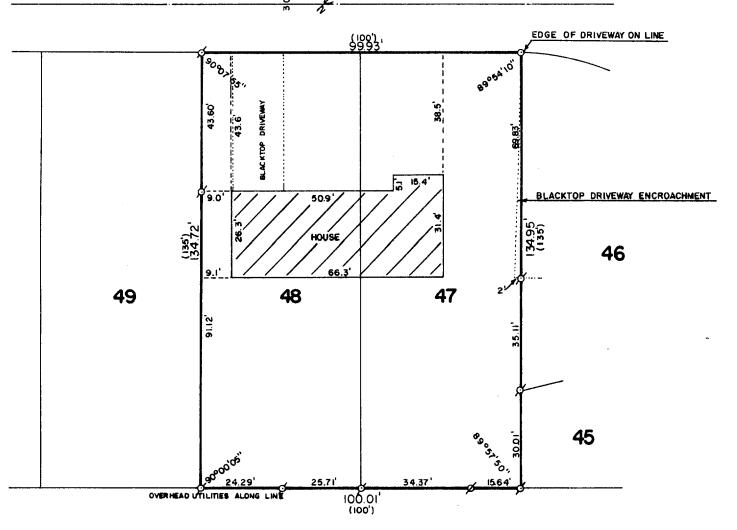


PLAT OF SURVEY OF

LOTS 47 AND 48 OF SUMMER HAVEN, A SUBDIVISION LOCATED IN THE VILLAGE OF WILLIAMS BAY, WALWORTH COUNTY, WISCONSIN.

> ORDERED BY: MIDWEST REAL ESTATE P. O. BOX 1080

WILLIAMS BAY, WISCONSIN

53191

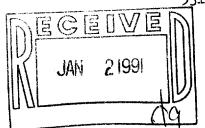

THEREBY CERTIFY THAT I HAVE SURVEYED THE ABOVE DESCRIBED PROPERTY AND THAT THE ABOVE MAP IS A TRUE REPRESENTATION THEREOF AND BHOWS THE SIZE AND LOCATION OF THE PROPERTY. ITS EXTERIOR BOUNDARIES, THE LOCATION OF ALL VISIBLE STRUCTURES AND DIMENSIONS OF ALL PRINCIPAL BUILDINGS THEREON, BOUNDARY FENCES, APPARENT EASEMENTS AND ROADWAYS AND VISIBLE ENCROACHMENTS, IF ANY.

THIS SURVEY IS MADE FOR THE EXCLUSIVE USE OF THE PRESENT OWNERS OF THE PROPERTY, AND ALSO THOSE WHO PURCHASE, MORTGAGE, OR GUARANTEE THE TITLE THERETO WITHIN ONE (1) YEAR FROM DATE HEREOF.

WISCONSIN REGISTERED LAND SURVEYOR, S-1508

DATE

JOB NO. 1744

NOTE: THIS IS NOT A CERTIFIED COPY UNLESS SEALED.

SCALE: 1"=30'

ø-IRON PIPE FOUND ø-IRON ROD FOUND

o - IRON ROD PLACED

()-RECORDED AS

Survey#011-782

TAX KEY WSU DDOY!