
## DUNHAM SURVEYING, S.C. SURVEYING & SUBDIVIDING DELAVAN, WISCONSIN 53115

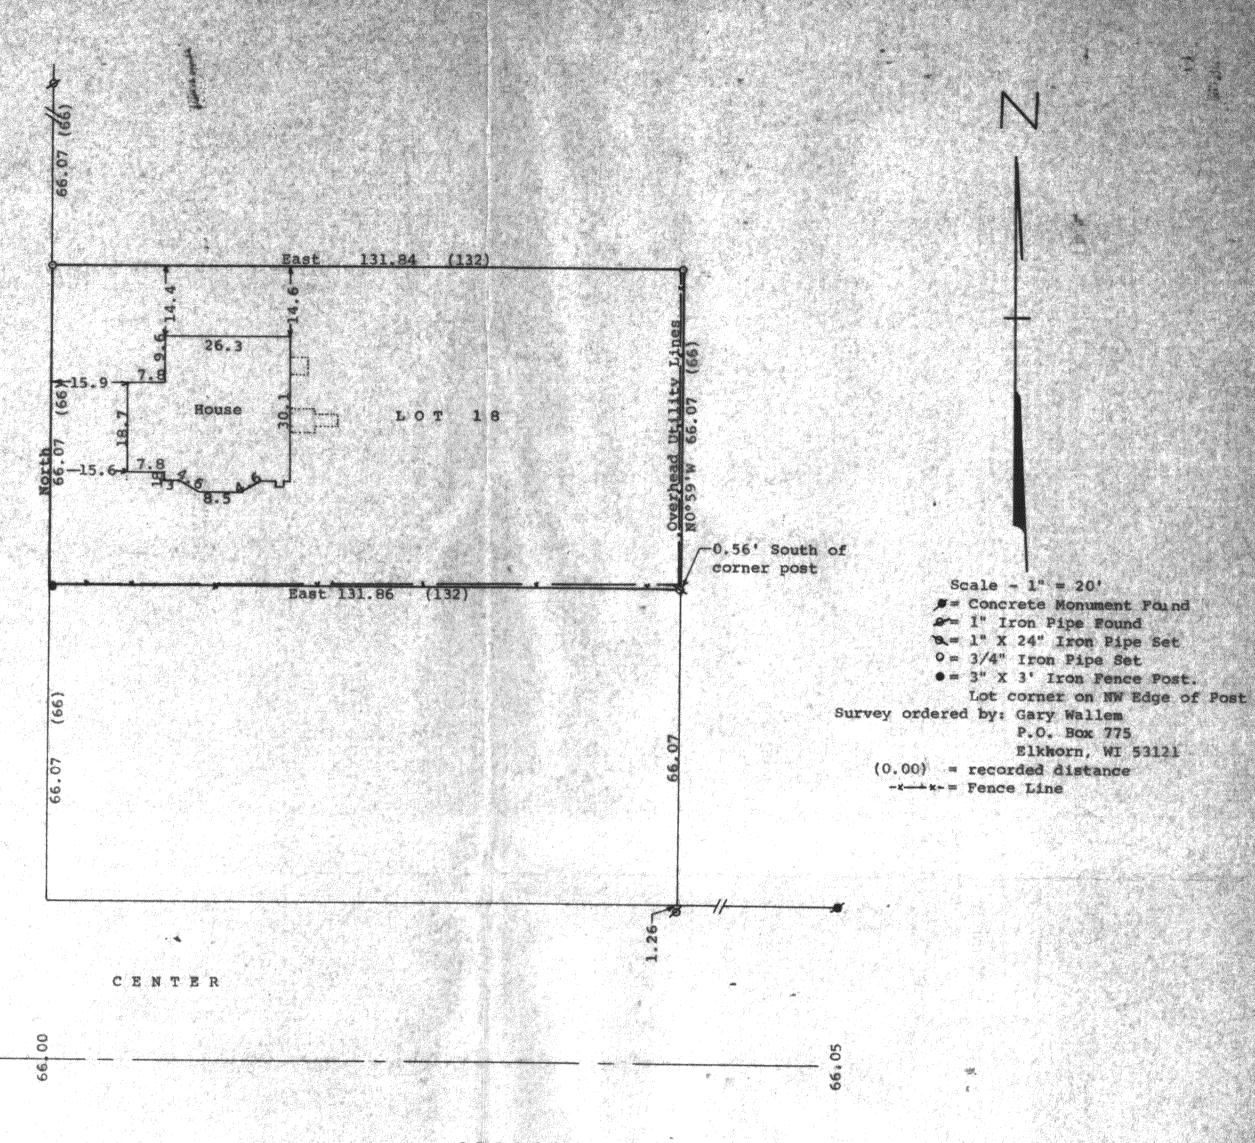

STREET

STATE OF WISCONSIN) SS COUNTY OF WALWORTH)

Œ,

I, George T. Dunham, Surveyor, Certify that I have surveyed the property described as follows:

Lot 18 in Block 13 of Williams 2nd Addition to the Village of Williams Bay, Walworth County, Wisconsin, and that the plat shown hereon is a correct representation thereof and shows

the size and location of the property, its exterior boundaries, the location of all visible structures and dimensions of all principal buildings thereon, boundary fences, apparent easements, roadways and visible encroachments, if any, and that I have surveyed the property hereon described, according to the official records, to the best of my knowledge and belief. July 15, 1991

George T. Dunham, Surveyor



