



MAP LEGEND

- IRON PIPE STAKE FOUND - 1" DIA.
- IRON PIPE STAKE FOUND - 1.5" DIA.
- IRON PIPE STAKE FOUND - 2" DIA.
- IRON PIPE STAKE FOUND - 0.75" DIA.
- CONCRETE MONUMENT FOUND - 6" DIA.
- IRON REBAR STAKE SET - 1.2" DIA X 30" X 4.3 LB/FT
- IRON REBAR STAKE SET - 0.75" DIA X 24" X 1.3 LB/FT

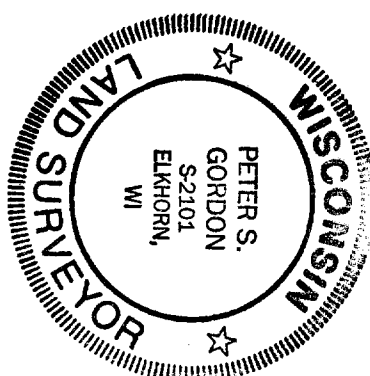

WORK ORDERED BY: _____

DATE: _____

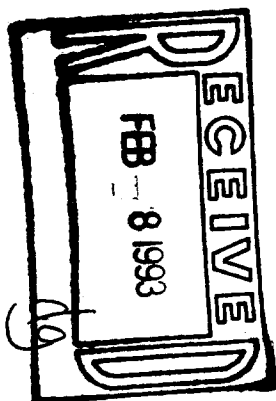

LEGAL DESCRIPTION OF LAND SURVEYED:

LOT 62 OF BAYWOOD HEIGHTS ADDITION NO. 2 IN THE VILLAGE OF WILLIAMS BAY, WALWORTH COUNTY, WISCONSIN ACCORDING TO THE PLAT THEREOF RECORDED WITH THE WALWORTH COUNTY REGISTER OF DEEDS IN CABINET B OF PLATS ON SIDE 97 AS DOCUMENT NO. 197248.

SURVEYOR'S CERTIFICATE

I HEREBY CERTIFY THAT THE PROPERTY DESCRIBED HEREON HAS BEEN SURVEYED UNDER MY DIRECTION AND THAT THIS MAP IS A TRUE REPRESENTATION THEREOF AND SHOWS THE SIZE AND LOCATION OF THE PROPERTY AND ITS EXTERIOR BOUNDARY DIMENSIONS AND ADJACENT INTERESTS. THIS SURVEY IS MADE FOR THE USE OF THE PRESENT OWNERS OF THE PROPERTY, AND ALSO THOSE WHO PURCHASE, MORTGAGE, OR GUARANTEE THE TITLE THEREOF WITHIN ONE YEAR FROM THE DATE HEREOF.

DATED THIS 2ND DAY OF OCT 1990.

REVISED 02/01/1993 TO SHOW LOCATION OF RESIDENCE

SURVEYOR *Peter S. Gordon* S-2101

REGISTRATION

NOTE: COPIES OF THIS MAP TO WHICH THE ABOVE CERTIFICATE WILL APPLY ARE BLUE LINE PRINTS SHOWING THE SURVEYOR'S ORIGINAL SEAL AND SIGNATURE IN BLACK INK. COPIES BY ANY OTHER MEANS MAY SHOW ALTERATIONS WHICH DO NOT REPRESENT THE SURVEYOR'S WORK PRODUCT.

FARRIS, HANSEN & ASSOCIATES, INC.
Engineering, Architecture, Surveying
7 Ridgway Court P.O. Box 437
ELKHORN, WISCONSIN 53121
Office: (414) 723-2098
Fax: (414) 723-5886

PLAT OF SURVEY
of
LOT 62
No. 351 FOREST DRIVE

BAYWOOD HEIGHTS
ADDITION NO. 2
Village of Williams Bay
Walworth County, Wisconsin



REVISIONS

WBW2-13

PROJECT NO.
3228

DATE

SHEET NO.
1 of 1