


**WALWORTH COUNTY  
SURVEYING & MAPPING**

727 HENRY STREET  
LAKE GENEVA, WISCONSIN  
414-248-0505

**CHERRY STREET**

**HILL STREET**

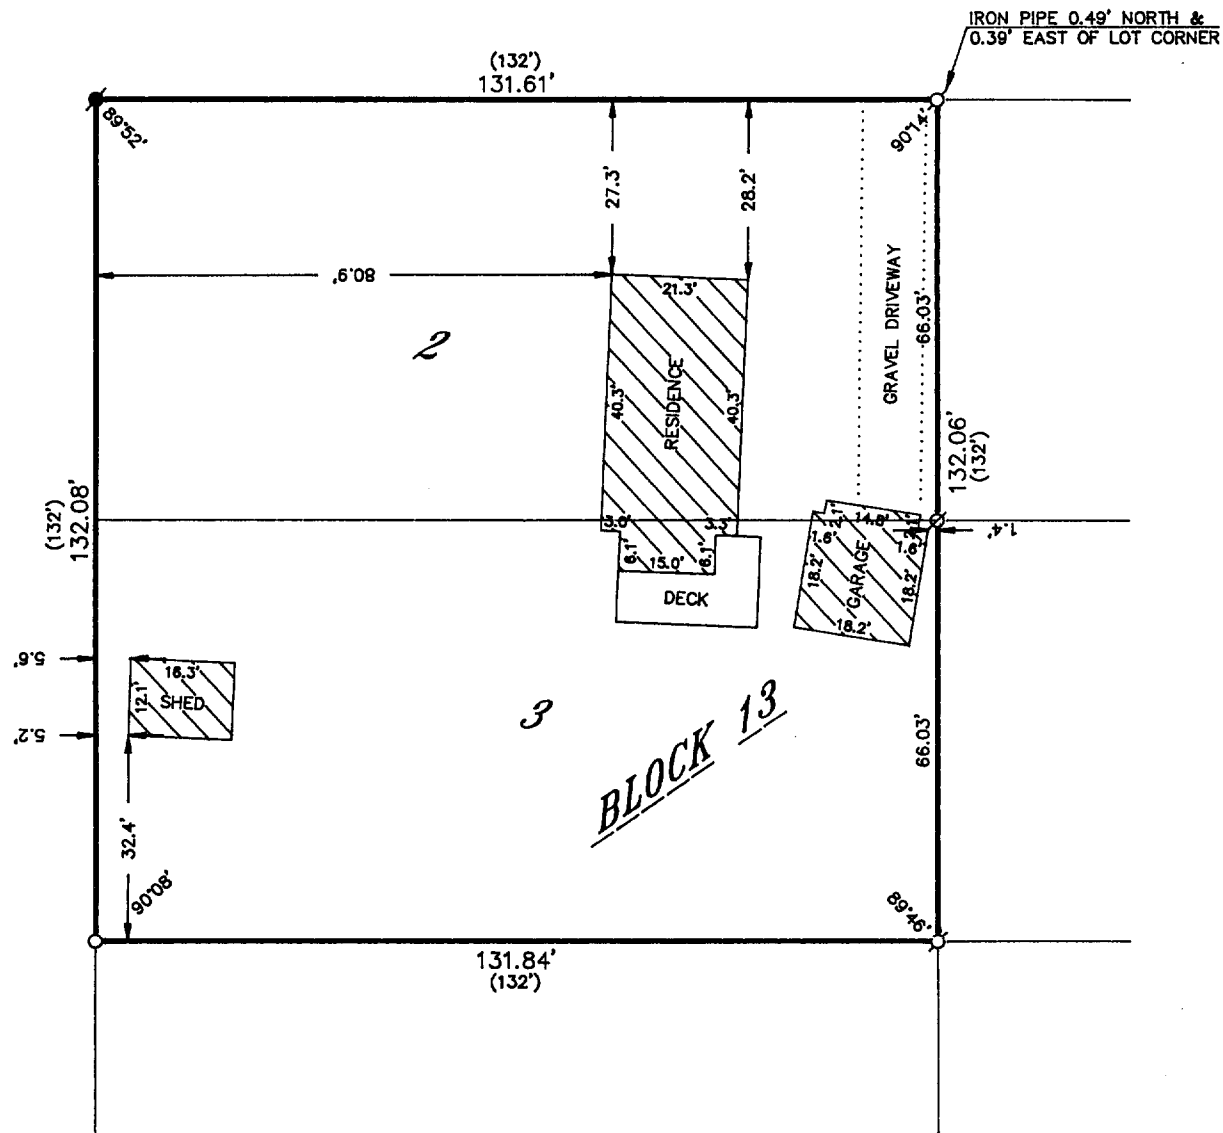

**PLAT OF SURVEY OF**

LOTS 2 AND 3, BLOCK 13 OF WILLIAMS SECOND  
ADDITION TO THE VILLAGE OF WILLIAMS BAY  
WALWORTH COUNTY, WISCONSIN.

ORDERED BY: 1ST BANK SOUTHEAST  
303 CENTER STREET  
LAKE GENEVA, WISCONSIN  
53147



I HEREBY CERTIFY THAT I HAVE SURVEYED THE ABOVE DESCRIBED  
PROPERTY AND THAT THE ABOVE MAP IS A TRUE REPRESENTATION  
THEREOF AND SHOWS THE SIZE AND LOCATION OF THE PROPERTY,  
ITS EXTERIOR BOUNDARIES, THE LOCATION OF ALL VISIBLE STRUCTURES  
AND DIMENSIONS OF ALL PRINCIPAL BUILDINGS THEREON, BOUNDARY  
FENCES, APPARENT EASEMENTS, ROADWAYS AND VISIBLE ENCROACH-  
MENTS, IF ANY, TO THE BEST OF MY KNOWLEDGE AND BELIEF.

THIS SURVEY IS MADE FOR THE USE OF THE PRESENT OWNERS OF  
THE PROPERTY AND ALSO THOSE WHO PURCHASE, MORTGAGE OR  
GUARANTEE THE TITLE THERETO WITHIN ONE (1) YEAR FROM DATE  
HEREOF.

*Robert M. Baerenwald*  
ROBERT M. BAERENWALD  
WISCONSIN REGISTERED LAND SURVEYOR, S-1508

DATE *Jan. 4, 1992* JOB NO. 3681

NOTE: THIS IS NOT A CERTIFIED COPY UNLESS SEALED.

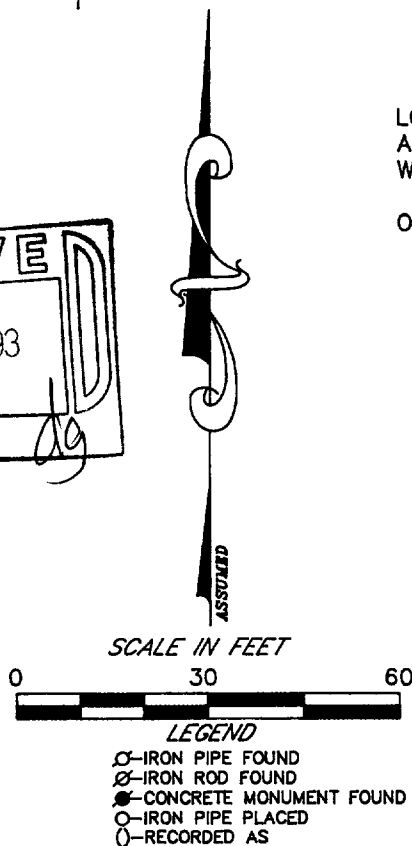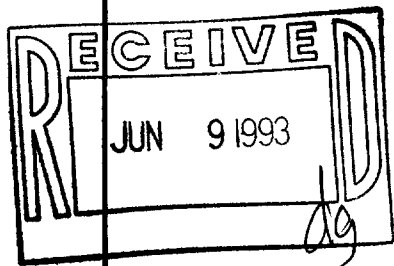

WOP-188

011-993