


NORTH

o Iron stakes

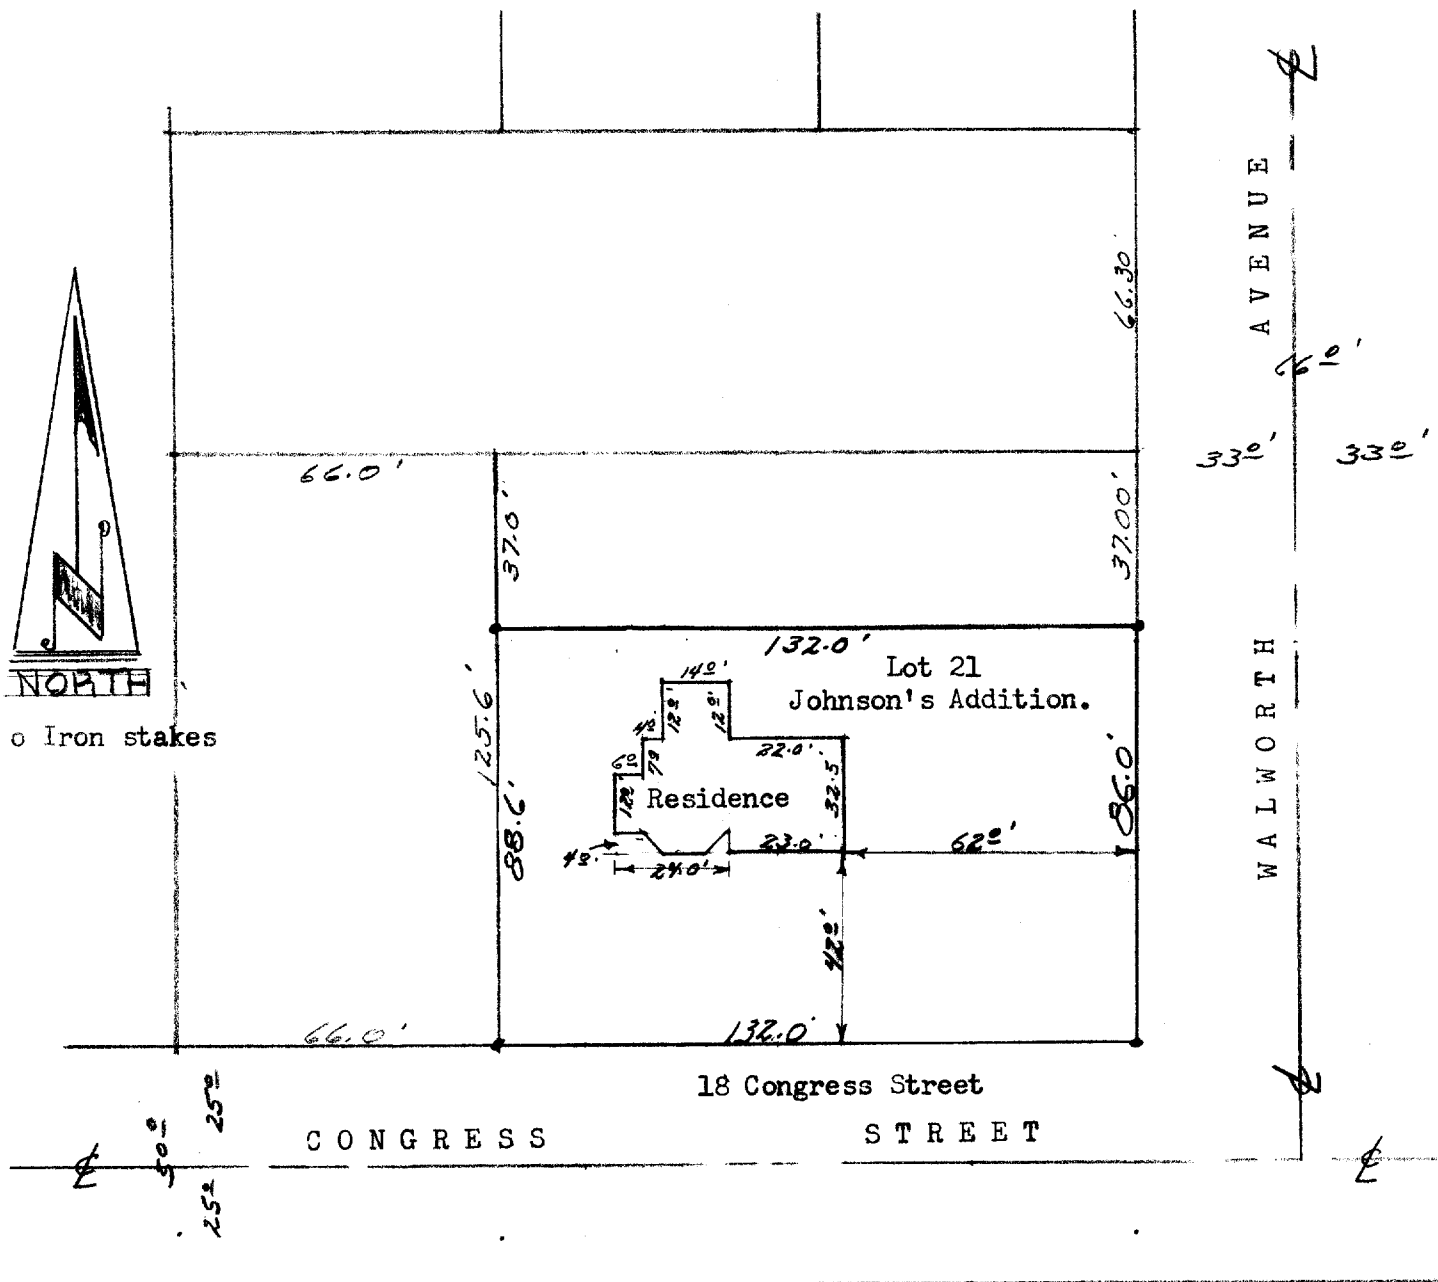


DESCRIPTION: Lot 21 (except the North 37 feet ) in Johnson's Addition to the Village of Williams Bay, Walworth County, Wisconsin.

CERTIFICATE:

I, James F. Biagi, Surveyor, do hereby certify that I have surveyed the property hereon described and that the location of the improvements are as shown.

Dated : July 9th 1965.

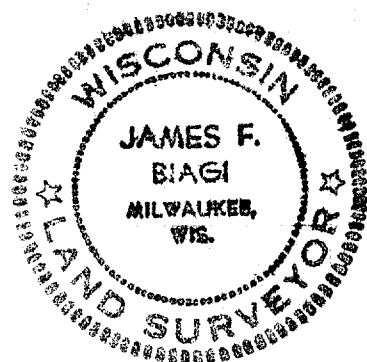

James F. Biagi, RLS 272  
Elkhorn, Wisconsin.