

Jensen Surveying & Mapping S.C.
45 S. Wisconsin St. P.O. Box 322
Elkhorn, Wisconsin. 53121
(414) 723-3434

PLAT OF SURVEY of


Lot 1 of Certified Survey Map No. 1385 located in the SE $\frac{1}{4}$ of the SW $\frac{1}{4}$ of Section 20, T 1 N, R 15 E, Walworth County, Wisconsin

ORDERED BY: Gareth Cole
Vacation Properties Network
101 Broad St.
Lake Geneva, WI 53147
(414) 248-8689

LEGEND

Mapping Date: April 11, 1990


- Found iron pipe
- Set iron pipe, 1"x24"
- *—*— Electric fence
- Concrete monument

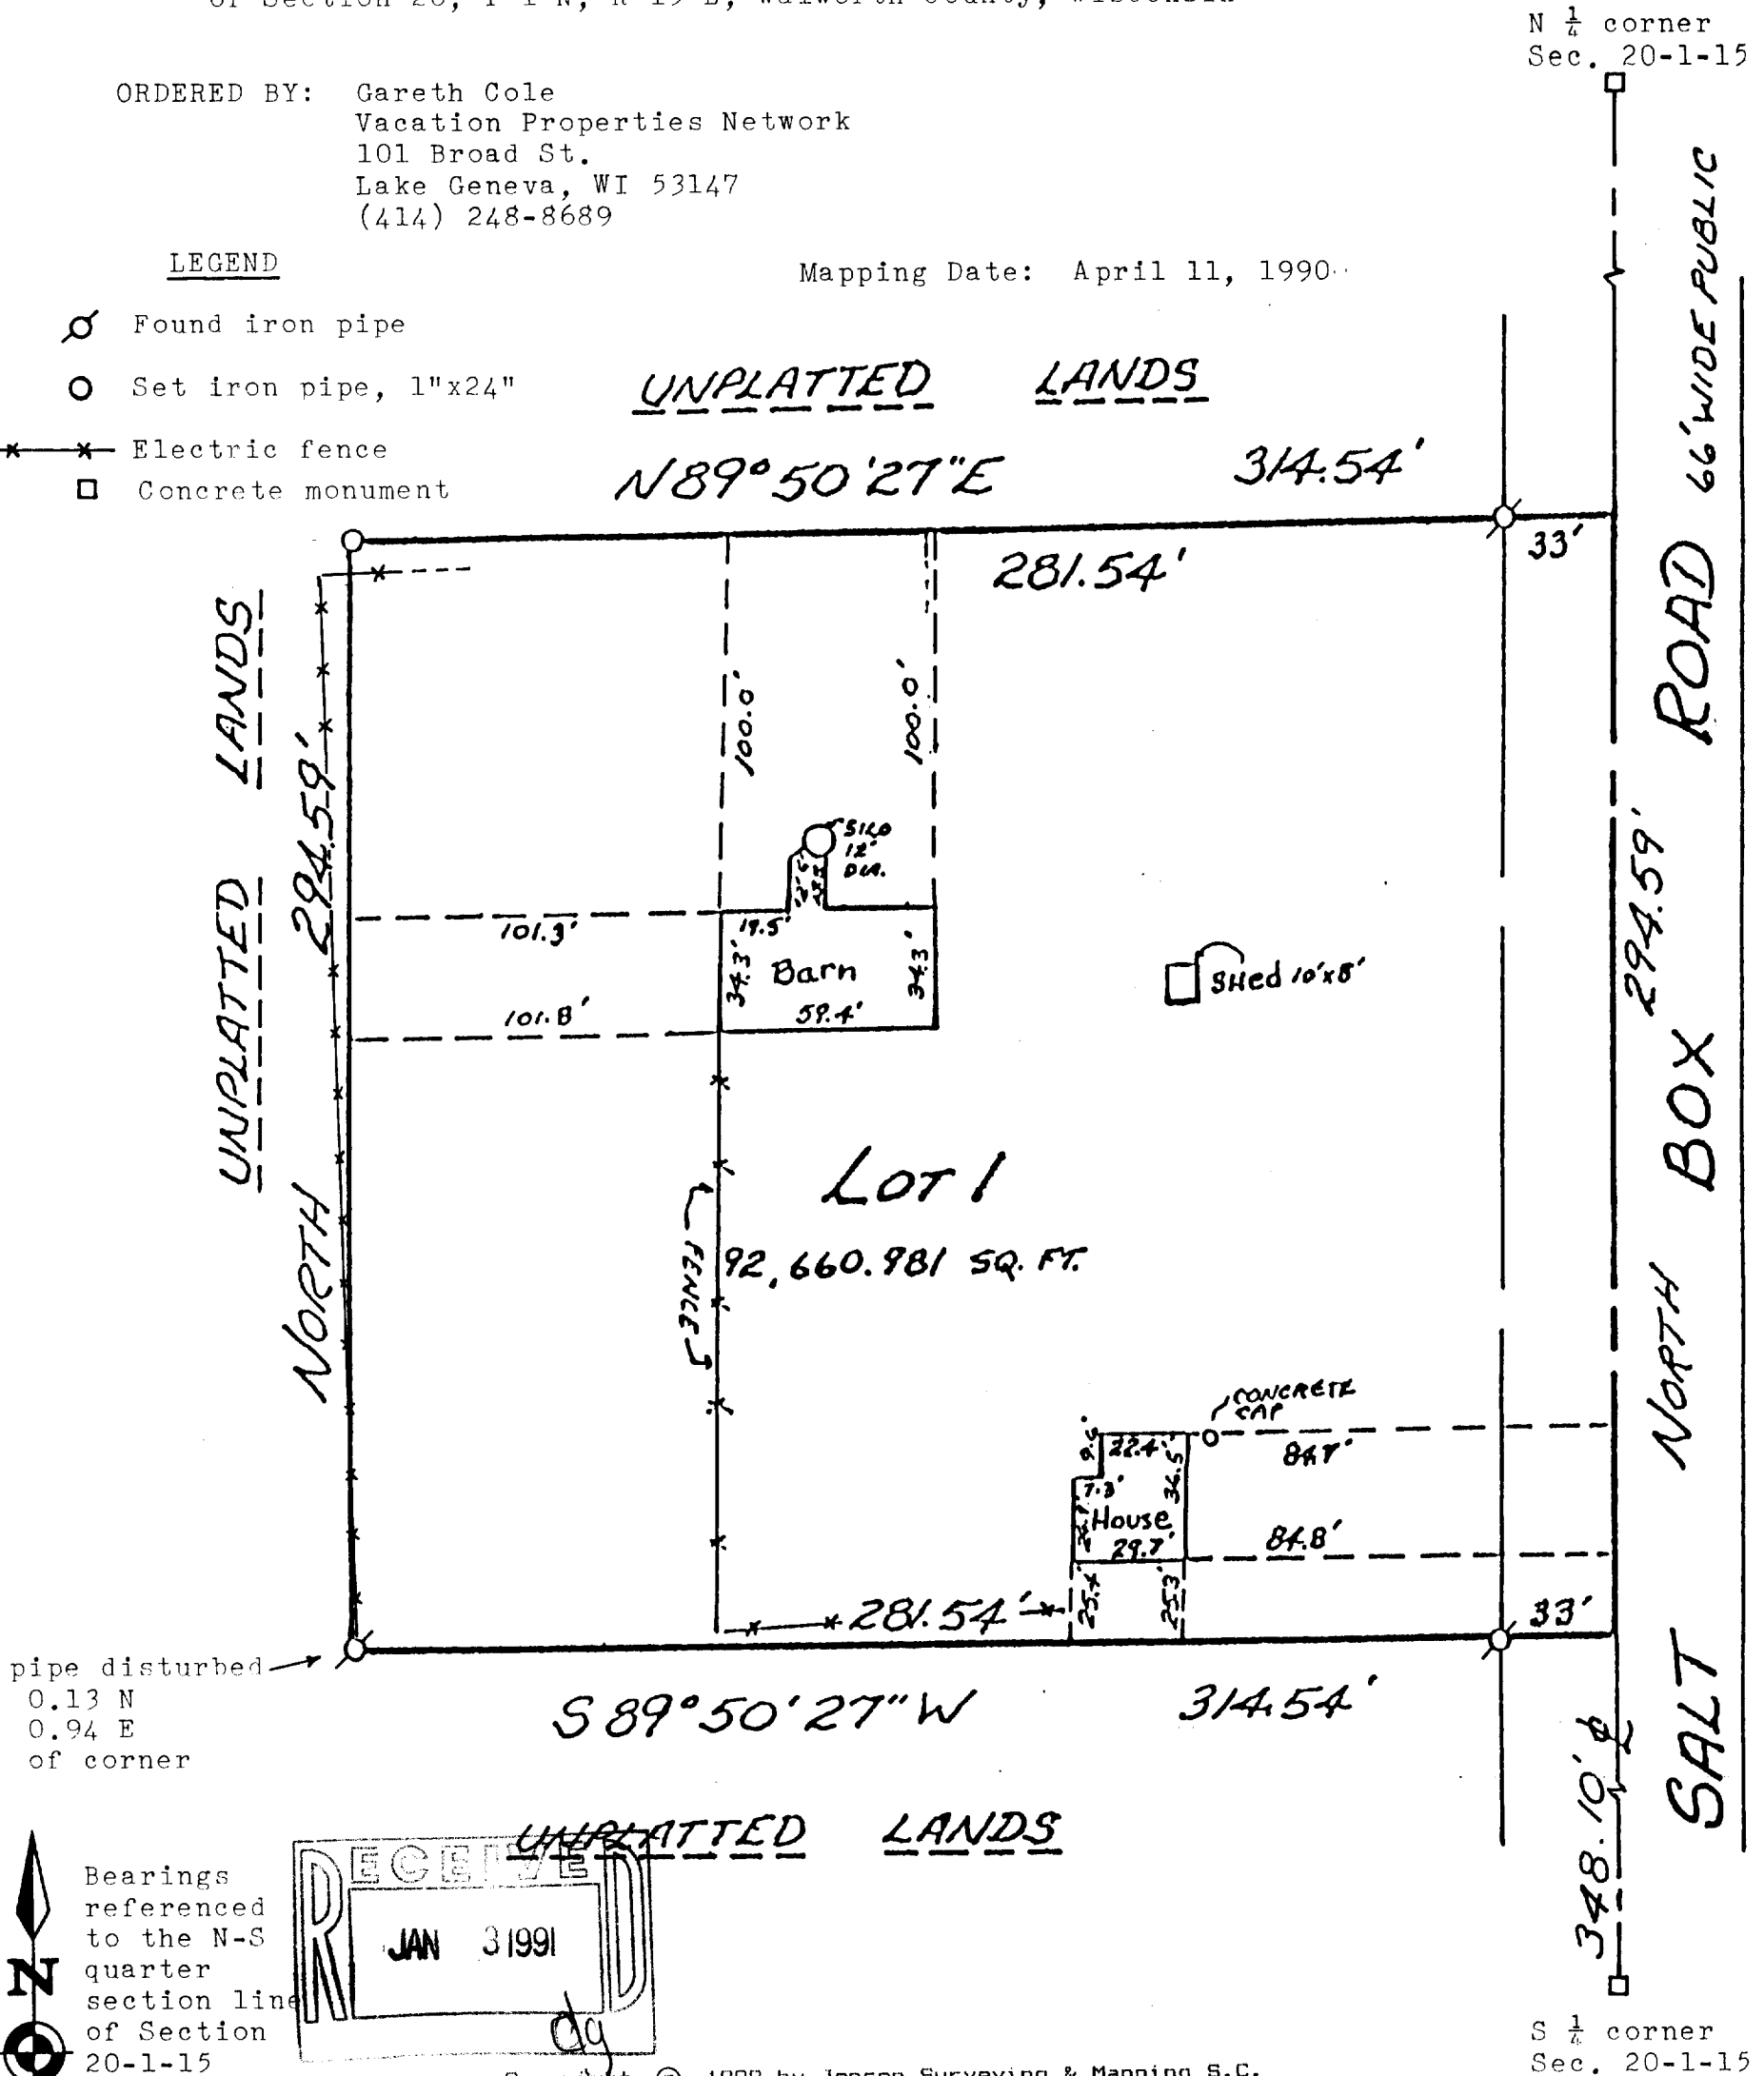

pipe disturbed
0.13 N
0.94 E
of corner



Bearings
referenced
to the N-S
quarter
section line
of Section
20-1-15
assumed as
NORTH

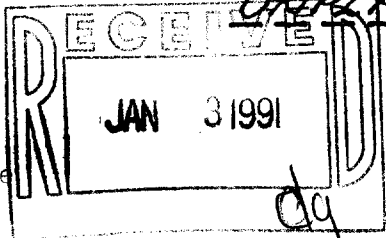


Copyright © 1989 by Jensen Surveying & Mapping S.C.

All rights reserved. No part of this survey plat may be reproduced or transmitted in any form by any means - graphic, electronic, or mechanical, including photocopying, tracing, or information storage and retrieval systems - without permission in writing from Thomas P.A. Jensen, Jensen Surveying & Mapping S.C.

I, Thomas P.A. Jensen, Wisconsin Registered Land Surveyor, do hereby certify that this survey was performed by me, or under my direction, in full compliance with the owner's agent's instructions and Chapter A-E 7 of the Wisconsin Administrative Code "Minimum Standards For Property Surveys"; and that this map is an accurate representation thereof to the best of my knowledge and belief.

Thomas P.A. Jensen R.L.S-1084
Jensen Surveying & Mapping S.C.

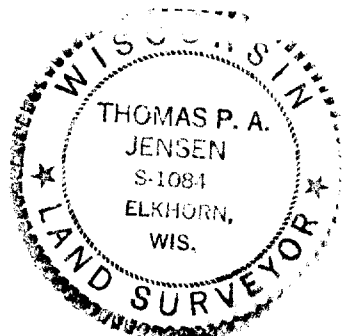

Scale: 1" = 50'

Note: This survey plat is not certified unless signed and sealed in red ink.

S $\frac{1}{4}$ corner
Sec. 20-1-15

1990.035 X

AA 1385 06001