


PLAT OF SURVEY

LOT 1 OF CERTIFIED SURVEY MAP NO. 1102
LOCATED IN THE NE 8 NW 1/4S OF THE NE 1/4.
SEC. 34, T.1N., R.15 E.,
WALWORTH COUNTY, WISCONSIN

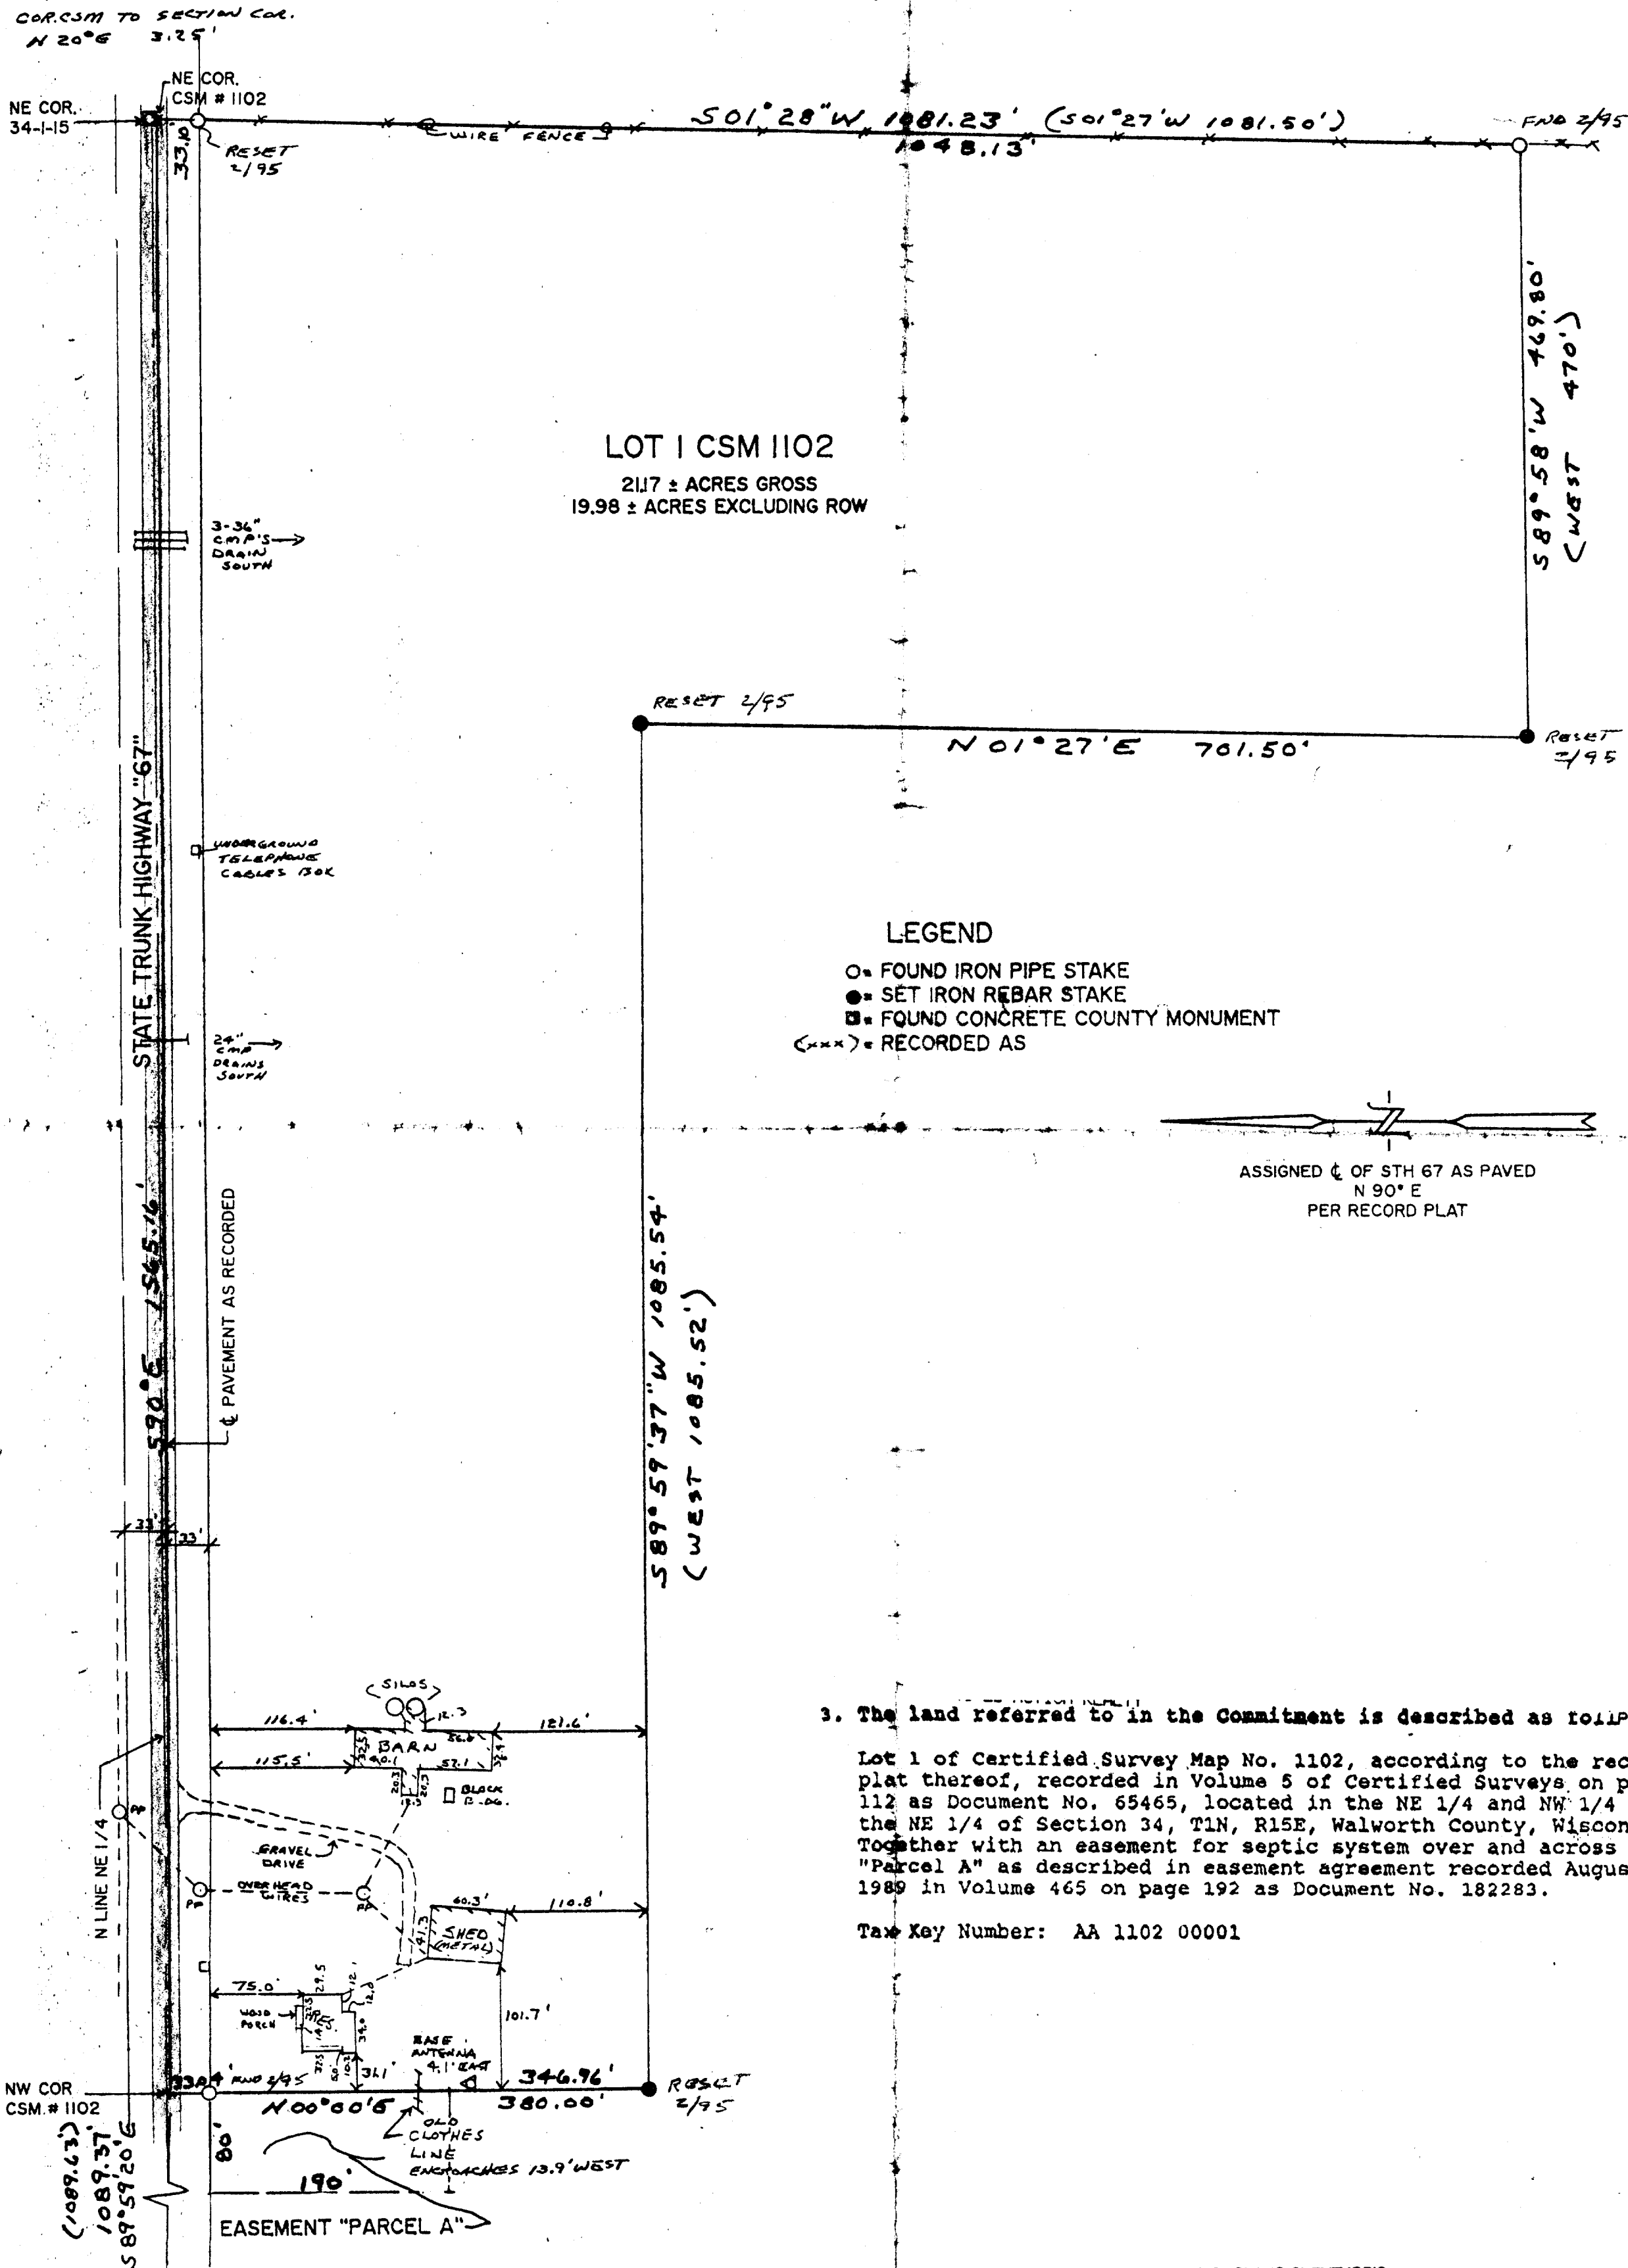

PLAT OF SURVEY
LOT 1 OF CSM # 1102
LOCATED IN THE NE 8 NW 1/4S OF THE NE 1/4
SEC. 34, T.1N., R.15 E.,
WALWORTH COUNTY, WISCONSIN

WORK ORDERED BY: ACTION REALTY
FOR KAREN ARLEN
W. 8203 RT 67
SHARON, WI

FARRIS, HANSEN & ASSOCIATES, INC.
Engineering, Architecture, Surveying
7 Ridgway Court P.O. Box 437
ELKHORN, WISCONSIN 53121
Office: (414) 723-2098
Fax: (414) 723-5886

REVISIONS
2/23/95
RESURVEY

PROJECT NO
1758.93
DATE
06/25/93
SHEET NO.
1 OF 1