

Wisconsin Registered Land Surveyor S-1594


Rt. 3, Box 273
Elkhorn, Wisconsin 53121
Phone: (414) 723-4260 (office)
(414) 723-7209 (FAX)

PLAT OF SURVEY

LOT 1 OF CERTIFIED SURVEY MAP NO. 3336 AS RECORDED
IN VOL. 19 OF CERTIFIED SURVEY MAPS AS PAGES 59
AND 60 AS DOCUMENT NO. 0476984, LOCATED IN THE
NORTHEAST 1/4 AND THE SOUTHEAST 1/4 OF THE
NORTHWEST 1/4 OF SECTION 3, TOWNSHIP 1 NORTH,
RANGE 15 EAST, SHARON TOWNSHIP, WALWORTH COUNTY,
WISCONSIN.

ORDERED BY: SCHAUDER BUILDING, INC.
4115 HIGHWAY 51 NORTH
JANESVILLE, WISCONSIN
53545-9674


CLIENT REFERENCE: CIANCIO

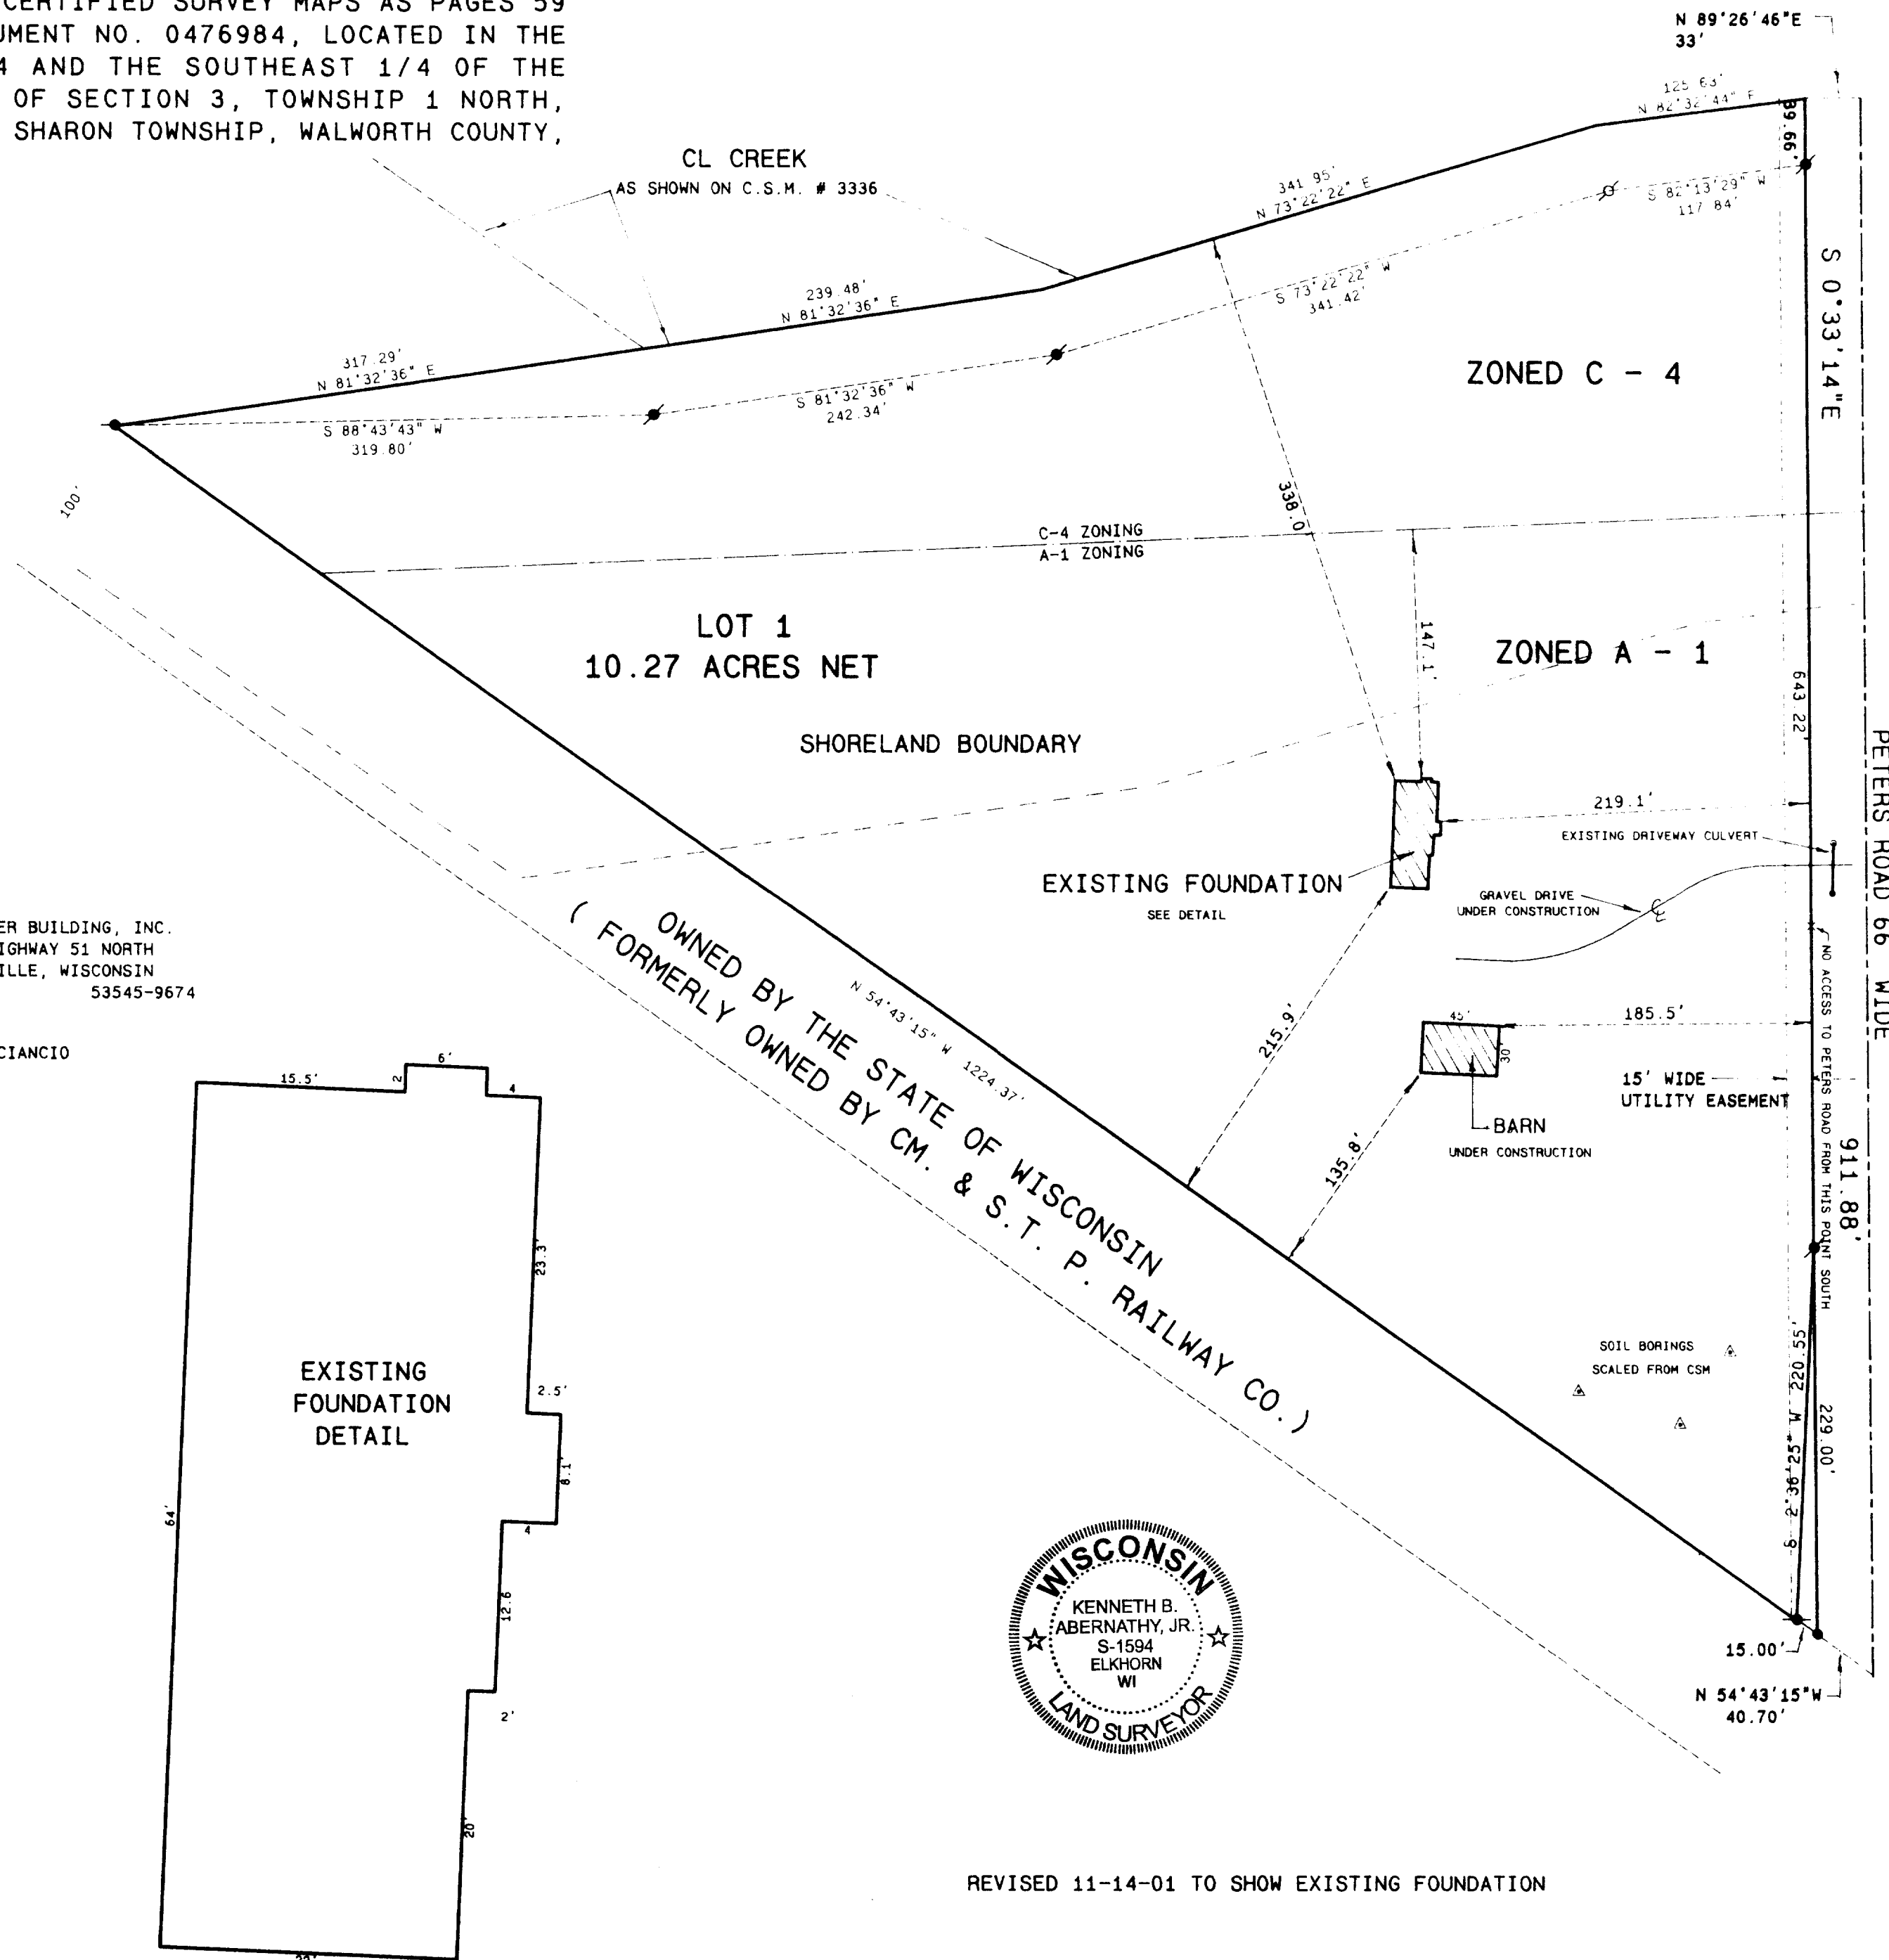

SCALE 1" = 80 FEET

Legend

- FOUND IRON PIPE
- FOUND IRON ROD
- FOUND BRASS (CAPRIE) MONUMENT
- ✕ FOUND CONCRETE MONUMENT
- CHISEL CUT IN CONCRETE
- FOUND IRON ROD 1/2" LONG WEIGHING 75 LBS. LINEAL FT. 1/4" DIA.
- FOUND IRON ROD 1/2" LONG WEIGHING 45 LBS. LINEAL FT. 1/4" DIA.
- ✕ RECORDED DIMENSION
- EXISTING FENCE

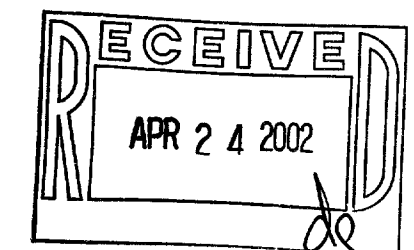

SCALE - 1" = 80 FEET

[illegible]

Kenneth B. Abernathy, Jr.
KENNETH B. ABERNATHY, JR.,
WISCONSIN REGISTERED LAND SURVEYOR,
S-1594
Date: SEPT. 5 2001 Job No. 01-808

REVISED 11-14-01 TO SHOW EXISTING FOUNDATION

115-265
AA-3336-11