

1140 SEQUOIA STREET • DELAVAN, WISCONSIN 53115
262-728-6737

NOTE: BEARINGS ARE REFERENCED TO THE
WISCONSIN COORDINATE SYSTEM -
SOUTH ZONE.



SCALE 1" = 60'

LEGEND

- ♂ -IRON PIPE FOUND
 ■ -CONCRETE MONUMENT FOUND
 ○ -1" DIA. IRON PIPE SET
 --- -WIRE FENCE
 --- -WOOD BOARD FENCE
 △ -UTILITY POLE
 ———— -OVERHEAD UTILITY LINES
 □ □ -UTILITY PEDS.
 —→ -GUY WIRE
 ▲ -LIGHT POLE
 () -RECORDED AS

PLAT OF SURVEY OF

THE EAST 27 RODS OF THE NORTH 30 RODS OF THE
WEST 1/2 OF THE NORTHEAST 1/4 OF THE NORTHWEST 1/4
OF SECTION 6, T1N, R15E, WALWORTH COUNTY, WISCONSIN.

I HEREBY CERTIFY THAT I HAVE SURVEYED THE ABOVE DESCRIBED PROPERTY AND THAT THE ABOVE MAP IS A TRUE REPRESENTATION THEREOF AND SHOWS THE SIZE AND LOCATION OF THE PROPERTY, ITS EXTERIOR BOUNDARIES, THE LOCATION OF ALL VISIBLE STRUCTURES AND DIMENSIONS OF ALL PRINCIPAL BUILDINGS THEREON, BOUNDARY FENCES, APPARENT EASEMENTS, ROADWAYS AND VISIBLE ENCROACHMENTS, IF ANY, TO THE BEST OF MY KNOWLEDGE AND BELIEF.


THIS SURVEY IS MADE FOR THE USE OF THE PRESENT OWNERS OF THE PROPERTY, AND ALSO THOSE WHO PURCHASE, MORTGAGE, OR GUARANTEE THE TITLE THERETO WITHIN ONE (1) YEAR FROM DATE HEREON.

DAVID F. ABELL
WISCONSIN REGISTERED LAND SURVEYOR, S-1596

April 5, 2004

DATE _____ JOB NUMBER - 04028
NOTE: THIS IS NOT A CERTIFIED COPY UNLESS SEALED.

115-298

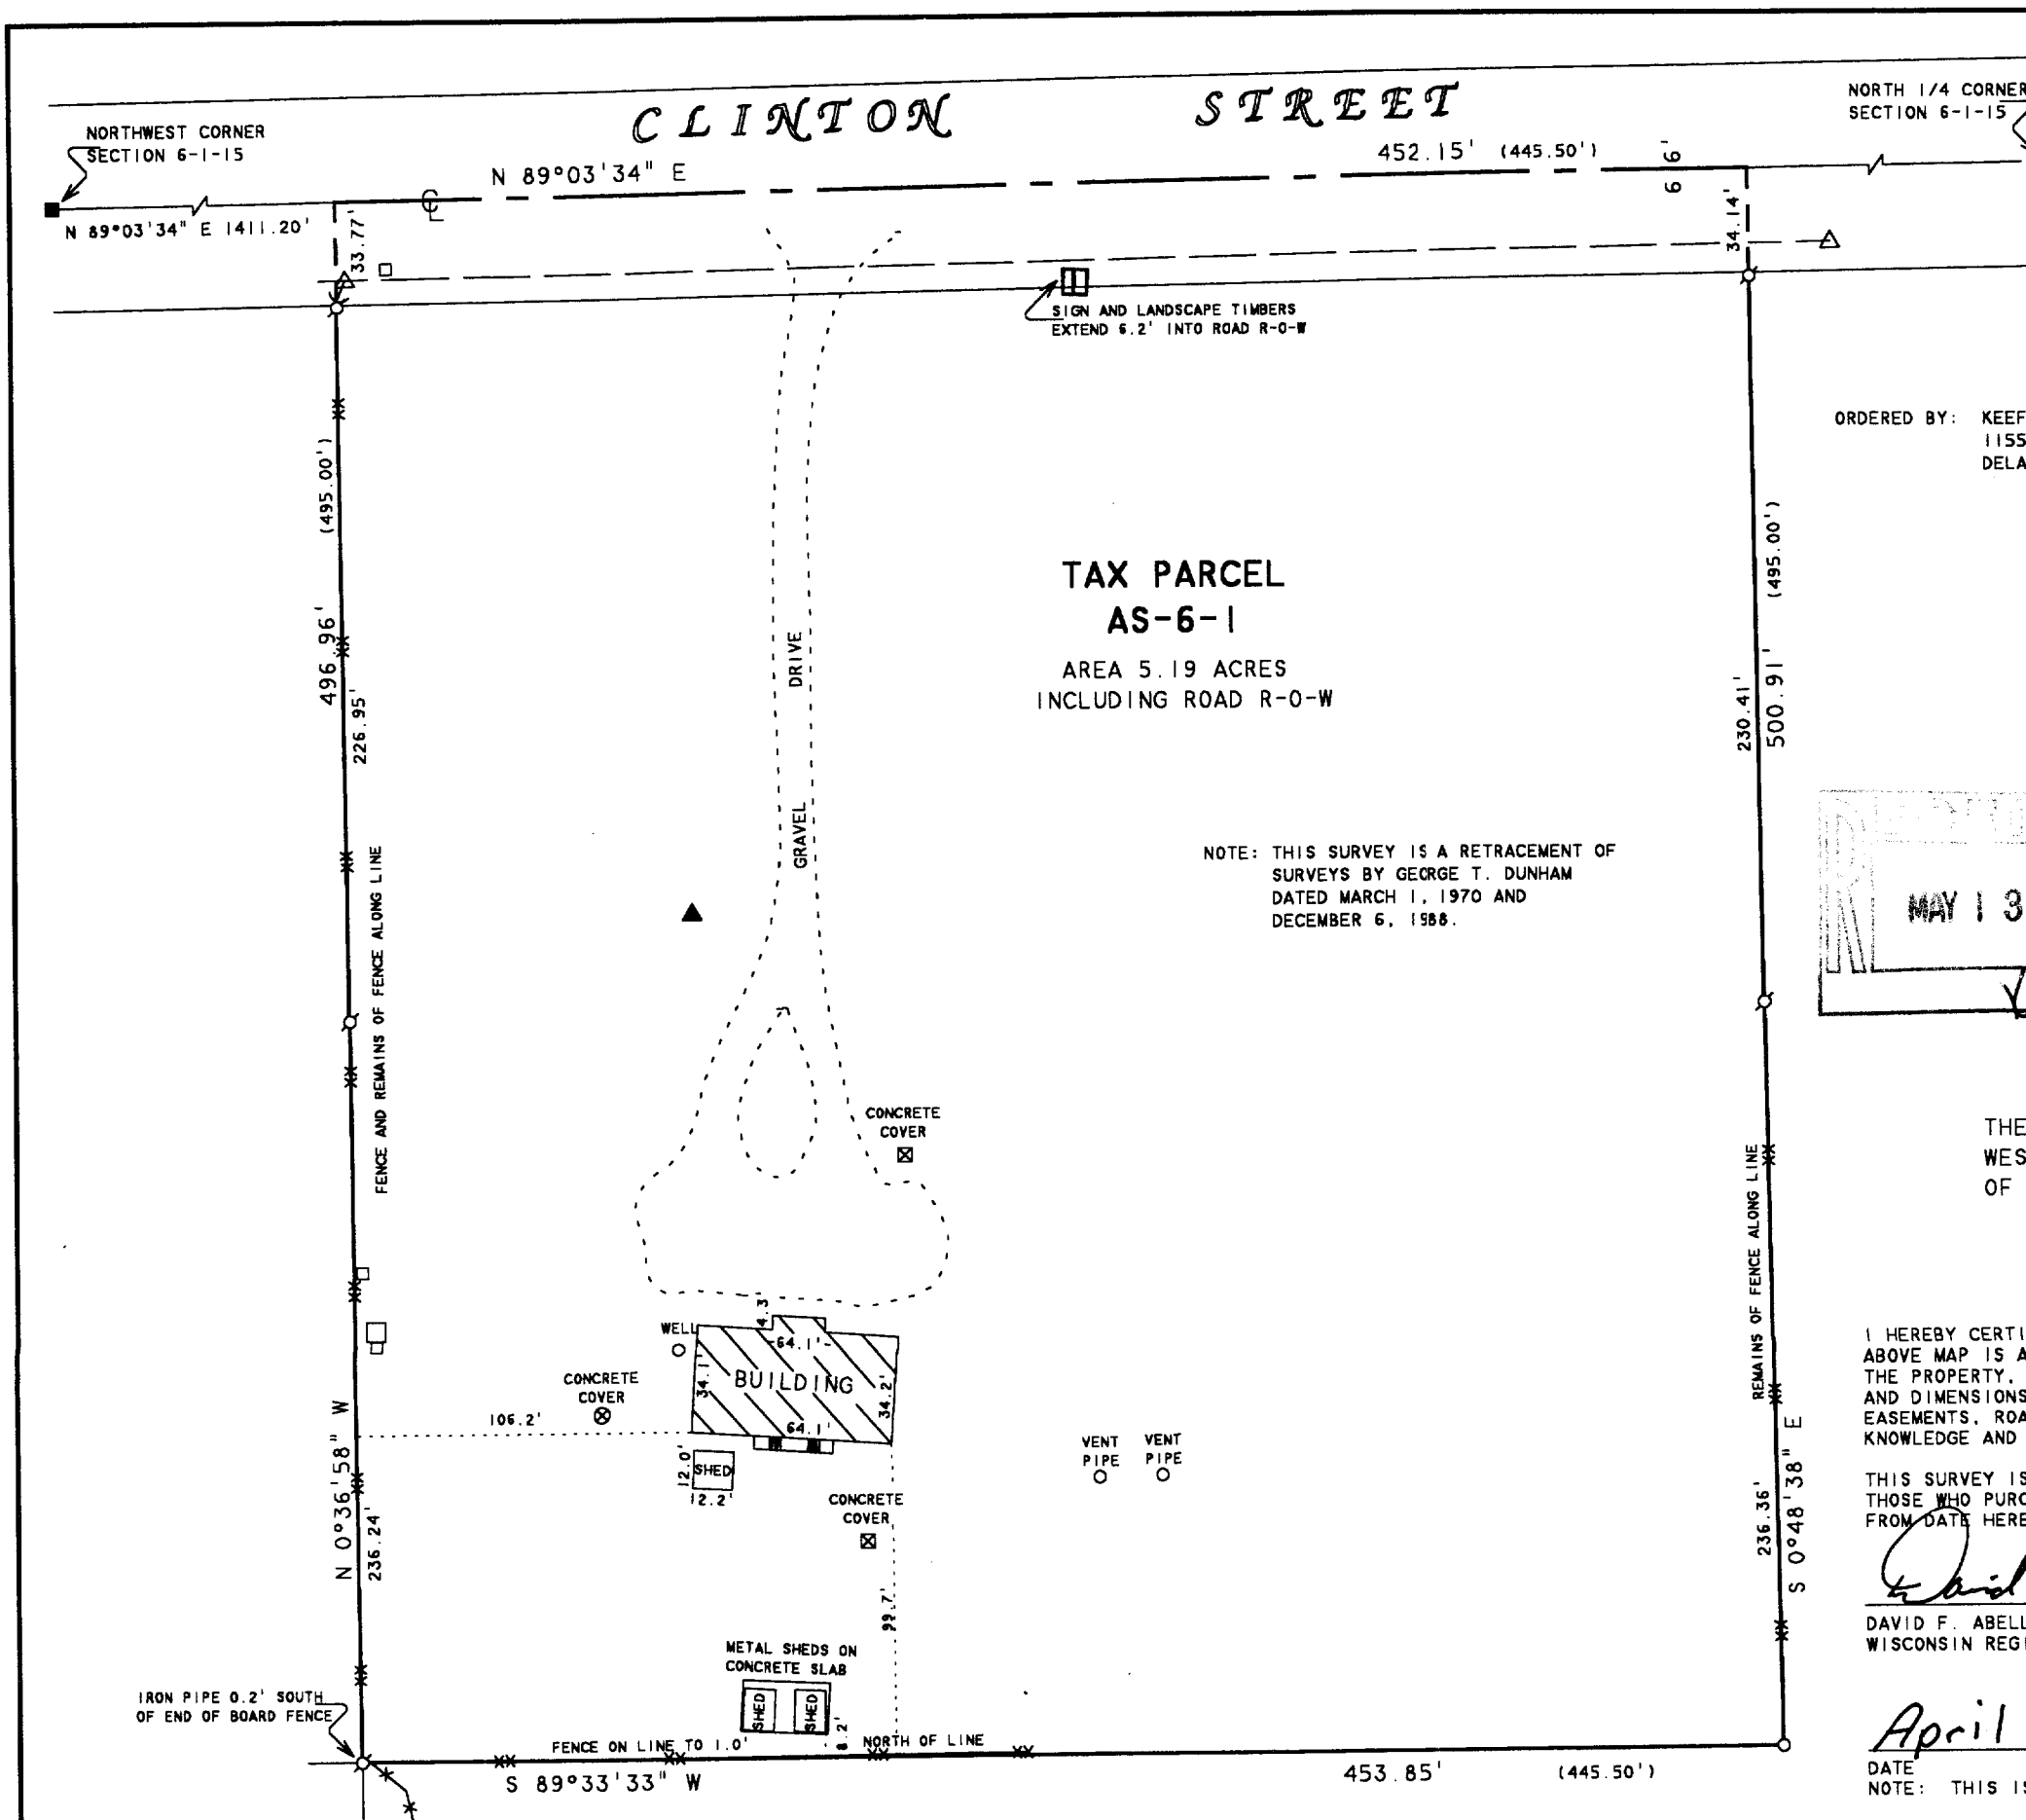

AS 600001