



WORK ORDERED BY -
GEORGE KIDD
P.O. BOX 833
LAKE GENEVA, WI 53147

FARRIS, HANSEN & ASSOCIATES, INC.
ENGINEERING - ARCHITECTURE - SURVEYING
7 RIDGWAY COURT P.O. BOX 437
ELKHORN, WISCONSIN 53121
OFFICE: (262) 723-2098 FAX: (262) 723-5886

REVISIONS

PROJECT NO.
6680
DATE:
12/29/04
SHEET NO.
1 OF 1


PLAT OF SURVEY

LOT 1 OF CERTIFIED SURVEY MAP NO. 1555
REC. IN VOL. 7 ON PG. 191 AS DOC. NO. 138293

LOCATED IN PART OF THE NW 1/4 OF THE NW 1/4 OF SECTON 6,
TOWN 1 NORTH, RANGE 15 EAST, TOWN OF SHARON, WALWORTH COUNTY, WISCONSIN

ASSIGNED SOUTH LINE OF CLINTON STREET
N 88°50'13" E

LOT 1 - C.S.M. 2710

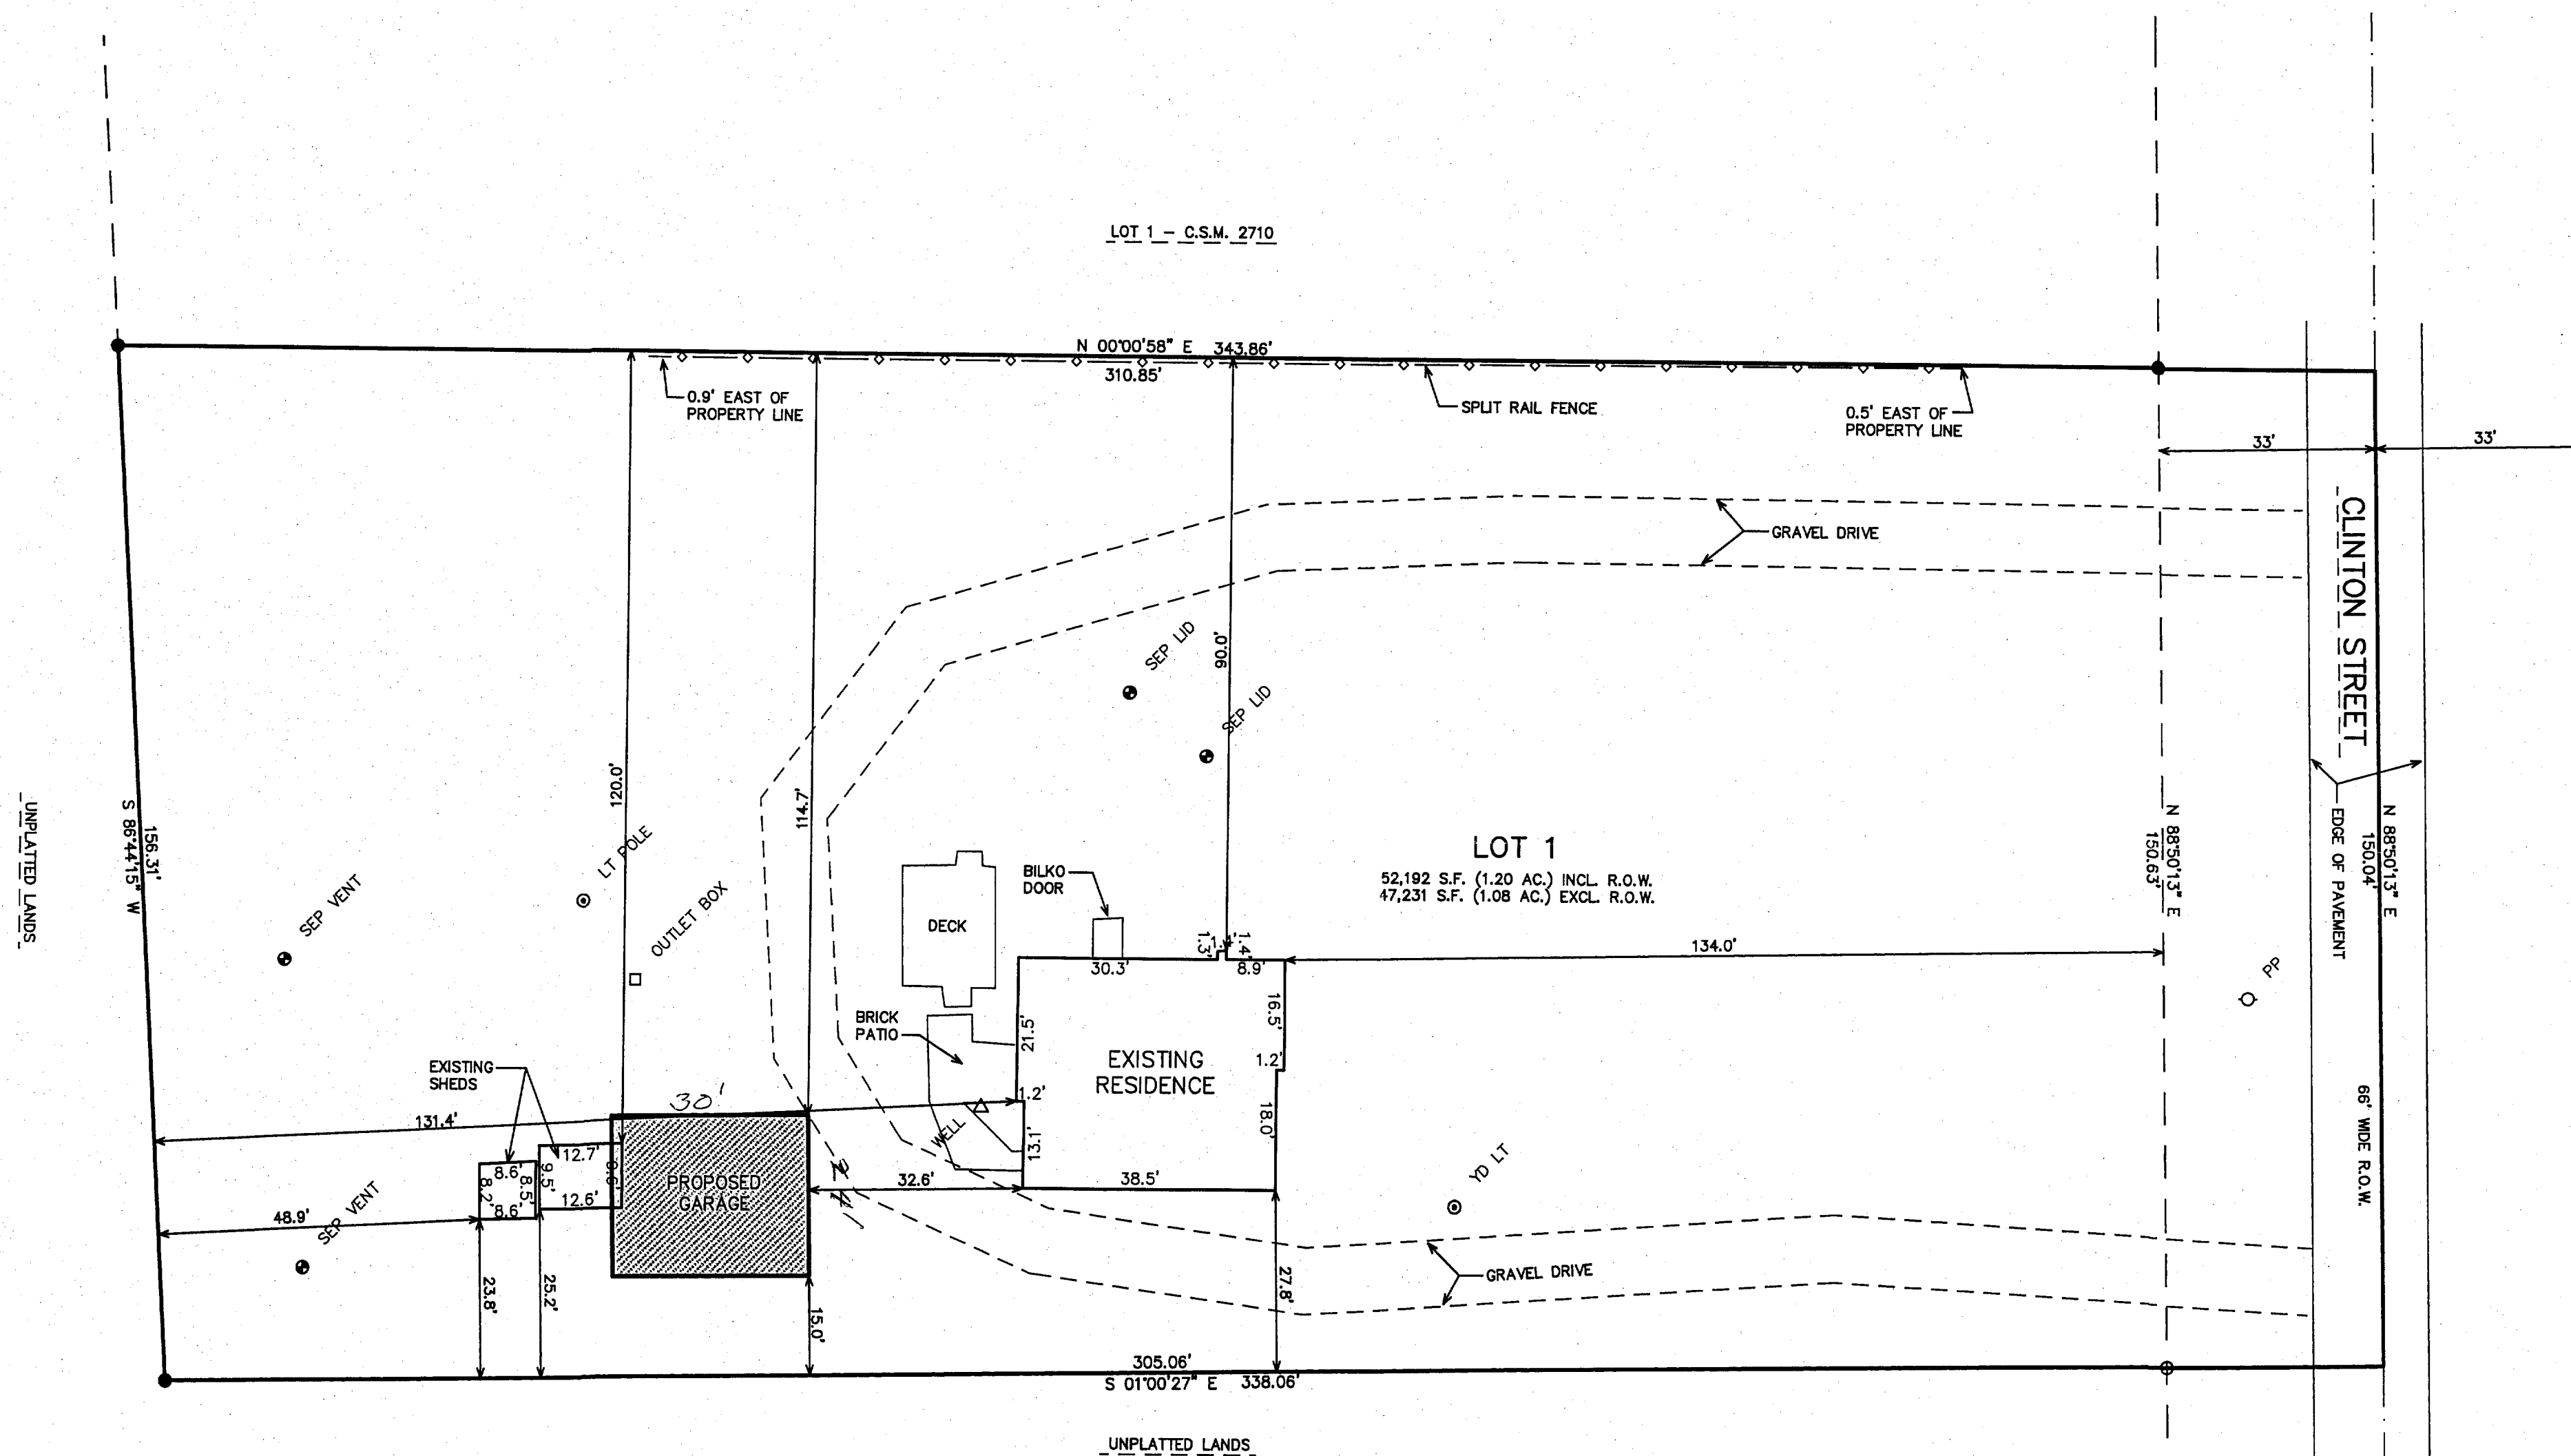

LEGEND
● = FOUND IRON REBAR STAKE
○ = FOUND IRON PIPE STAKE
(XXX) = RECORDED AS

NOTE: COPIES OF THIS MAP TO WHICH THE FOLLOWING CERTIFICATE
WILL APPLY SHOW THE SURVEYOR'S ORIGINAL SEAL AND SIGNATURE
IN RED INK. COPIES BY ANY OTHER MEANS MAY HAVE ALTERATIONS
WHICH DO NOT REPRESENT THE SURVEYOR'S WORK PRODUCT.

I HEREBY CERTIFY THAT THE ABOVE DESCRIBED PROPERTY HAS BEEN
SURVEYED UNDER MY DIRECTION AND THAT THE ABOVE MAP IS A TRUE
REPRESENTATION THEREOF AND SHOWS THE SIZE AND LOCATION OF
THE PROPERTY AND ITS EXTERIOR BOUNDARIES. THIS SURVEY IS
MADE FOR THE USE OF THE PRESENT OWNERS OF THE PROPERTY, AND
ALSO THOSE WHO PURCHASE, MORTGAGE, OR GUARANTEE THE TITLE
THERE TO WITHIN ONE YEAR FROM THE DATE HEREOF.

DATED: DECEMBER 29, 2004

PETER S. GORDON R.L.S. 2101



FEB - 4 2005

MAP SCALE IN FEET ORIGINAL 1" = 20'

AA1555-1

115-306

DEC 29 2004

12/29/2004 X:\Projects\6680\Doc\SURVEY