


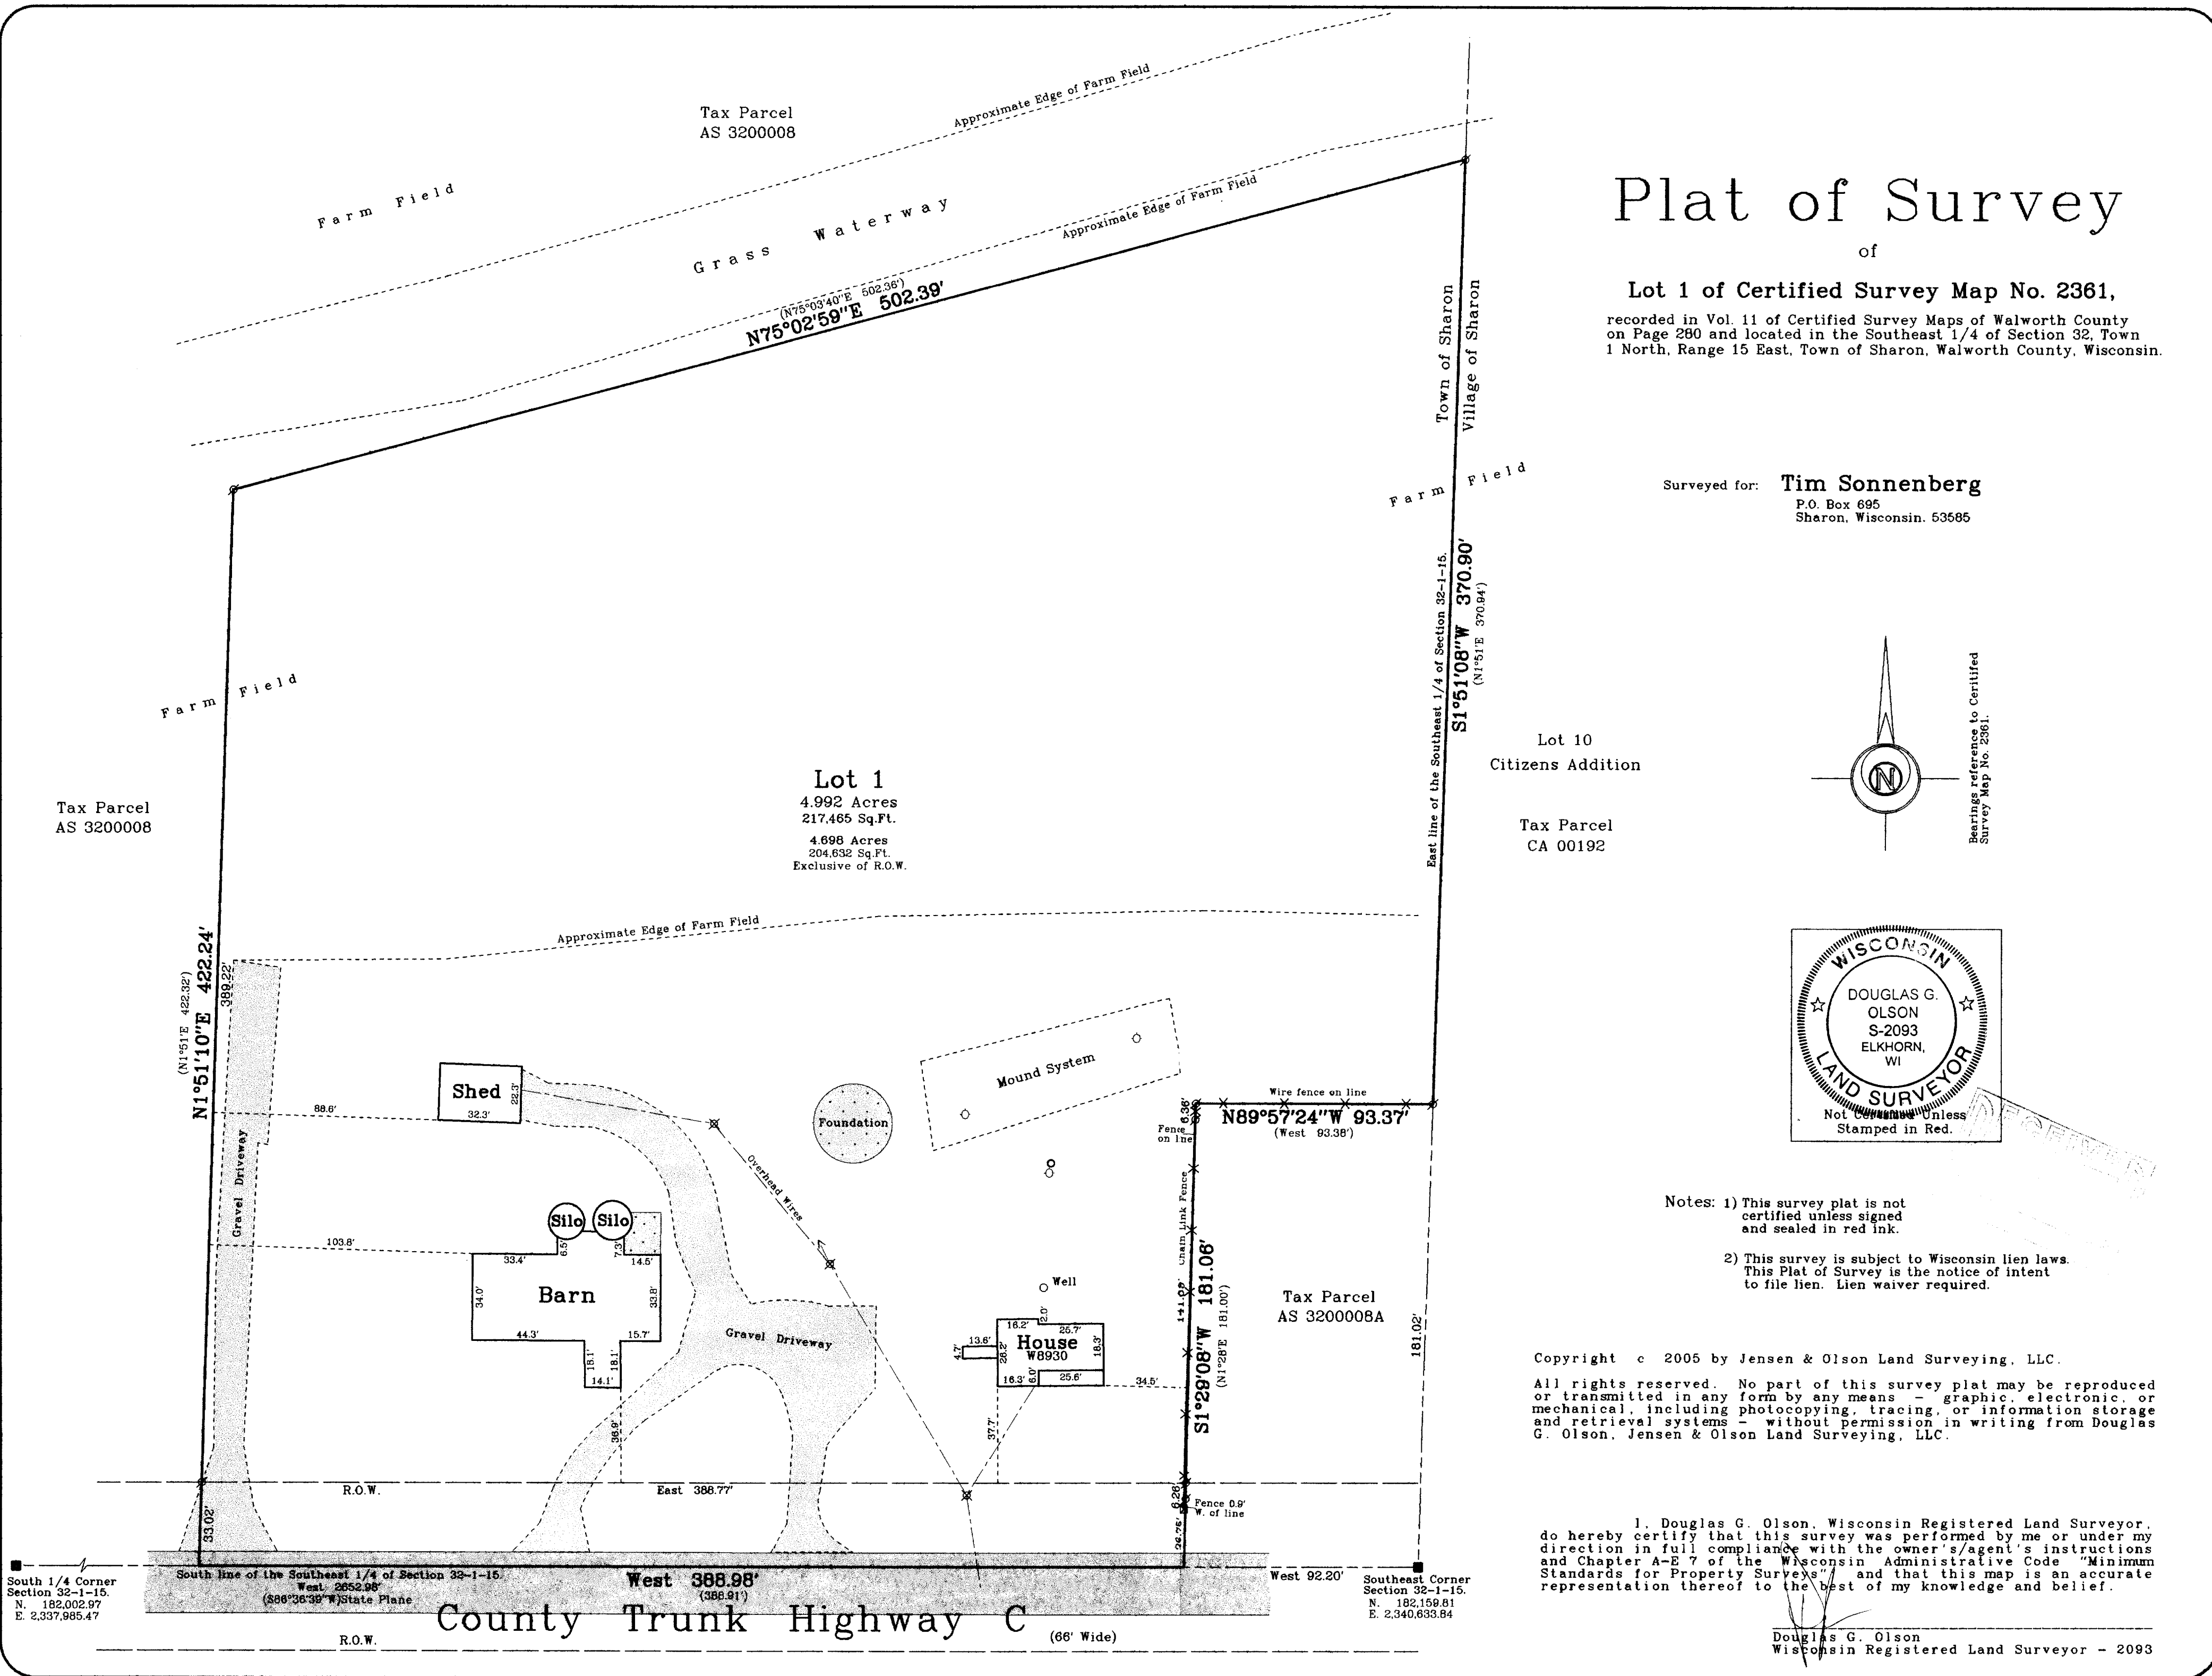

Survey Date: April 27, 2005.

Revisions:

Jensen & Olson Land Surveying, LLC

45 South Wisconsin Street P.O. Box 322
Elkhorn, Wisconsin 53121
Telephone (262) 723-3434
Facsimile (262) 723-8044

Legend

Found County Section Corner

Found Iron Pipe

Recorded Information

Utility Pole

Concrete Cover

Asphalt Surface

Concrete Surface

Sheet 1 of 1 Sheets

Job Reference Number

2005.013

2005.013

AA2361/2361