
PREPARED FOR NATHAN JURWOSKI WASSEL, HARVEY & SCHUK, LLP 1034D ANN STREET DELAVAN WI. 53115

PLAT OF

THE EAST LINE OF LOT 2 CERTIFIED SURVEY MAP NO. 4130 BEING PART OF THE SOUTHWEST 1/4 OF THE SOUTHWEST 1/4 AND THE WEST 10 ACRES OF THE NORTHWEST 1/4 OF THE SOUTHWEST 1/4 OF SECTION 30, TOWN 1 NORTH, RANGE 15 EAST, TOWN OF SHARON, WALWORTH COUNTY, WISCONSIN.

KROTT SURVEYING INC.

N3705 WILLOW BEND LANE LAKE GENEVA WI. 53147 PHONE # (262)248-3697 FAX # (262)249-0639

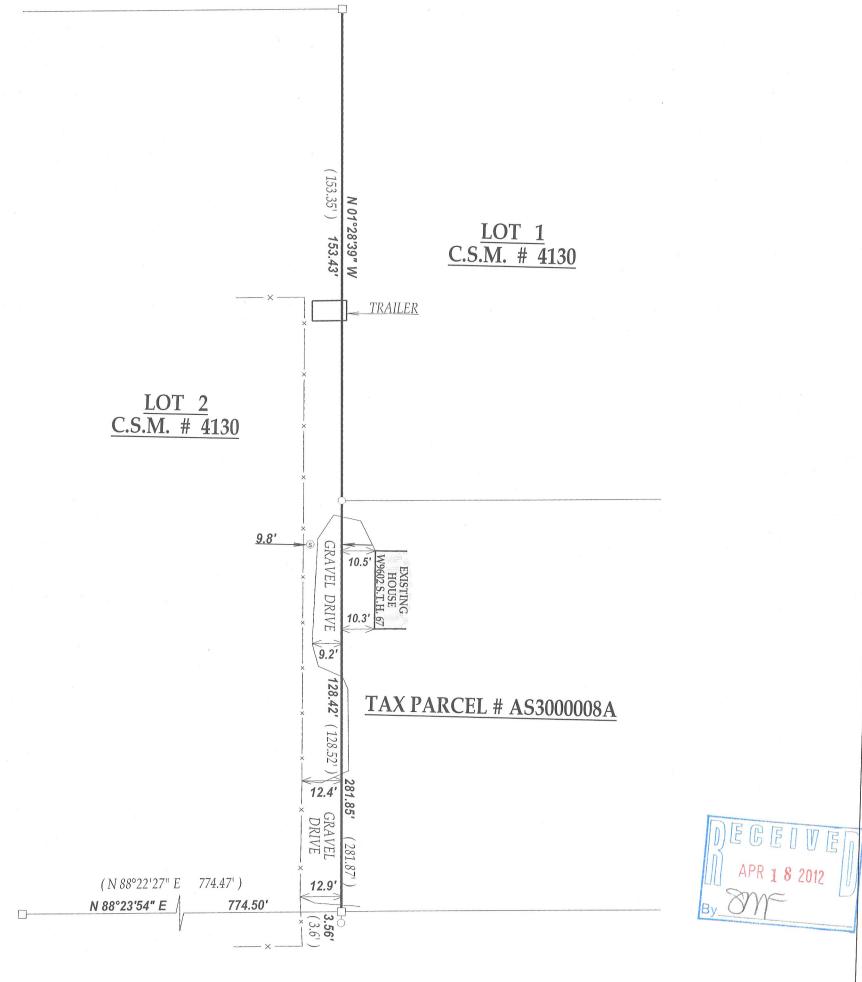

LEGEND

O FOUND IRON PIPE

C.L.

STATE

- ☐ FOUND IRON BAR
- SATELLITE DISH

---WIRE FENCE

(XX) RECORDED AS TAX ID # AA4130 00002 JOB # 12-033




SCALE 1" = 30'

TRUNK HIGHWAY

(66' WIDE)



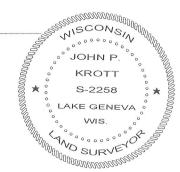

DATED THIS 28th DAY OF MARCH 2012.

John Shill

JOHN KROTT S - 2258 Wisconsin Registered Land Surveyor (original if signed in red)

115-392