


Wisconsin Registered Land Surveyor S-2582

**MARKMIRITZ@
LAND-MARKSURVEYING.COM**

**ORDERED BY: HARRY MOHR
THE RAULAND AGENCY
118 KENOSHA STREET
WALWORTH, WI 53184**

LOT 2
5.00 ACRES

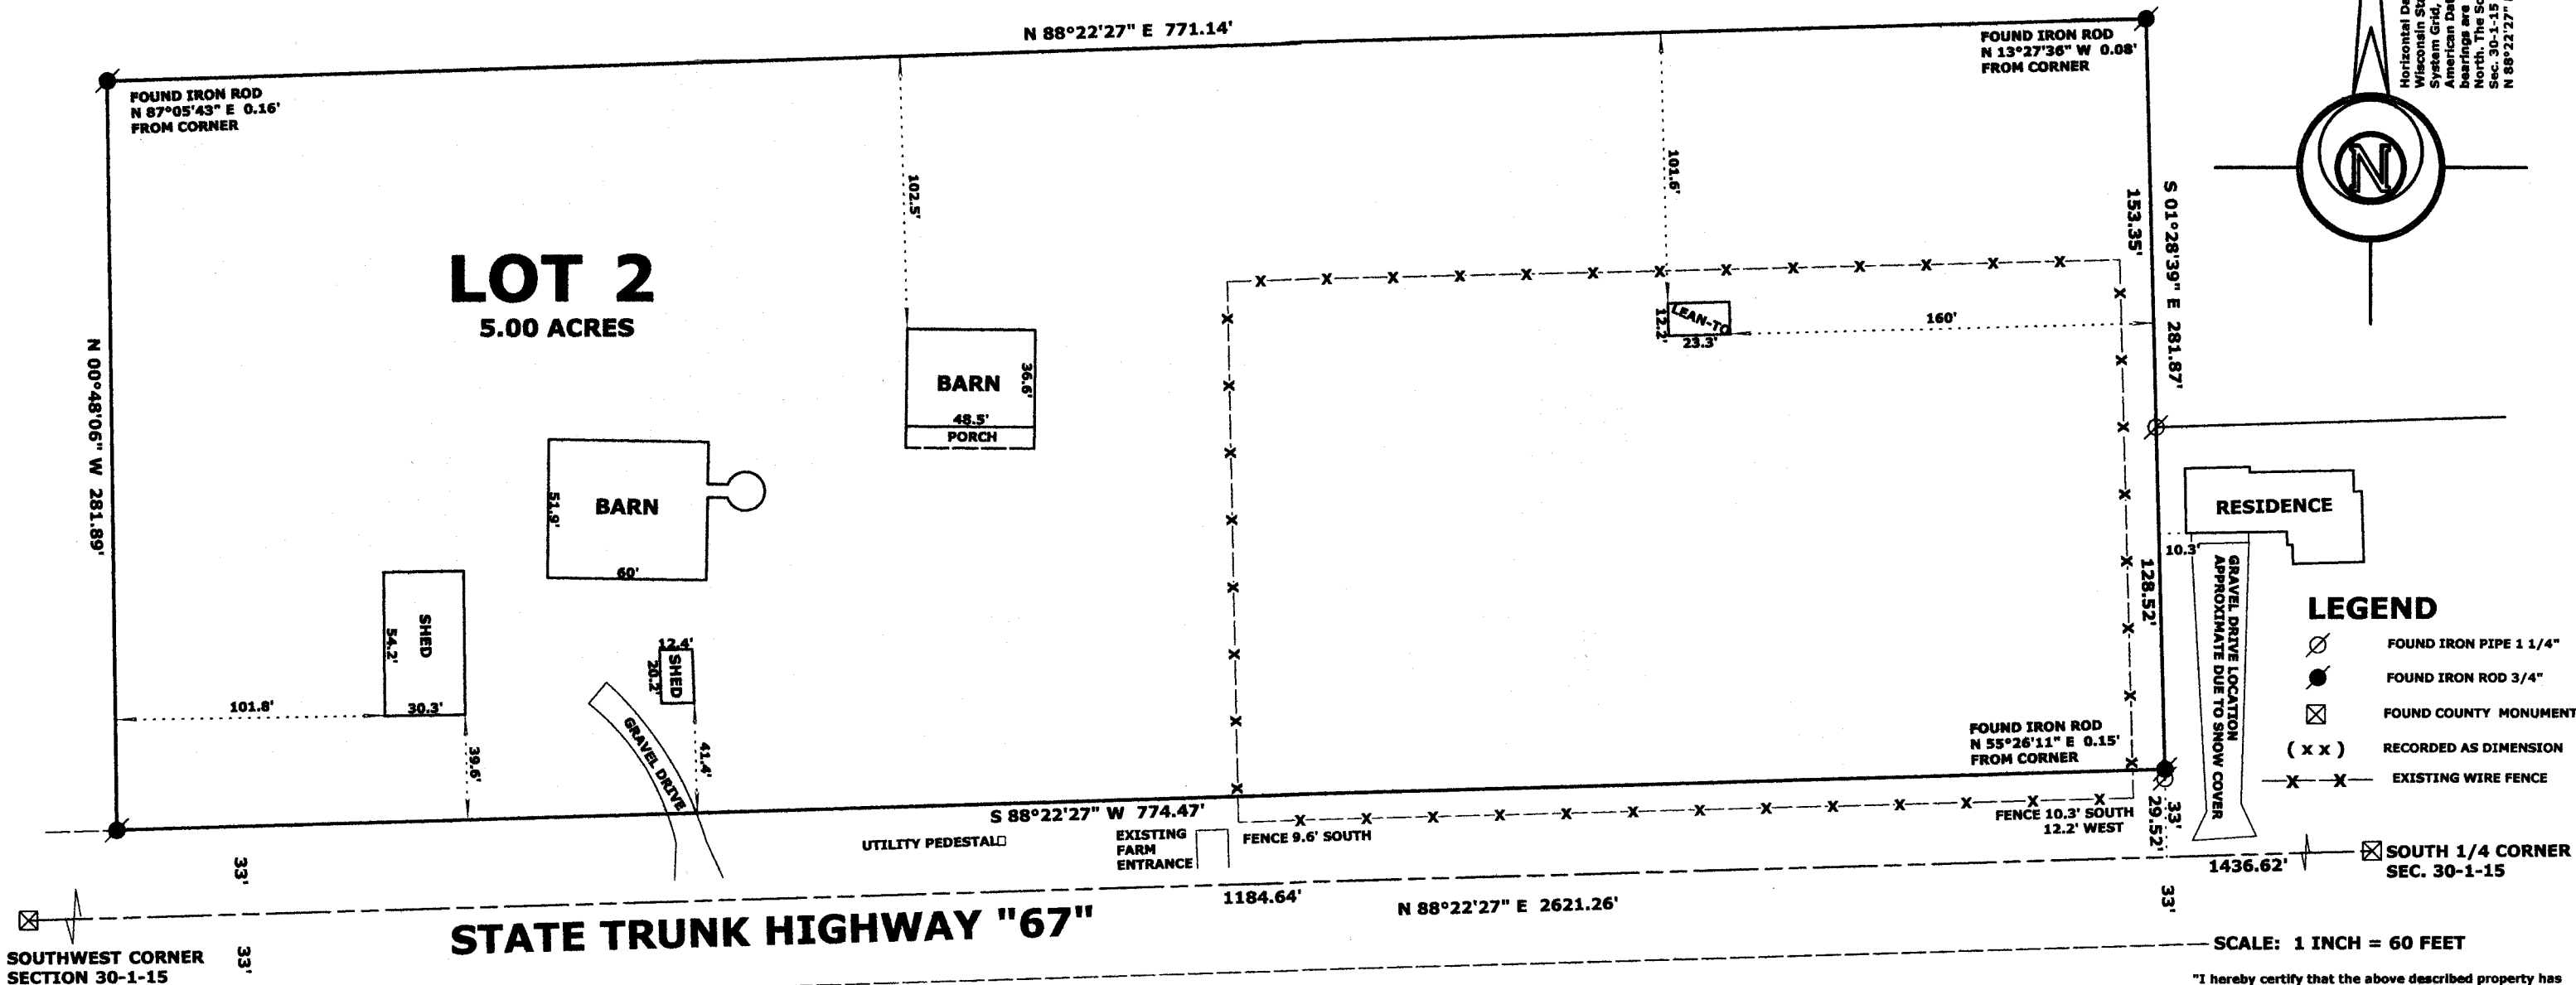

— SCALE: 1 INCH = 60 FEET


"I hereby certify that the above described property has been surveyed by me or under my direction and that the above map is a true representation thereof and shows the size and location of the property, its exterior boundaries, the location of all visible structures and dimensions of all principal buildings thereon, boundary fences, apparent easements, roadways and visible encroachments, if any."

"This survey is made for the use of the present owners of the property, and also those who purchase, mortgage, or guarantee the title thereto within one year from date hereof."

Mark L. Miritz
 MARK L. MIRITZ
 WISCONSIN REGISTERED
 LAND SURVEYOR S-2582

DATE: NOV. 26, 2013 **JOB NO.** 13.1108

DEC 1 2 2013

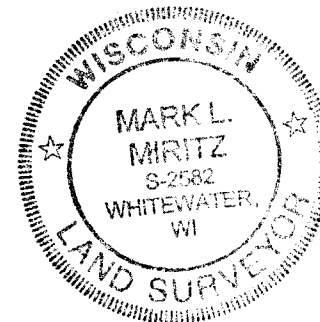

AA4130—2

115-412