


Plat of Survey
of

A parcel of land described in a Warranty Deed recorded November 21, 2005 as Document No. 660513 as shown below:
Lot 3 of Certified Survey Map No. 2590 recorded May 18, 1995, as Document #306068, in Volume 13 of Certified Survey
Maps, on Page 84, in the office of the Register of Deeds for Walworth County, Wisconsin; being part of the S.E. 1/4
of the N.W. 1/4 of Section 17, T. 1 N., R. 15 E., Town of Sharon, County of Walworth and State of Wisconsin.


ALSO

Lands described in a Quit Claim Deed recorded March 18, 2016 as Document No. 921990 as shown below:
Part of Lot 2 of Certified Survey Map No. 2590, recorded in Vol. 13 of Certified Survey Maps of Walworth County on
Page 84, and located in the Northwest 1/4 of Section 17, Town 1 North, Range 15 East, Town of Sharon, Walworth County,
Wisconsin, described as follows: Commence at the North 1/4 Corner of said Section 17; thence South 0°09'09" East,
along the East line of said Northwest 1/4 and the centerline of Salt Box Road, 2449.75 feet to the Southeast 1/4 of
said Lot 2; thence South 87°18'47" West, along the South line of said Lot 2, 757.38 feet to an iron pipe at the Point
of Beginning; thence continue South 87°18'47" West, along said South line of Lot 2, 562.50 feet to an iron pipe at the
Southwest corner of said Lot 2; thence North 0°07'09" West, along the West line of said Lot 2, 22.50 feet to an iron
pipe; thence North 87°43'08" East 561.50 feet; thence South 2°41'13" East 18.50 feet to the Point of Beginning.
Said parcel contains 0.264 acre (11,515 sq. ft.) of land, more or less.

Surveyed for: Mike Rehberg
N1503 Salt Box Road
Sharon, Wisconsin. 53585

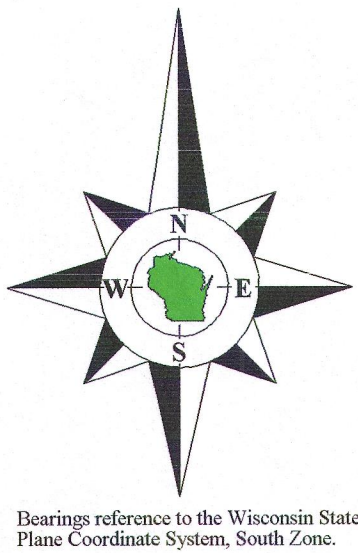

Survey Date: February 24, 2016.
Revisions: No. 1 - Proposed Lot
Line Adj.
No. 2 - Plat of Survey
& Set Pipe
No. 3 - Recorded Deed

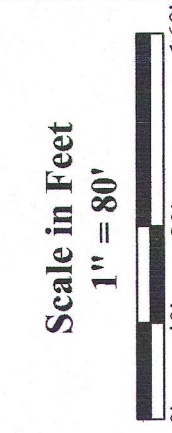

Olson Land Surveying, LLC
45 South Wisconsin Street * P.O. Box 322 * Elkhorn, Wisconsin. 53121
Telephone: (262) 723-3434 * Facsimile: (262) 723-8044
Email: doug@olsonsurveying.com

Legend
Found County Section Corner
Found Iron Rod 03-10-16
Set Iron Pipe 03-10-16
Record Information
Set Wood Lathe 06-09-15
Asphalt Surface

Sheet 1 of 1 Sheets
Job Reference Number
2015.007


2015.007

Tax Parcel
AS 1700004

Lot 2
C.S.M. 2590

Lot 1
C.S.M. 2590

Salt Box Road
(66' Wide)

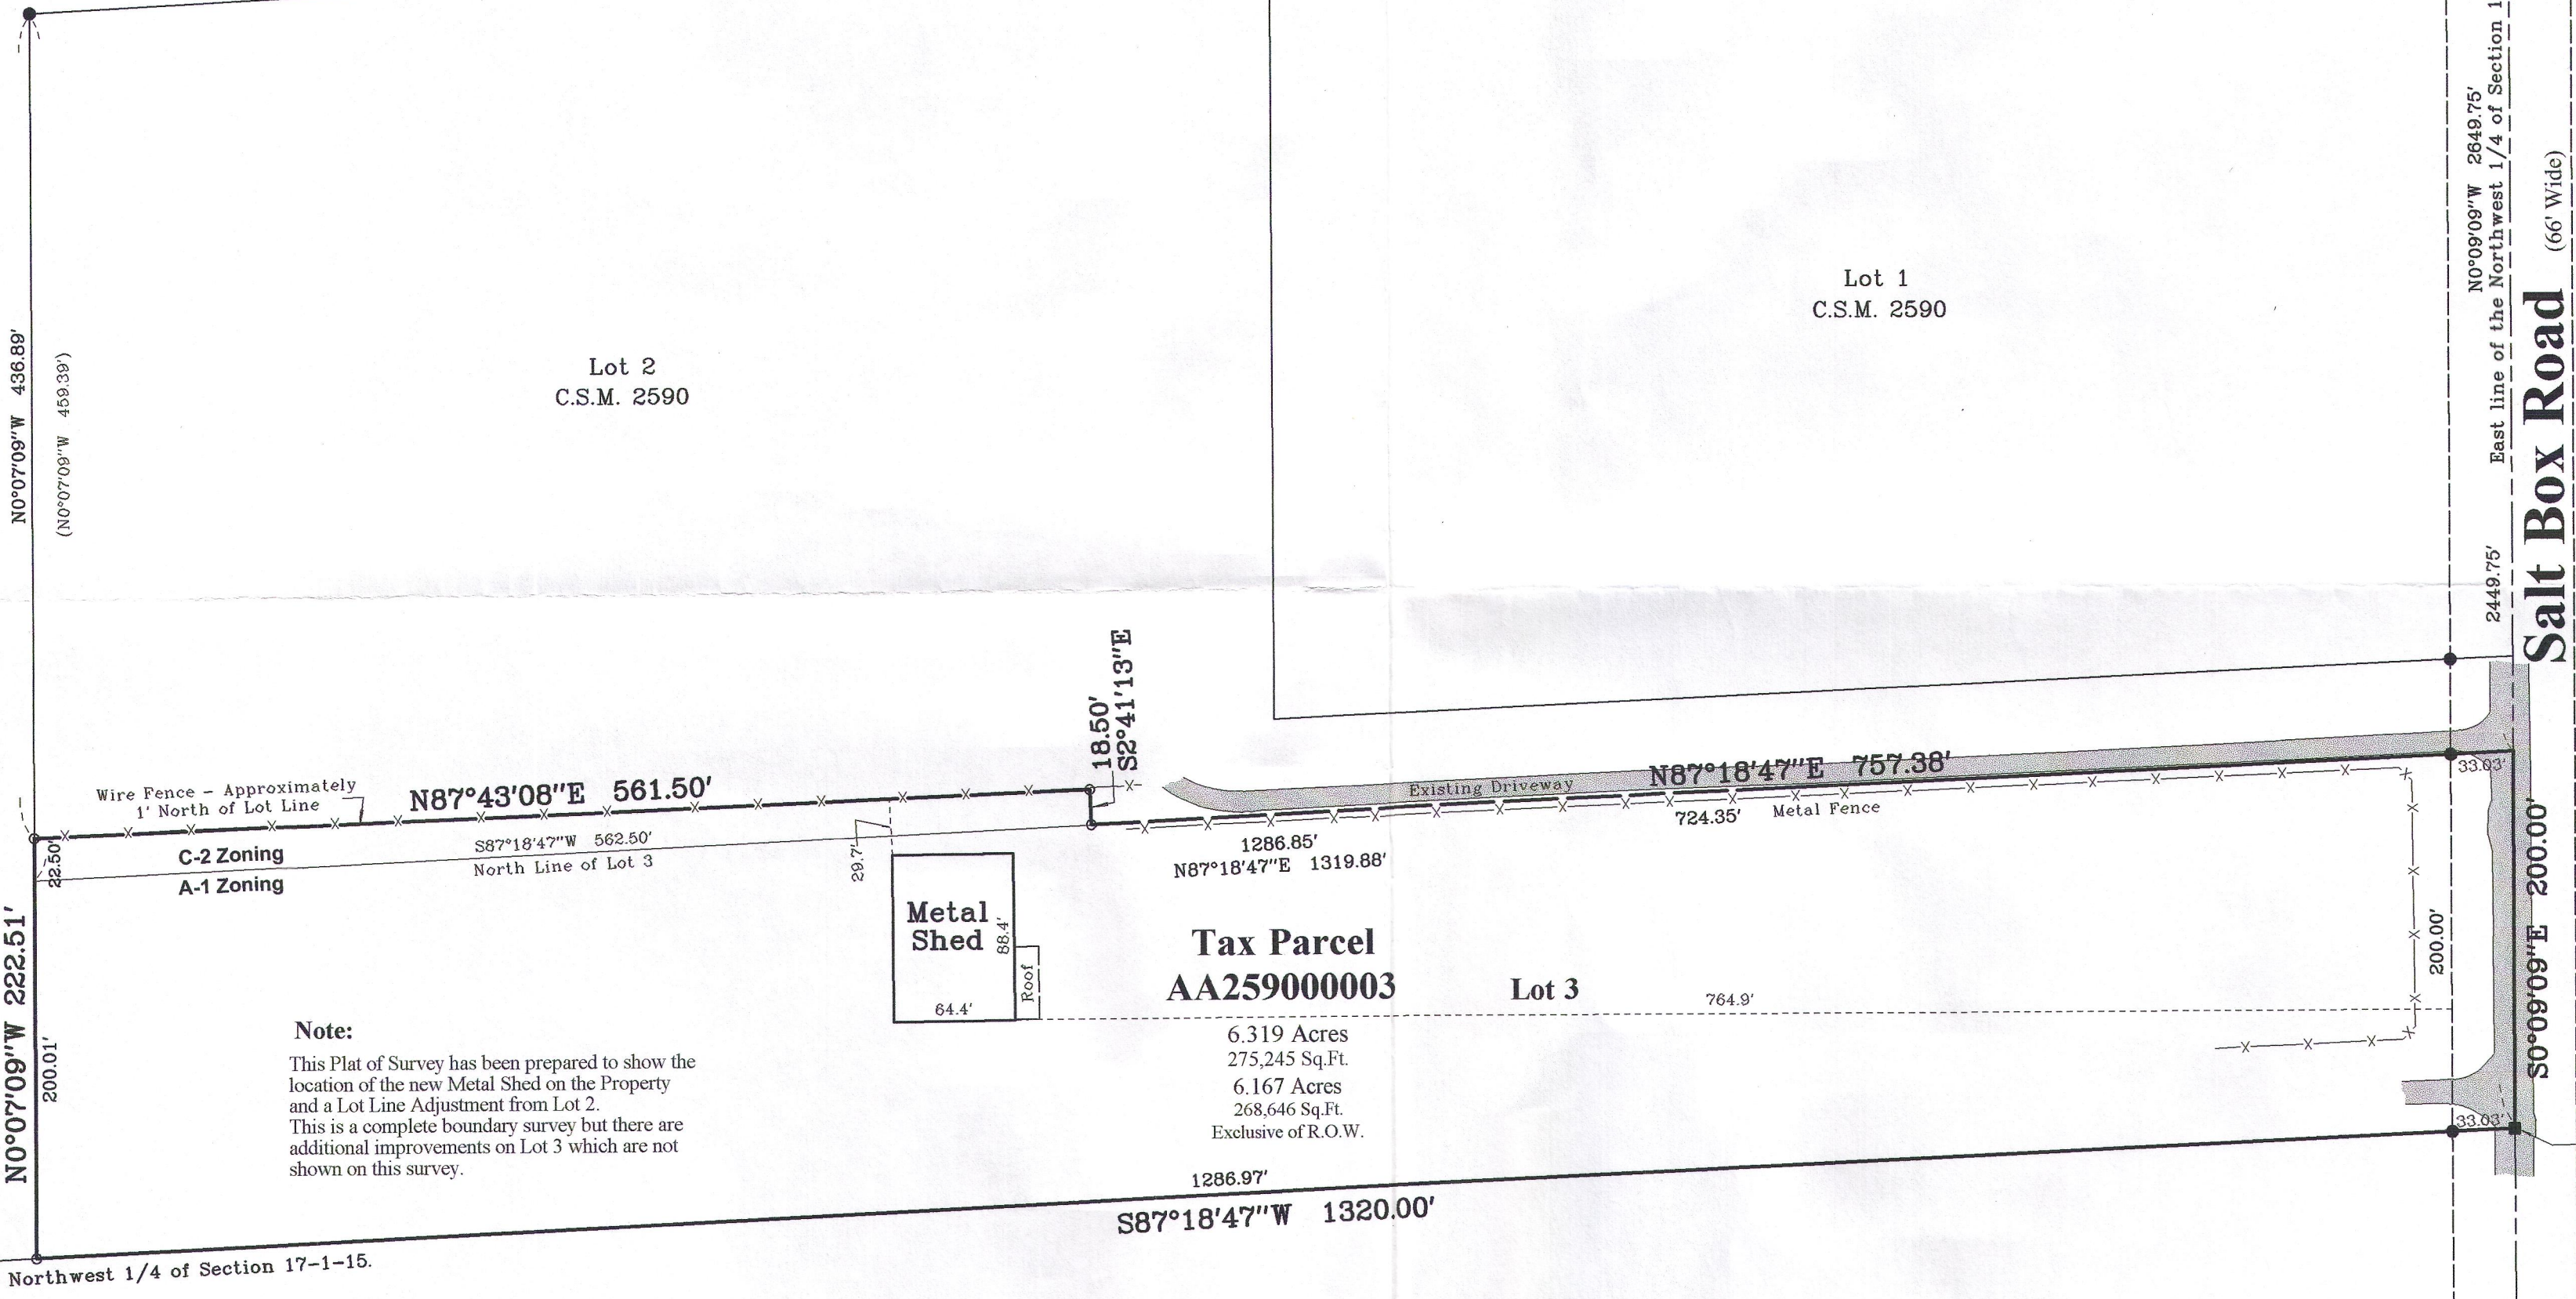

Note:
This Plat of Survey has been prepared to show the
location of the new Metal Shed on the Property
and a Lot Line Adjustment from Lot 2.
This is a complete boundary survey but there are
additional improvements on Lot 3 which are not
shown on this survey.

Tax Parcel
AA259000003


6.319 Acres
275,245 Sq.Ft.
6.167 Acres
268,646 Sq.Ft.
Exclusive of R.O.W.

Copyright 2015 by Olson Land Surveying, LLC.

All rights reserved. No part of this survey plat may be reproduced or transmitted in
any form by any means - graphic, electronic, or mechanical, including photocopying,
tracing, or information storage and retrieval systems - without permission in writing
from Douglas G. Olson, Olson Land Surveying, LLC.

I, Douglas G. Olson, Wisconsin Professional Land Surveyor, do hereby certify
that this survey was performed by me, or under my direction in full compliance with
the owner's/agent's instructions and Chapter A-E 7 of the Wisconsin Administrative
Code "Minimum Standards for Property Surveys"; and that this map is an accurate
representation thereof to the best of my knowledge and belief.

Douglas G. Olson
Wisconsin Professional Land Surveyor - 2093

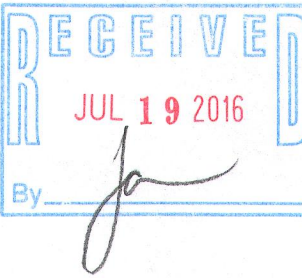

- Notes:
1) This survey plat is not
certified unless signed
and sealed in red ink.
2) This survey is subject to Wisconsin lien laws.
This Plat of Survey is the notice of intent
to file lien. Lien waiver required.

AA2590-3

115-440