

OF

North 1/4 Corner
Sec 6 - 1 - 15

705.36'
 (702.25' plat)

East Line of the Northwest 1/4 Section 6-1-15 S 00°28'45" E 2982.73

TAX ID # AAG 00011A

33

N 00°28'45" W 171.85'

(66' wide)

Sheldon Street

N 00°28'45" W 2982.73'

(66'

Lot 1

4.344 Acres
189,210 Sq. Ft.

7

Block

(20' wide)

(198.56'

Lot 13

683.25
Highway

(66' wide)

Trunk

County _____

PREPARED FOR:
ANA BONILLA DEINIGUEZ

I HEREBY CERTIFY THAT I HAVE SURVEYED THE ABOVE DESCRIBED PROPERTY AND THE ABOVE MAP IS A TRUE REPRESENTATION THEREOF AND SHOWS THE SIZE AND LOCATION OF THE PROPERTY, ITS EXTERIOR BOUNDARIES, THE LOCATION AND DIMENSIONS OF ALL STRUCTURES THEREON, FENCES, APPARENT EASEMENTS, ROADWAYS, AND VISIBLE ENCROACHMENTS, IF ANY.

THIS SURVEY IS MADE FOR THE PRESENT OWNERS OF THE PROPERTY AND THOSE WHO PURCHASE, MORTGAGE, OR GUARANTEE THE TITLE THERETO WITHIN ONE YEAR FROM THIS DATE HEREOF.

DATED THIS 6TH DAY OF JUNE 2023

LAKELAND SURVEYORS LLC

P O BOX 188

DEHAVAN, WI 53115


262-475-9567

email: lakelandsurveyors@outlook.com



Center 1/4 Corner
Sec 6 - 1 - 15

RECEIVED
JUN 26 2023
By EMK

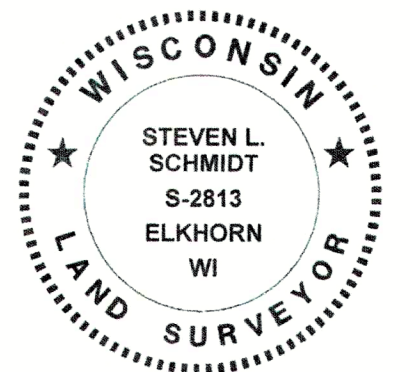

Steve Schmidt

STEVEN L SCHMIDT S - 2813
Wisconsin Professional Land Surveyor

115-512

Vacated Allen Street
(Vacated by Document No. 1025514)

S 00°50'01" E 418.28'

S 00°50'01" E 418.28'

AG-11A