
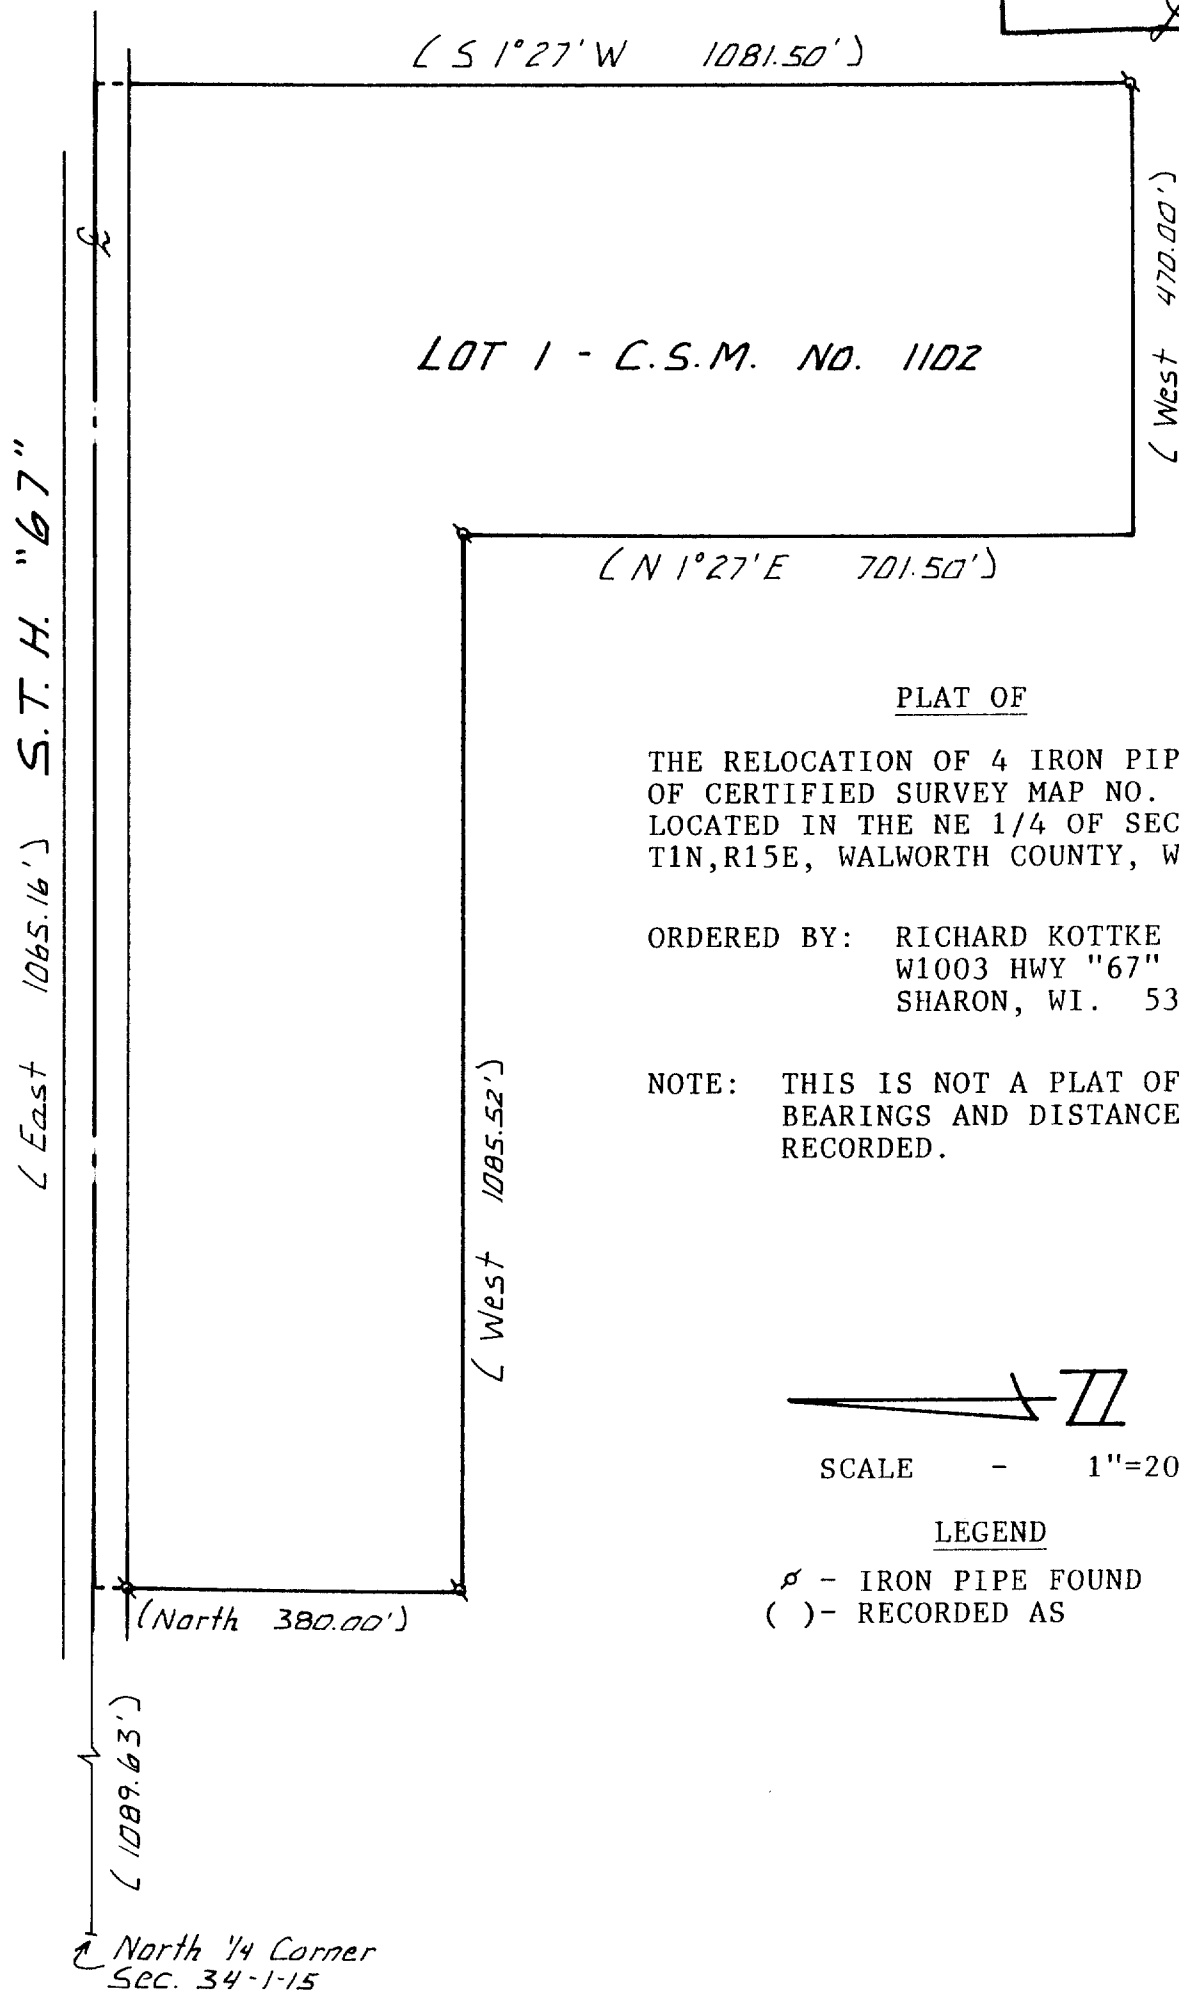


ABELL  
SURVEYING & MAPPING  
DELAVER, WISCONSIN 53115  
414-728-6737

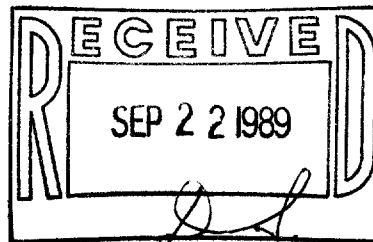


PLAT OF

THE RELOCATION OF 4 IRON PIPES ON LOT 1  
OF CERTIFIED SURVEY MAP NO. 1102,  
LOCATED IN THE NE 1/4 OF SECTION 34,  
T1N, R15E, WALWORTH COUNTY, WISCONSIN.

ORDERED BY: RICHARD KOTTKE  
W1003 HWY "67"  
SHARON, WI. 53585

NOTE: THIS IS NOT A PLAT OF SURVEY, THE  
BEARINGS AND DISTANCES SHOWN ARE  
RECORDED.

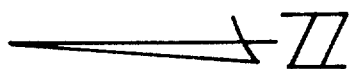

SCALE - 1"=200'

LEGEND

⊗ - IRON PIPE FOUND  
( ) - RECORDED AS

David F. Abell

DAVID F. ABELL  
WISCONSIN REGISTERED LAND SURVEYOR, S-1596

July 25, 1989  
DATE JOB NUMBER - 89147

FILE 1102-1

115-129