



# PLAT OF SURVEY

LOT 1 OF CERTIFIED SURVEY MAP NO. 1102  
 LOCATED IN THE NE & NW 1/4'S OF THE NE 1/4,  
 SEC. 34, T. 1 N., R. 15 E.,  
 WALWORTH COUNTY, WISCONSIN

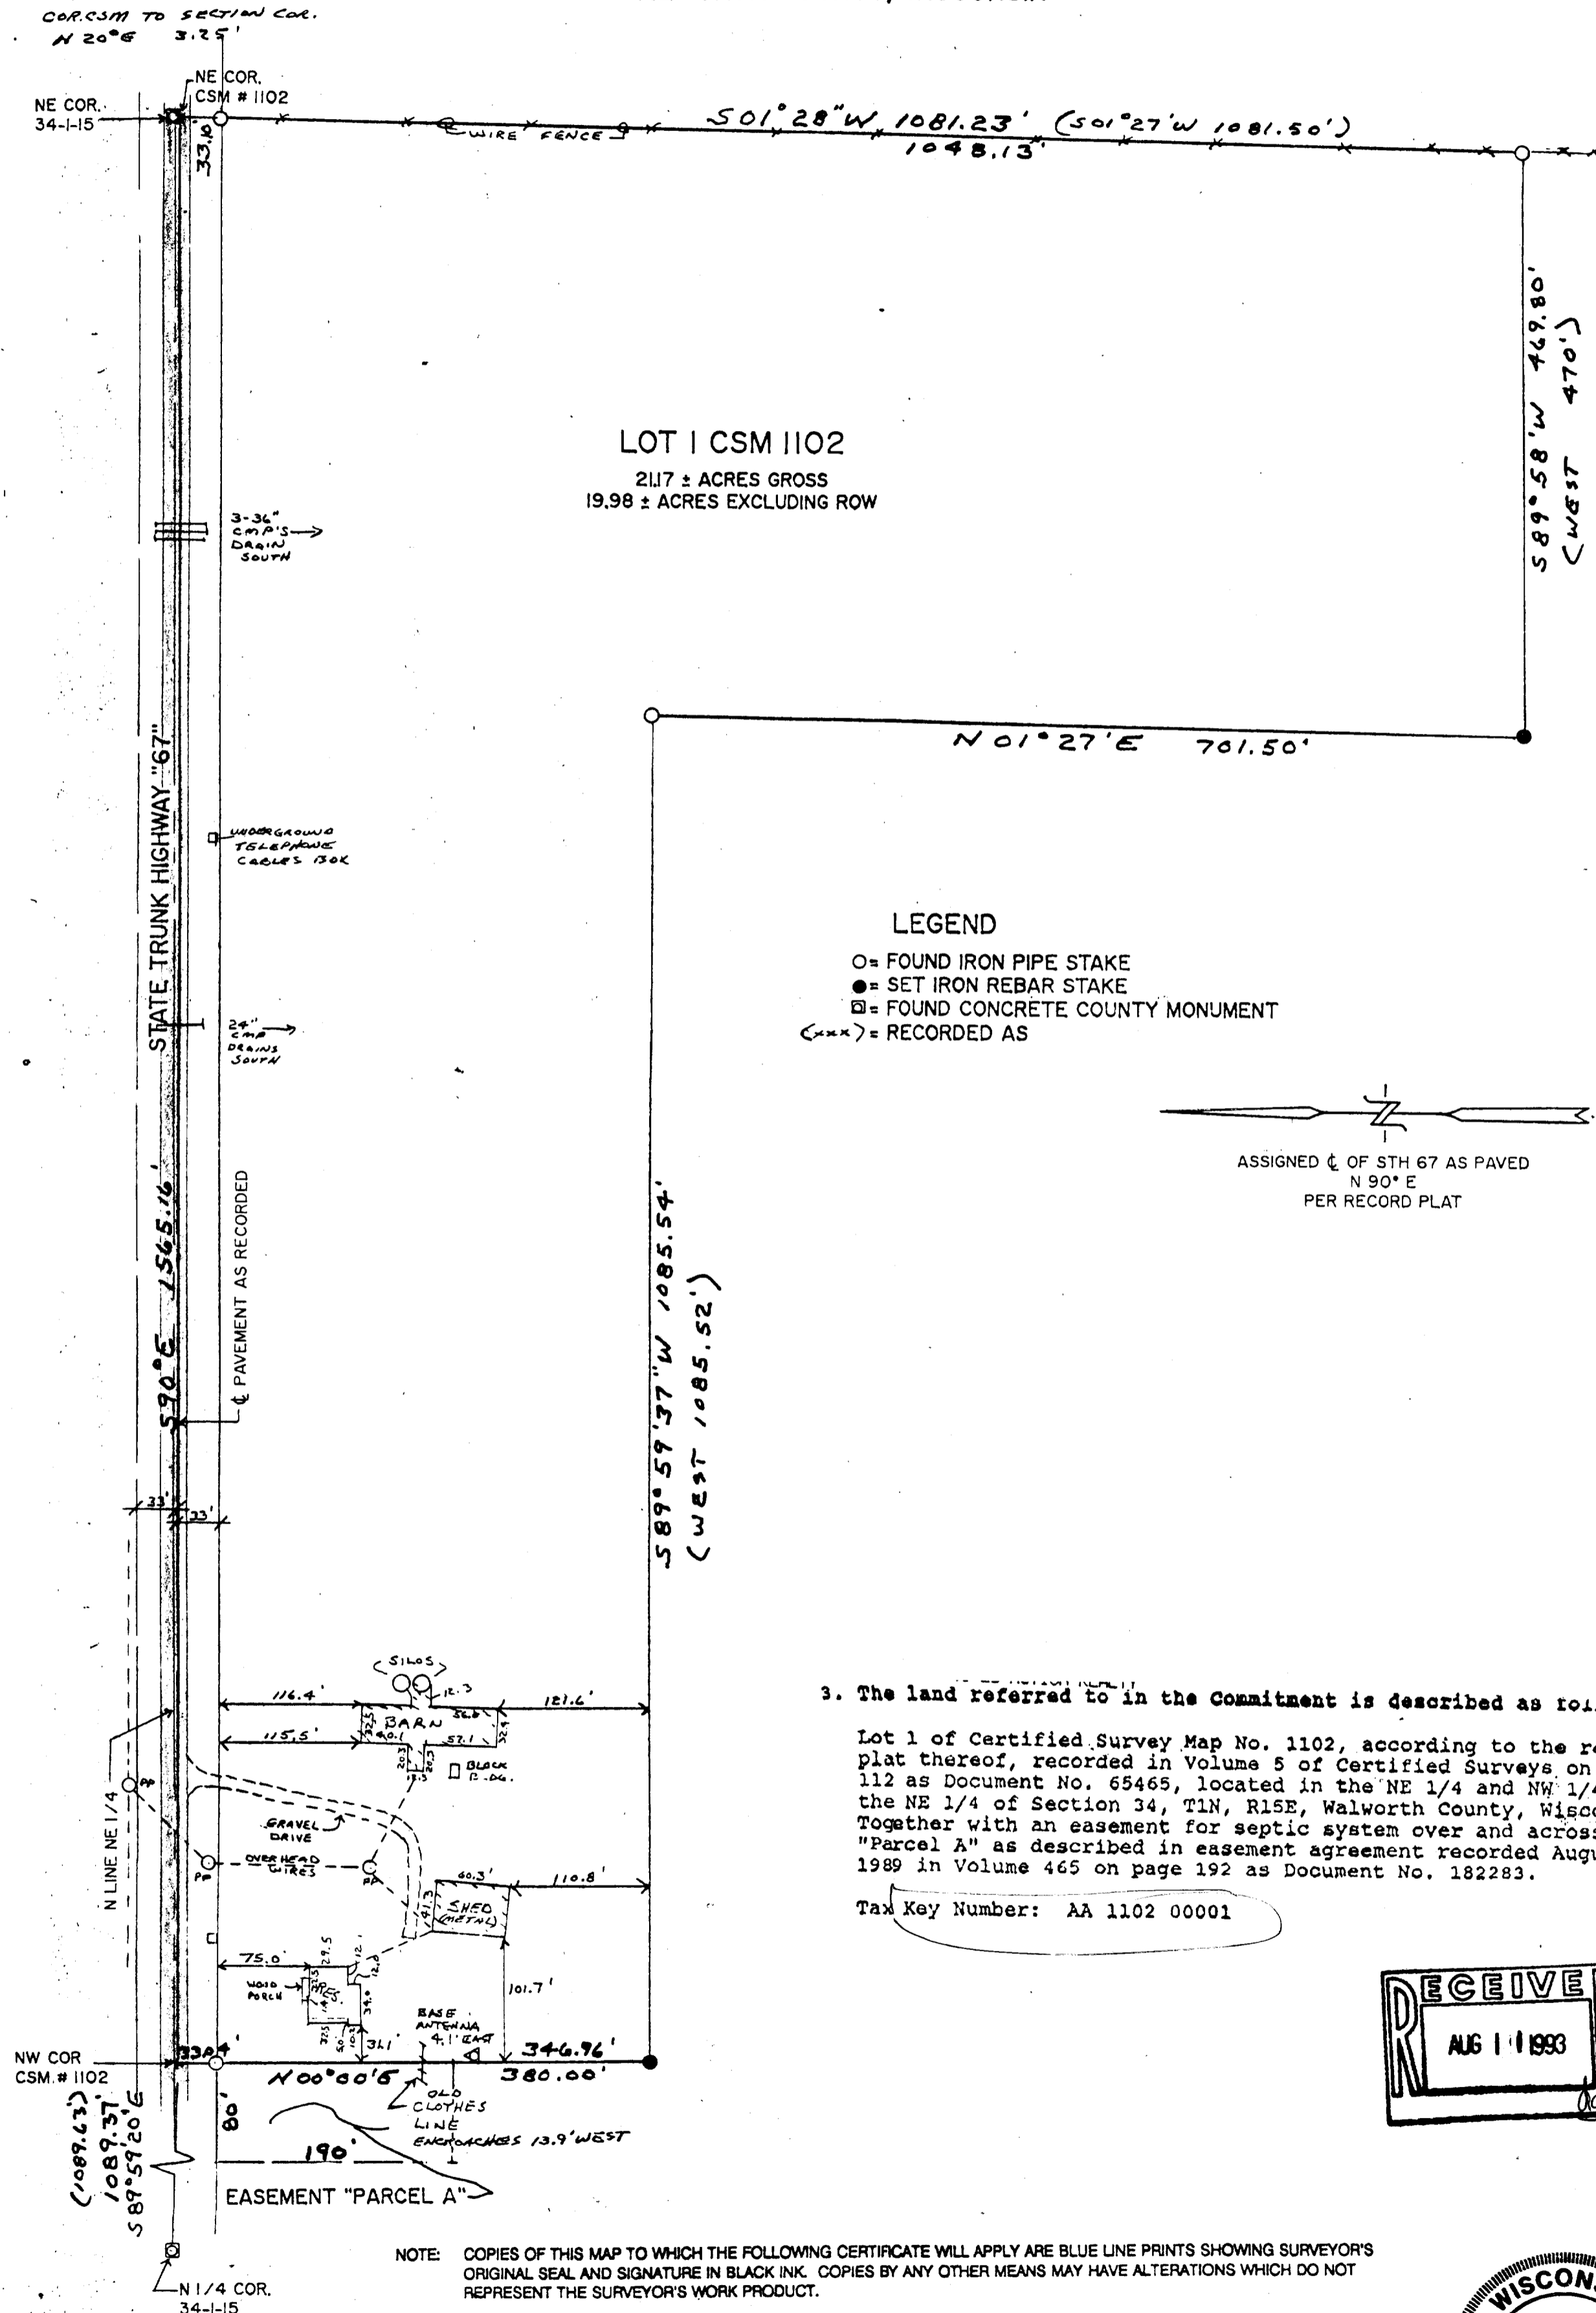

**LOT 1 CSM 1102**  
 21.17 ± ACRES GROSS  
 19.98 ± ACRES EXCLUDING ROW


- LEGEND**
- = FOUND IRON PIPE STAKE
  - = SET IRON REBAR STAKE
  - = FOUND CONCRETE COUNTY MONUMENT
  - (xxx) = RECORDED AS

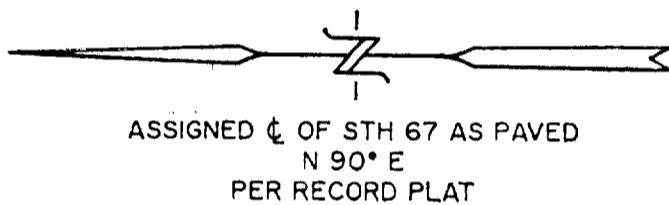

3. The land referred to in the Commitment is described as follows:

Lot 1 of Certified Survey Map No. 1102, according to the recorded plat thereof, recorded in Volume 5 of Certified Surveys on page 112 as Document No. 65465, located in the NE 1/4 and NW 1/4 of the NE 1/4 of Section 34, T1N, R15E, Walworth County, Wisconsin. Together with an easement for septic system over and across "Parcel A" as described in easement agreement recorded August 21, 1989 in Volume 465 on page 192 as Document No. 182283.

Tax Key Number: AA 1102 00001

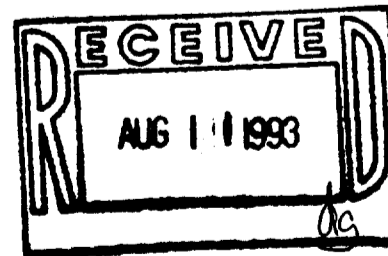


NOTE: COPIES OF THIS MAP TO WHICH THE FOLLOWING CERTIFICATE WILL APPLY ARE BLUE LINE PRINTS SHOWING SURVEYOR'S ORIGINAL SEAL AND SIGNATURE IN BLACK INK. COPIES BY ANY OTHER MEANS MAY HAVE ALTERATIONS WHICH DO NOT REPRESENT THE SURVEYOR'S WORK PRODUCT.

I HEREBY CERTIFY THAT THE ABOVE DESCRIBED PROPERTY HAS BEEN SURVEYED UNDER MY DIRECTION AND THAT THE ABOVE MAP IS A TRUE REPRESENTATION THEREOF AND SHOWS THE SIZE AND LOCATION OF THE PROPERTY, ITS EXTERIOR BOUNDARIES, THE LOCATION OF ALL VISIBLE STRUCTURES AND DIMENSIONS OF ALL PRINCIPAL BUILDINGS THEREON, BOUNDARY FENCES, APPARENT EASEMENTS, ROADWAYS AND VISIBLE ENCROACHMENTS, IF ANY. THIS SURVEY IS MADE FOR THE USE OF THE PRESENT OWNERS OF THE PROPERTY, AND ALSO THOSE WHO PURCHASE, MORTGAGE, OR GUARANTEE THE TITLE THERETO WITHIN ONE YEAR FROM THE DATE HEREOF.

DATED: 06/25/93

*Peter S. Gordon*

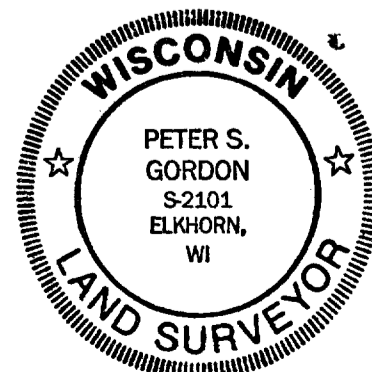

PLAT OF SURVEY  
 LOT 1 OF CSM # 1102  
 LOCATED IN THE NE & NW 1/4'S OF THE NE 1/4  
 SEC. 34, T. 1 N., R. 15 E.,  
 WALWORTH COUNTY, WISCONSIN

WORK ORDERED BY: ACTION REALTY  
 FOR KAREN ARLEN  
 W. 8203 RT 67  
 SHARON, WI.

**FARRIS, HANSEN & ASSOCIATES, INC.**  
 Engineering, Architecture, Surveying  
 7 Ridgway Court P.O. Box 437  
 ELKHORN, WISCONSIN 53121  
 Office: (414) 723-2098  
 Fax: (414) 723-5886

| REVISIONS |  |
|-----------|--|
|           |  |
|           |  |

|            |          |
|------------|----------|
| PROJECT NO | 1758.93  |
| DATE       | 06/25/93 |
| SHEET NO.  | 1 OF 1   |