


ABELL  
SURVEYING & MAPPING  
1140 SEQUOIA STREET • DELAVAN, WISCONSIN 53115  
262-728-6737



NOTE: BEARINGS ARE REFERENCED TO  
CERTIFIED SURVEY NO. 1755.

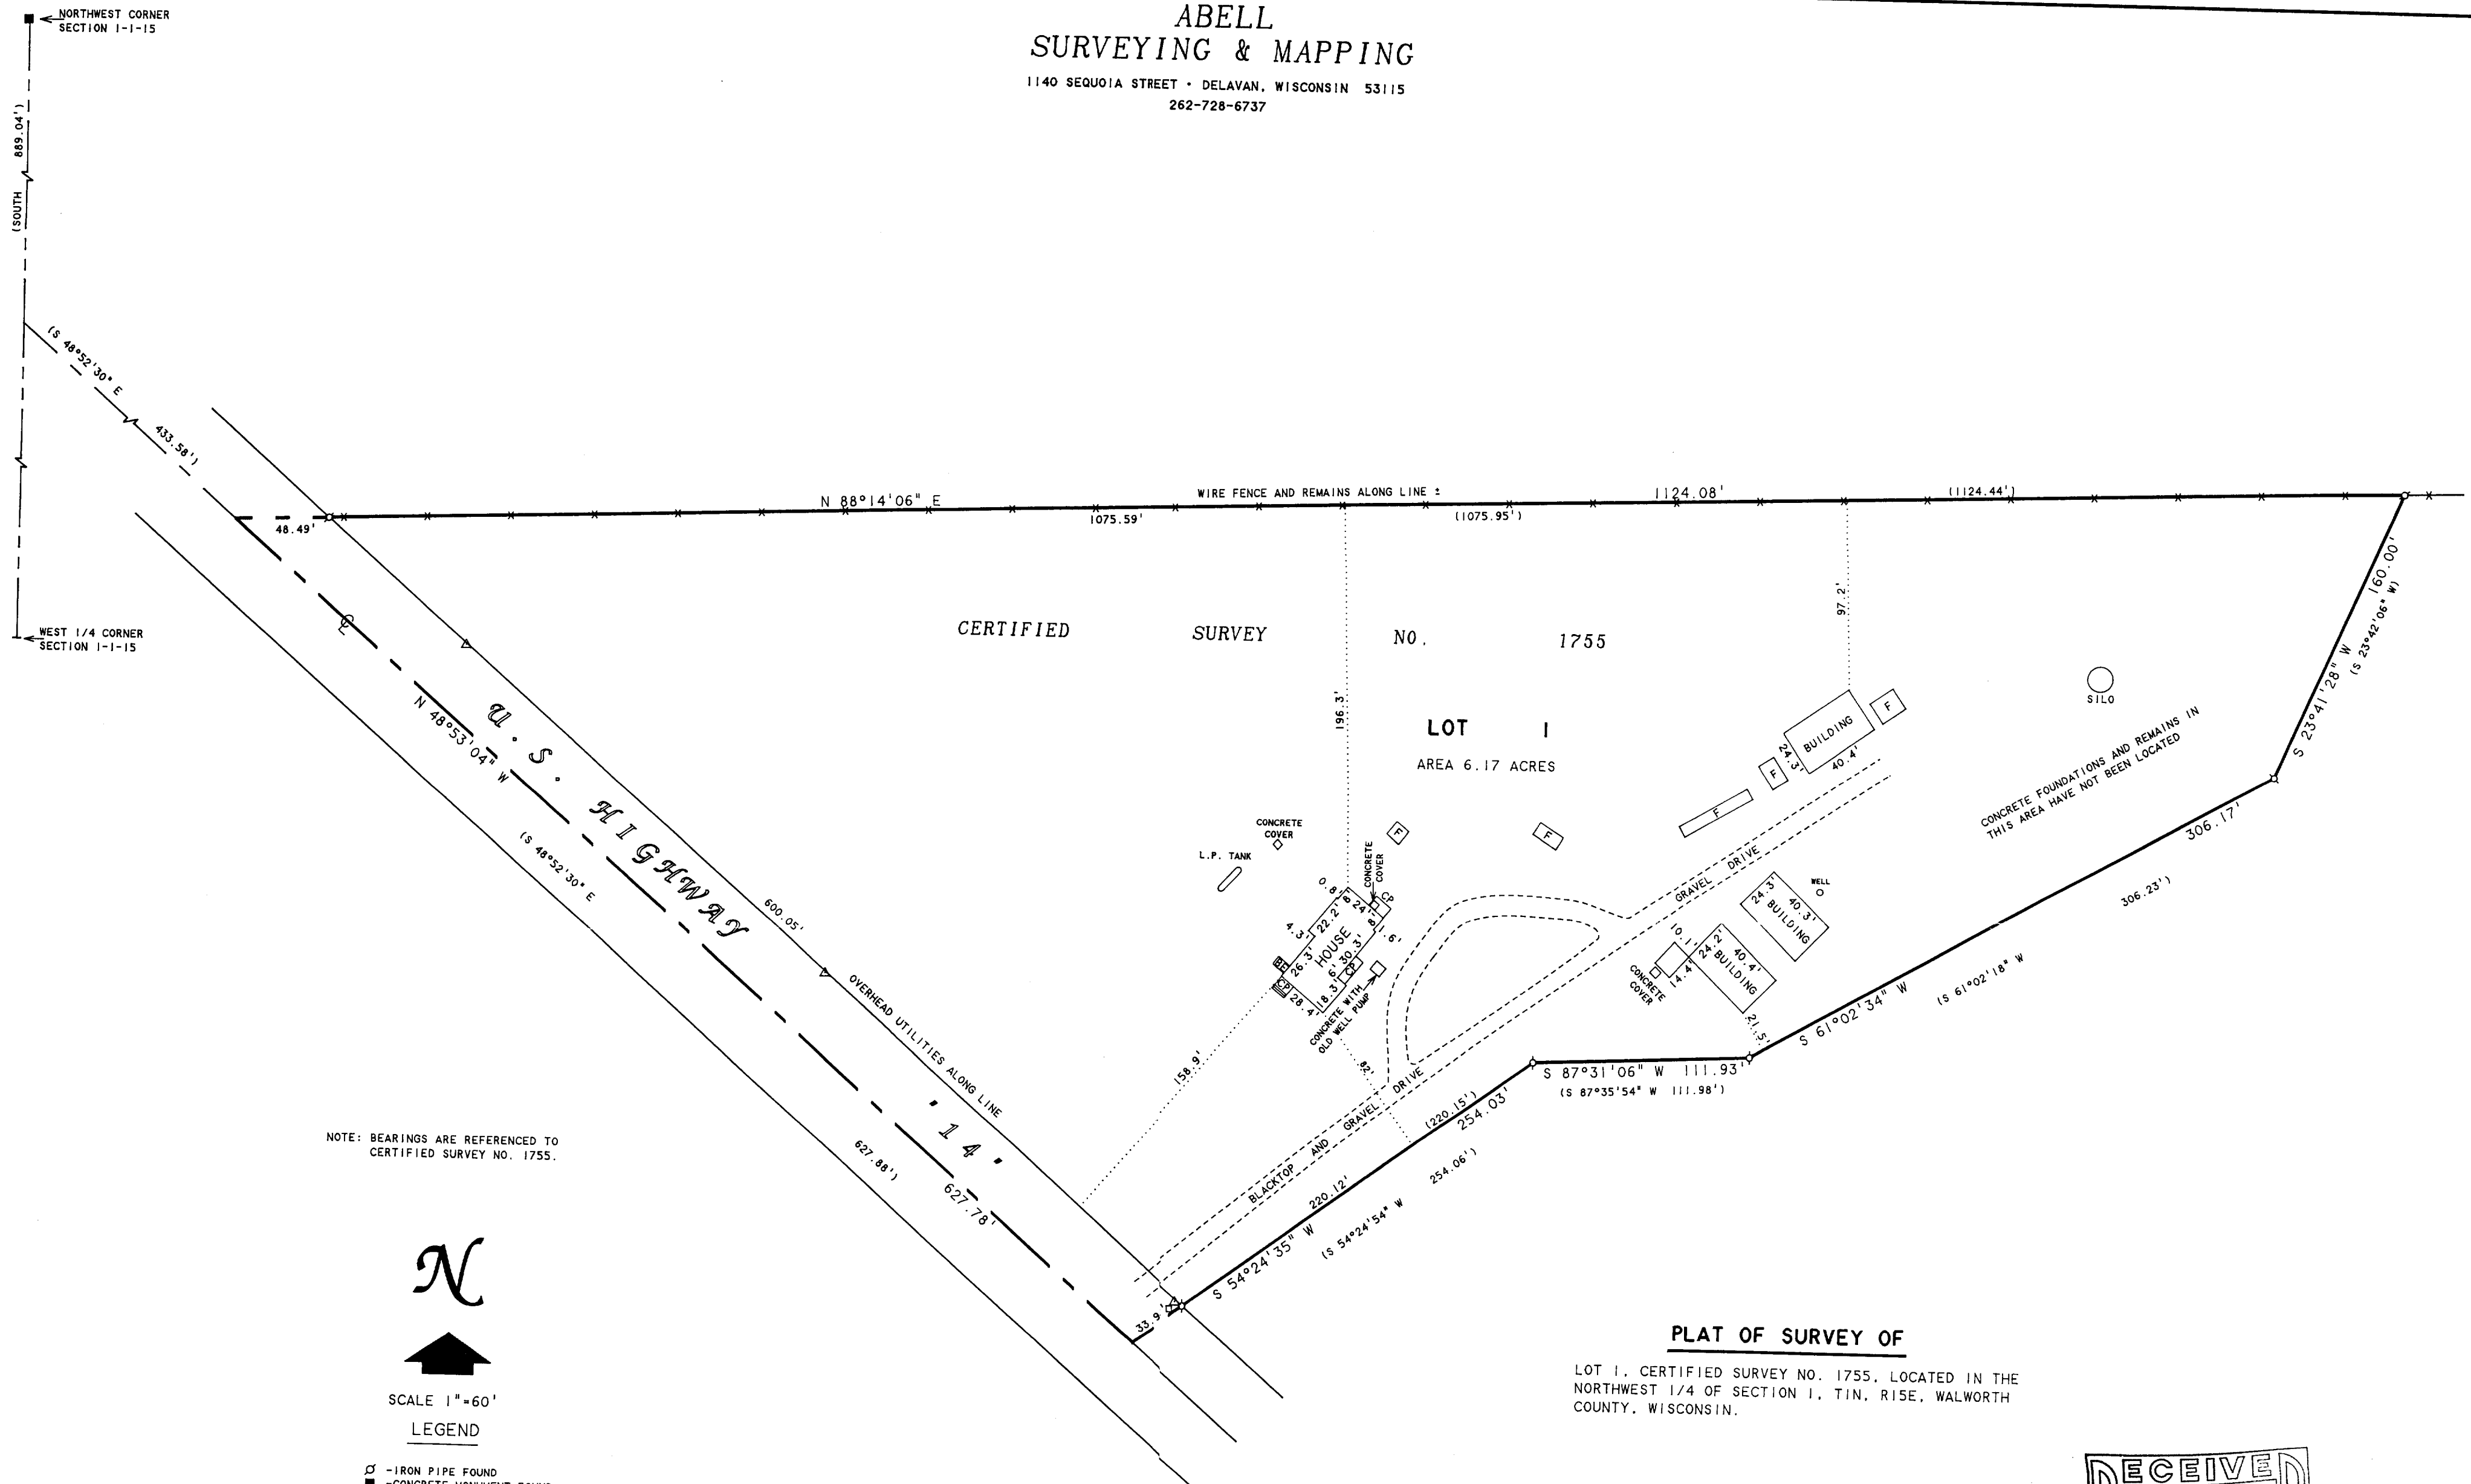


SCALE 1"=60'

LEGEND

- - IRON PIPE FOUND
- - CONCRETE MONUMENT FOUND
- CP - CONCRETE PORCH
- BE - BASEMENT ENTRY
- △ - UTILITY POLE
- \* - WIRE FENCE
- - UTILITY PED.
- [F] - CONCRETE FOUNDATION
- ( ) - RECORDED AS

PLAT OF SURVEY OF

LOT 1, CERTIFIED SURVEY NO. 1755, LOCATED IN THE  
NORTHWEST 1/4 OF SECTION 1, T1N, R15E, WALWORTH  
COUNTY, WISCONSIN.

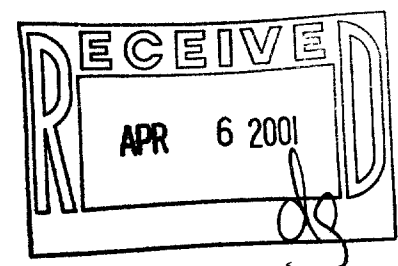

I HEREBY CERTIFY THAT I HAVE SURVEYED THE ABOVE DESCRIBED PROPERTY AND THAT THE  
ABOVE MAP IS A TRUE REPRESENTATION THEREOF AND SHOWS THE SIZE AND LOCATION OF  
THE PROPERTY, ITS EXTERIOR BOUNDARIES, THE LOCATION OF ALL VISIBLE STRUCTURES  
AND DIMENSIONS OF ALL PRINCIPAL BUILDINGS THEREON, BOUNDARY FENCES, APPARENT  
EASEMENTS, ROADWAYS AND VISIBLE ENCROACHMENTS, IF ANY, TO THE BEST OF MY  
KNOWLEDGE AND BELIEF.

THIS SURVEY IS MADE FOR THE USE OF THE PRESENT OWNERS OF THE PROPERTY, AND ALSO  
THOSE WHO PURCHASE, MORTGAGE, OR GUARANTEE THE TITLE THERETO WITHIN ONE (1) YEAR  
FROM DATE HEREON.

DAVID F. ABELL  
WISCONSIN REGISTERED LAND SURVEYOR, S-1596

ORDERED BY: CLAIR LAW OFFICE  
P.O. BOX 445  
DELAVAN, WI 53115

November 29, 2000

DATE: November 29, 2000  
JOB NUMBER: 00188  
NOTE: THIS IS NOT A CERTIFIED COPY UNLESS SEALED.

AA-1755-1

115-249