

ABERNATHY and ASSOCIATES

Kenneth B. Abernathy Jr.

Wisconsin Registered Land Surveyor S-1594


Rt. 3, Box 273  
Elkhorn, Wisconsin 53121  
Phone: (414) 723-4260 (office)  
(414) 723-7209 (FAX)

PLAT OF SURVEY


LOT 2 OF CERTIFIED SURVEY MAP NO. 1822, LOCATED IN THE NE 1/4 OF THE NW 1/4 OF SECTION 29, TOWN 1 NORTH, RANGE 15 EAST, SHARON TOWNSHIP, WALWORTH COUNTY, WISCONSIN.

ORDERED BY:  
JUDY HOWE  
PRUDENTIAL SELECT PROPERTIES  
623 W. MAIN ST.  
LAKE GENEVA, WI. 53147

OWNER: DENNIS A. SCHAFRIK

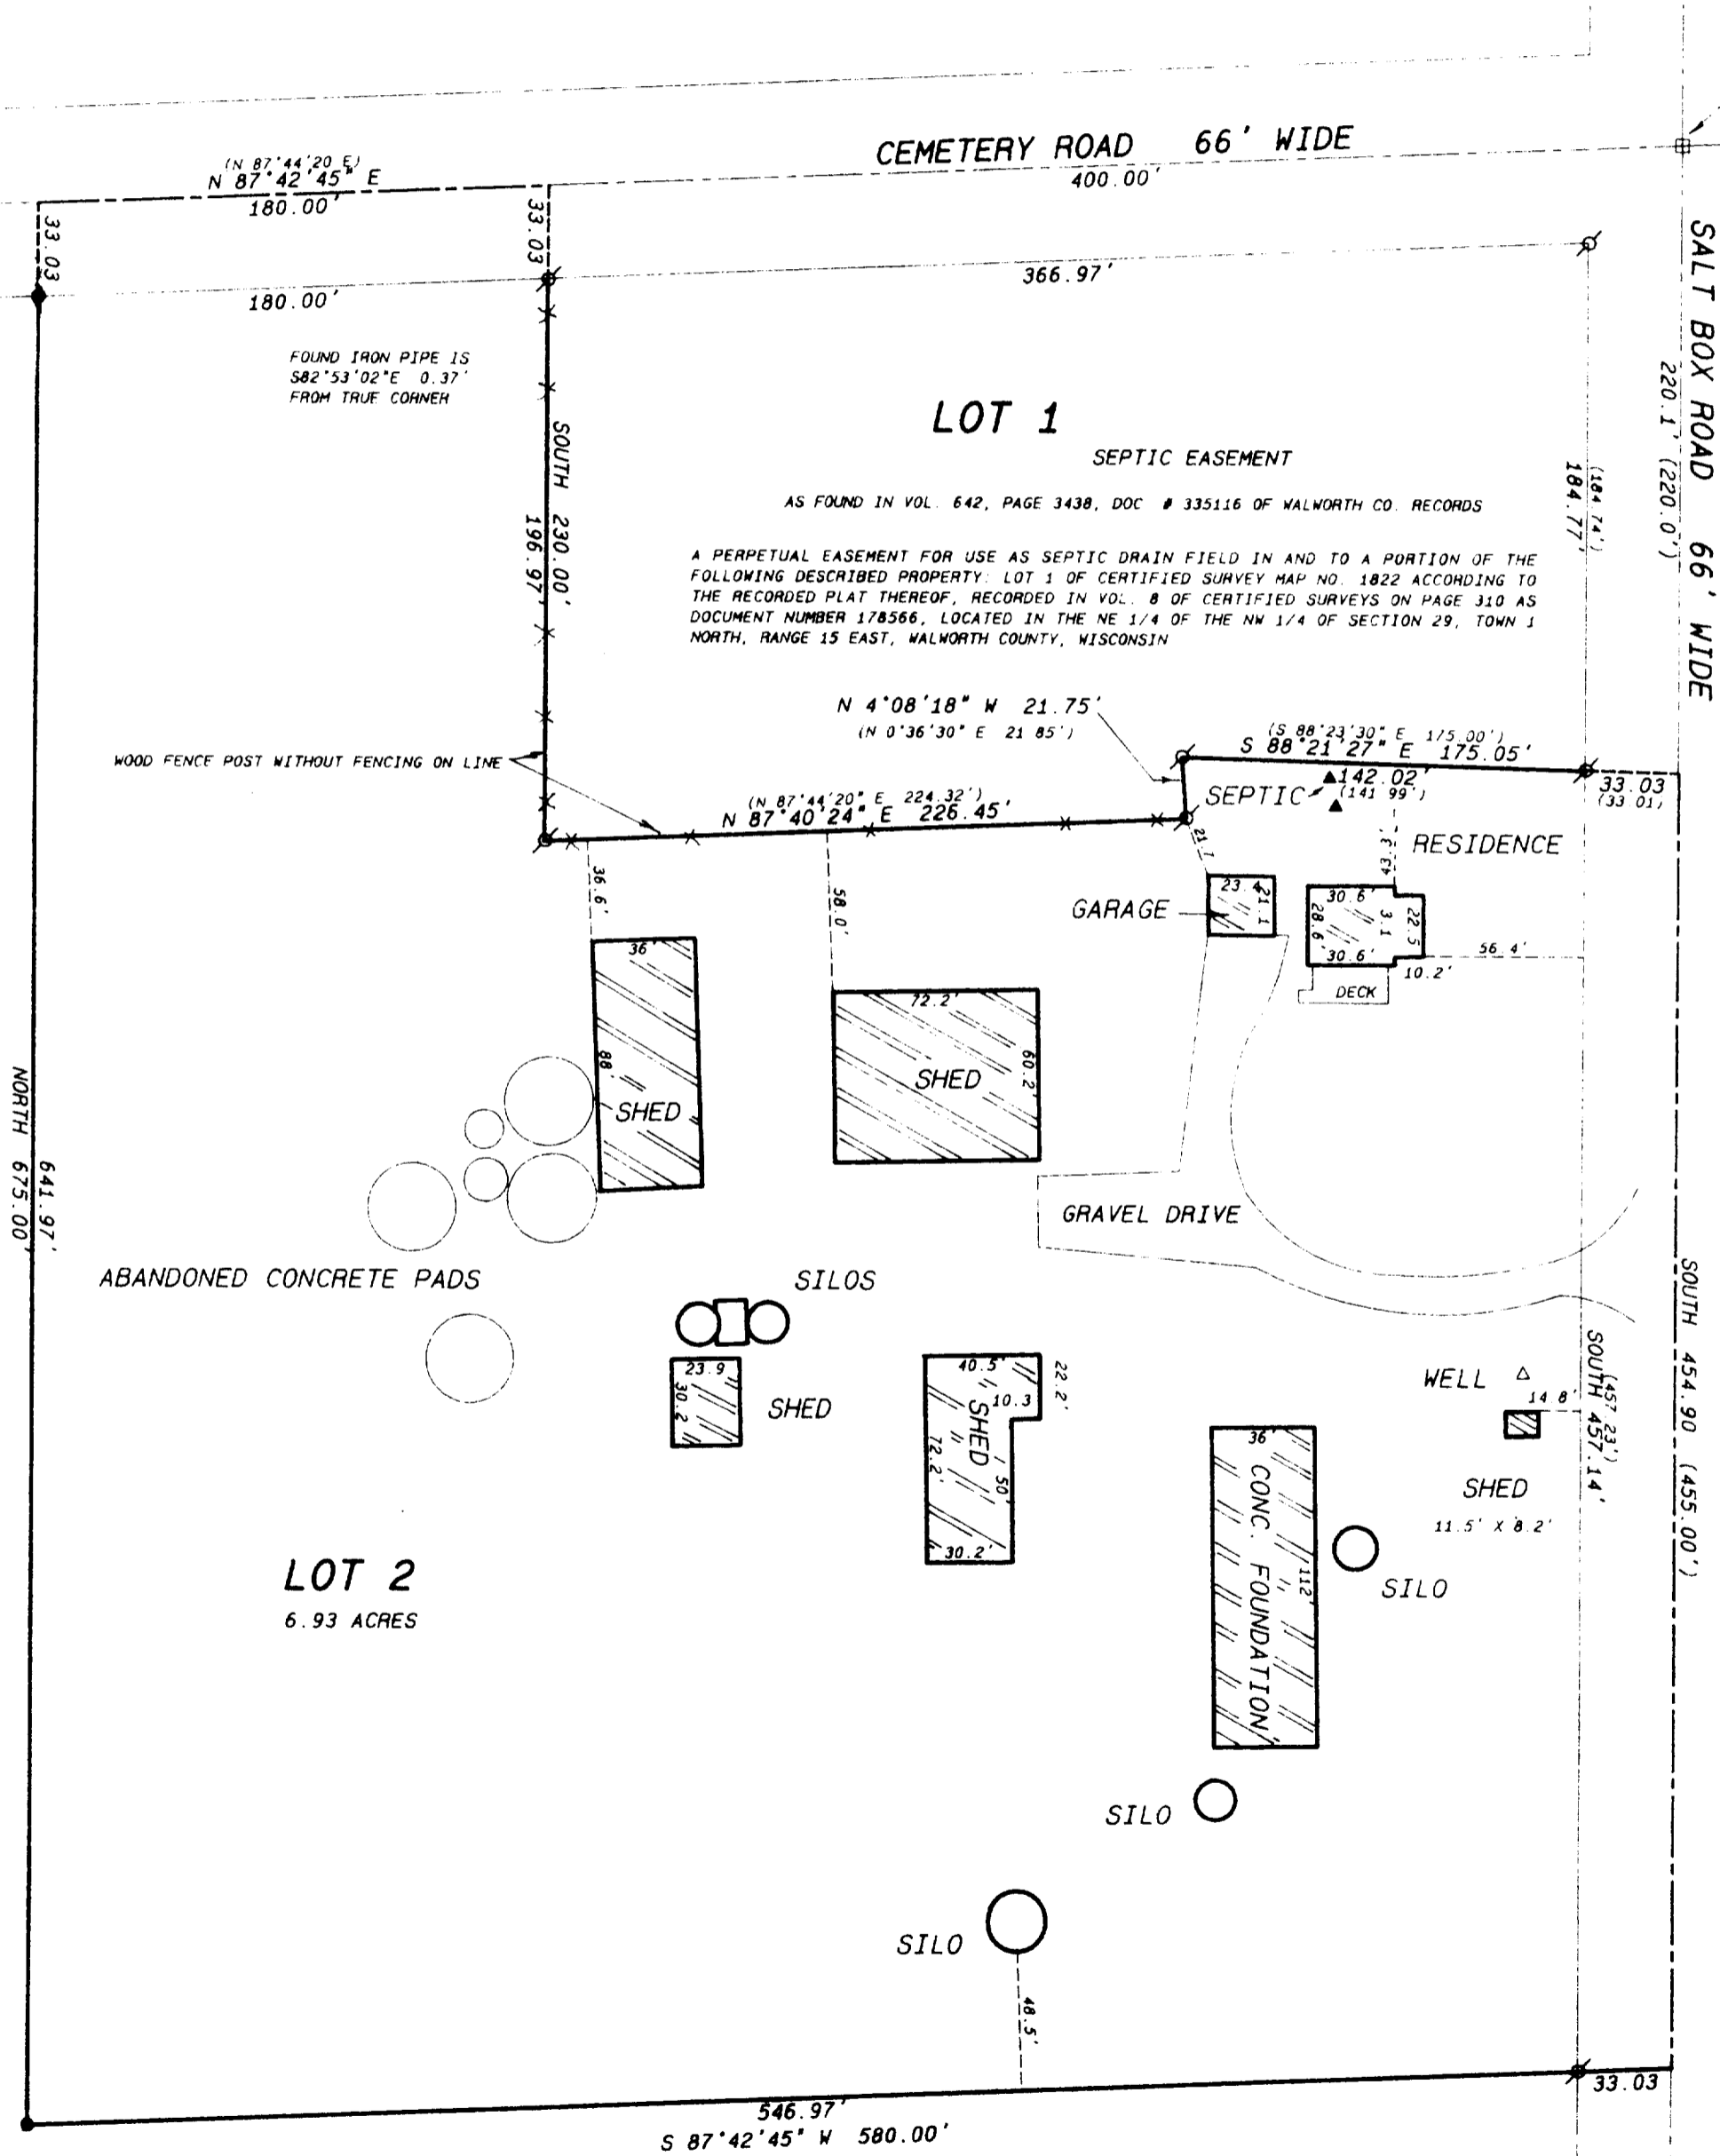


CEMETERY ROAD 66' WIDE  
SALT BOX ROAD 66' WIDE

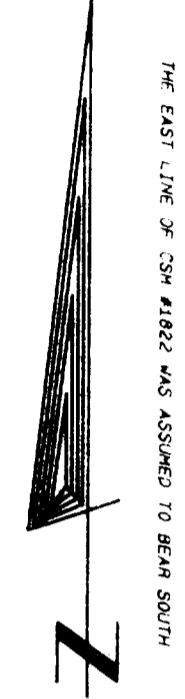

SCALE: 1 INCH = 60 FEET

Legend

- FOUND IRON PIPE
- FOUND IRON ROD
- FOUND BRASS CAPPED MONUMENT
- FOUND CONCRETE MONUMENT
- CHISEL CUT IN CONCRETE
- SET IRON ROD, 24" LONG, WEIGHING 1.5 LBS. LINEAL FT., 3/4" DIA.
- SET IRON ROD, 30" LONG, WEIGHING 4.5 LBS. LINEAL FT., 1 1/16" DIA.
- RECORDED AS DIMENSION
- EXISTING FENCE

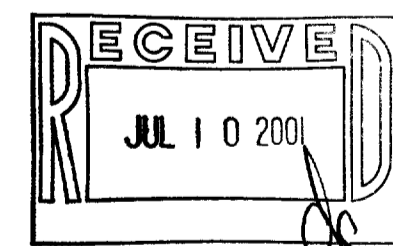

SCALE: 1" = 60 FEET

I hereby certify that the above described property has been surveyed by me in under my direction and that the above map is a true representation thereof and shows the size and location of the property, its exterior boundaries, the location of all visible structures and dimensions of all principal buildings thereon, boundary lines, adjacent easements, roadways and visible encroachments, if any.  
This survey is made for the use of the present owners of the property and also those who purchase, mortgage or otherwise acquire the title thereto within one year from date hereof.

*Kenneth B. Abernathy, Jr.*

KENNETH B. ABERNATHY, JR.  
WISCONSIN REGISTERED LAND SURVEYOR,  
S-1594

Date: MAY 21, 2001 Job No. 01.506

AA-1822-2 115-252