

ABELL
SURVEYING & MAPPING
1140 SEQUOIA STREET • DELAVAN, WISCONSIN 53115
262-728-6737


NOTE 1: BEARINGS ARE REFERENCED TO THE
WISCONSIN COORDINATE SYSTEM -
SOUTH ZONE.




SCALE 1"=100'

LEGEND

- Ø - IRON PIPE FOUND
- Δ - SOIL BORINGS
- () - RECORDED AS

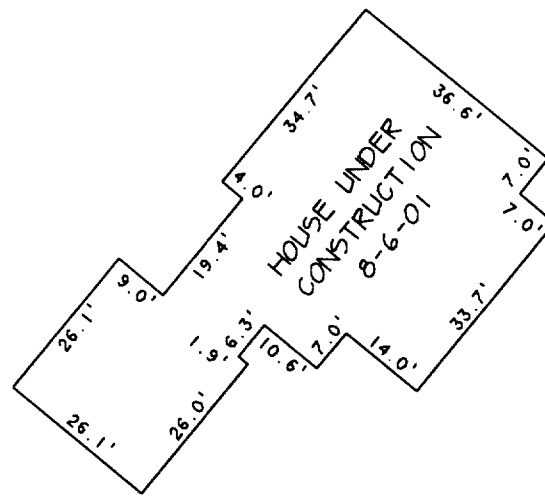

DETAIL SCALE 1"=30'

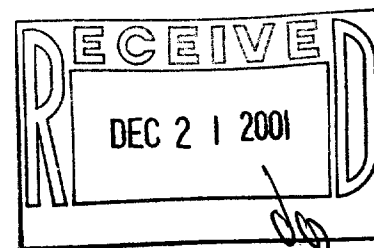

CERTIFIED SURVEY

LOT 1

LOT 2
AREA 8.05 ACRES

3228

HOUSE UNDER
CONSTRUCTION
8-6-01

POND

POLE BUILDING
UNDER
CONSTRUCTION
10-1-01

SEE DETAIL AT LEFT
FOR DIMENSIONS

50 FOOT WIDE EASEMENT FOR
EGRESS AND UTILITIES

15 FOOT WIDE
UTILITY EASEMENT

KOCH ROAD

I, DAVID F. ABELL, DO HEREBY CERTIFY THAT I HAVE SURVEYED THE PROPERTY HEREON
DESCRIBED ACCORDING TO THE OFFICAL RECORDS AND THAT THE PLAT HEREON IS A
CORRECT REPRESENTATION OF THE PROPERTY LINES TO THE BEST OF MY KNOWLEDGE AND
BELIEF.

David F. Abell

DAVID F. ABELL
WISCONSIN REGISTERED LAND SURVEYOR, S-1596

March 22, 2001

DATE JOB NUMBER - 00017E
NOTE: THIS IS NOT A CERTIFIED COPY UNLESS SEALED.

REVISED DATE: OCTOBER 1, 2001
REVISED TO SHOW POLE BUILDING
UNDER CONSTRUCTION.

REVISED DATE: AUGUST 6, 2001
REVISED TO SHOW HOUSE UNDER
CONSTRUCTION.

REVISED DATE: APRIL 2, 2001
REVISED TO SHOW NEW PROPOSED HOUSE
AND POLE BUILDING LOCATIONS.

ORDERED BY: LINDA HUGHES
P.O. BOX 125
RINGWOOD, IL 60072

PLAT OF SURVEY OF

LOT 2, CERTIFIED SURVEY MAP NO. 3228, LOCATED
IN THE SOUTHEAST 1/4 OF SECTION 22, T1N. R1E.
WALWORTH COUNTY, WISCONSIN.

AA-3228-2 115-257