

ABELL  
SURVEYING & MAPPING  
1140 SEQUOIA STREET • DELAVAN, WISCONSIN 53115  
262-728-6737

NOTE 1: BEARINGS ARE REFERENCED TO THE  
WISCONSIN COORDINATE SYSTEM -  
SOUTH ZONE.


N



SCALE 1"=100'

LEGEND

- Ø - IRON PIPE FOUND
- Δ - SOIL BORINGS
- ( ) - RECORDED AS

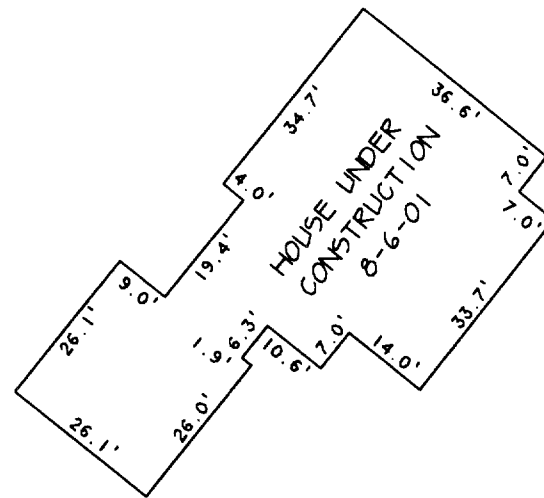

DETAIL SCALE 1"=30'


CERTIFIED SURVEY

MAP


NO.

LOT 2  
AREA 8.05 ACRES

3228

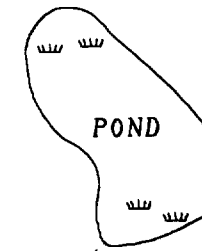


POND

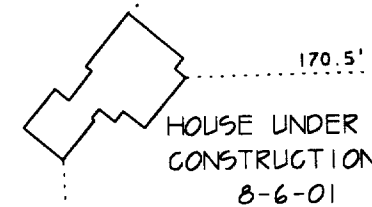

HOUSE UNDER  
CONSTRUCTION  
8-6-01

SEE DETAIL AT LEFT  
FOR DIMENSIONS

LOT 1

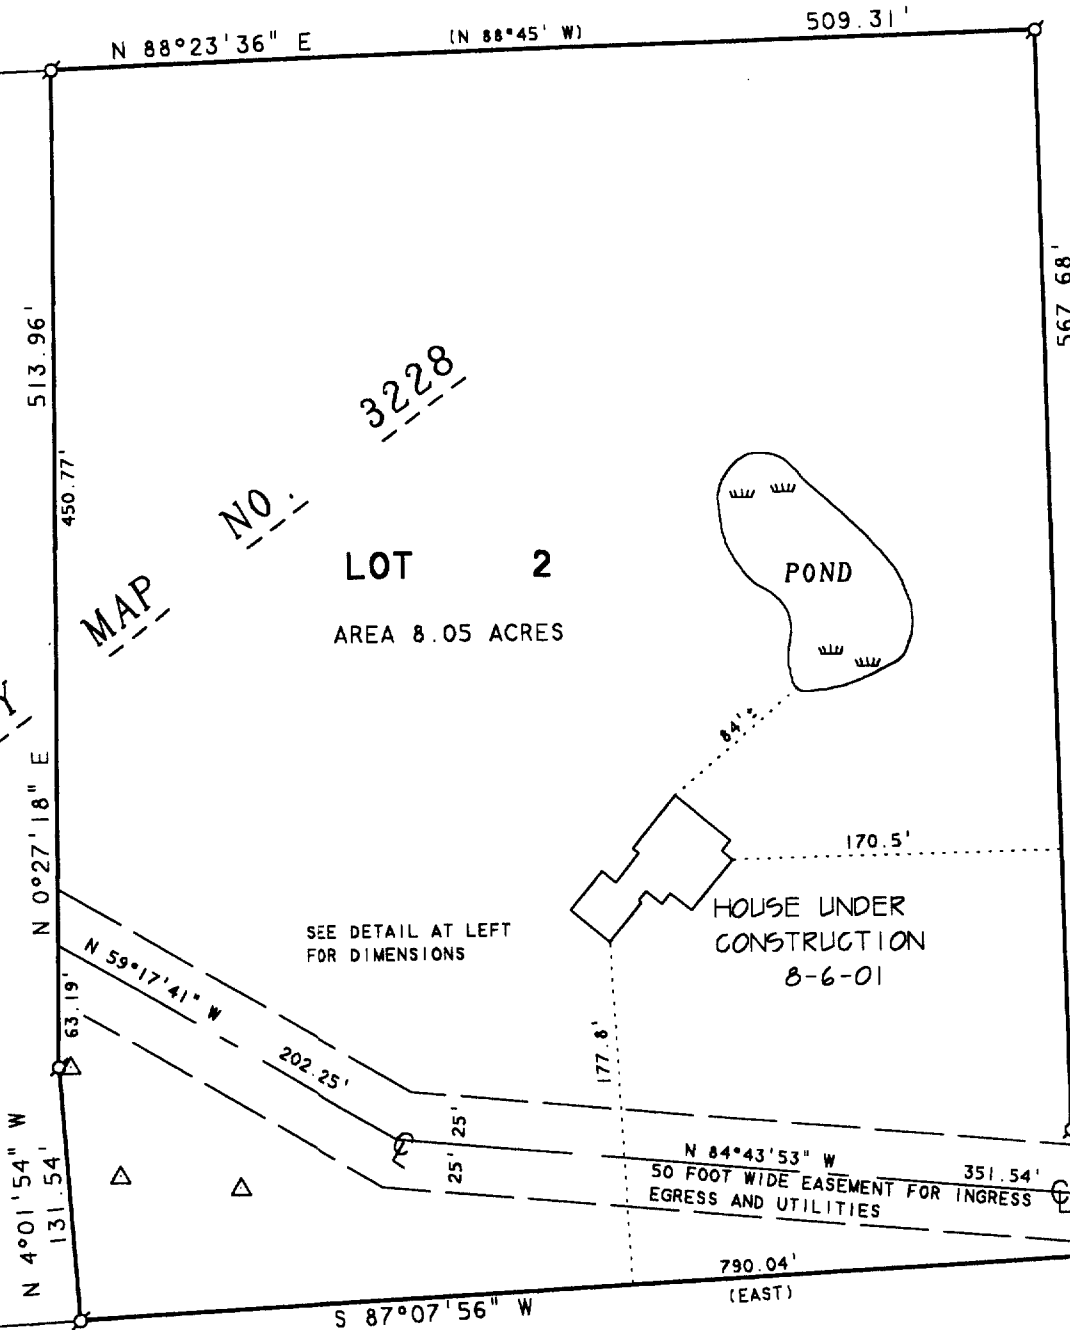

KOCH ROAD

I, DAVID F. ABELL, DO HEREBY CERTIFY THAT I HAVE SURVEYED THE PROPERTY HEREON DESCRIBED ACCORDING TO THE OFFICIAL RECORDS AND THAT THE PLAT HEREON IS A CORRECT REPRESENTATION OF THE PROPERTY LINES TO THE BEST OF MY KNOWLEDGE AND BELIEF.

*David F. Abell*

DAVID F. ABELL  
WISCONSIN REGISTERED LAND SURVEYOR, S-1596

March 22, 2001

DATE: March 22, 2001 JOB NUMBER - 00017C  
NOTE: THIS IS NOT A CERTIFIED COPY UNLESS SEALED.

REVISED DATE: AUGUST 6, 2001  
REVISED TO SHOW HOUSE UNDER  
CONSTRUCTION

REVISED DATE: APRIL 2, 2001  
REVISED TO SHOW NEW PROPOSED HOUSE  
AND POLE BUILDING LOCATIONS.

ORDERED BY: LINDA HUGHES  
P.O. BOX 125  
RINGWOOD, IL 60072

PLAT OF SURVEY OF

LOT 2, CERTIFIED SURVEY MAP NO. 3228, LOCATED  
IN THE SOUTHEAST 1/4 OF SECTION 22, T1N, R15E,  
WALWORTH COUNTY, WISCONSIN.

AA-3228-2v

115-260