


NORTHWEST CORNER
SECTION 12, T1N, R15E
FOUND BRASS CAP IN
CONCRETE MONUMENT

N.G.S. MONUMENT
STAMPED: S 78 1960
BRASS CAP IN CONCRETE
MONUMENT.
ELEVATION = 962.54'

RECEIVED
JAN 22 2012

WEST 1/4 CORNER
SECTION 12, T1N, R15E
FOUND BRASS CAP IN
CONCRETE MONUMENT

BEARINGS REFERENCED TO THE WISCONSIN
STATE PLANE COORDINATE SYSTEM,
SOUTH ZONE, NAD 27

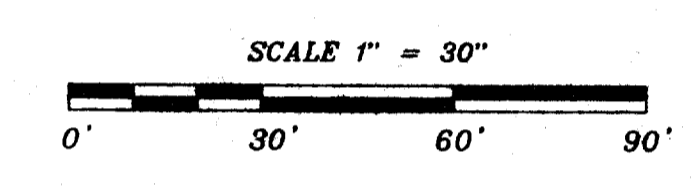


DESCRIPTION:
LOT 1, CERTIFIED SURVEY MAP NUMBER 1109,
LOCATED IN THE SOUTHWEST 1/4 OF THE
NORTHWEST 1/4, SECTION 12, T1N, R15E,
TOWN OF SHARON, WALWORTH COUNTY, WISCONSIN

LEGEND:
● IRON STAKE FOUND
○ MONITORING WELL
□ TELEPHONE PEDESTAL
○ UTILITY POLE

	NORTHING	EASTING	RIM	PVC	GROUND
MW1	207,587.33	2,356,392.95	960.53	960.33	
MW2	207,547.66	2,356,407.87	960.92	960.56	
MW3	207,619.17	2,356,471.30	961.21	961.07	958.76
CP1	207,500.54	2,356,388.48	TOP CONCRETE DIKE = 964.67'		
CP2	207,584.31	2,356,387.53	TOP CONCRETE DIKE = 964.68'		

NOTE: ELEVATIONS ON WELLS TAKEN ON NORTH RIM.

CP1 = CROSS ON TOP OF SOUTHEAST CORNER OF CONCRETE CONTAINMENT DIKE.
CP2 = CROSS ON TOP OF NORTHEAST CORNER OF CONCRETE CONTAINMENT DIKE.

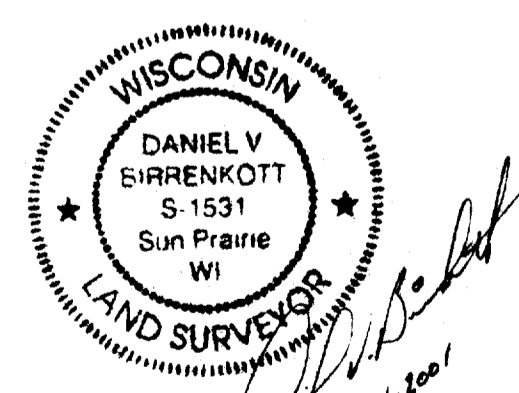

BIRRENKOTT SURVEYING INC.
LAND SURVEYING & PERC TESTING
P.O. BOX 237
1677 N. BRISTOL ST.
SUN PRAIRIE, WIS. 53590
(608) 837-7463
FAX (608) 837-1081

TOPOGRAPHIC SURVEY

NOVEMBER 12, 2001

SURVEYED BY M.K.
DRAWN BY M.K.
CHECKED BY S.O.
APPR'D BY D.V.B.

PREPARED FOR:
BT², INC.
2830 DAIRY DRIVE
MADISON, WI 53718-6751
(608) 224-2830

JOB NO. **011164**
SHEET 1 OF 1
FB 209/7-11

AA-1109-1 115-261