

\mathcal{N} 

LEGEND


NOTE: THIS SURVEY IS A RETRACEMENT OF
A SURVEY BY GEORGE T. DUNHAM DATED
MARCH, 1957.

STREET NAMES

100

1140 SEQUOIA STREET • DELAVAN, WISCONSIN 53115
262-728-6737

HUSTIS STREET
(HUSTIS EAST STREET)

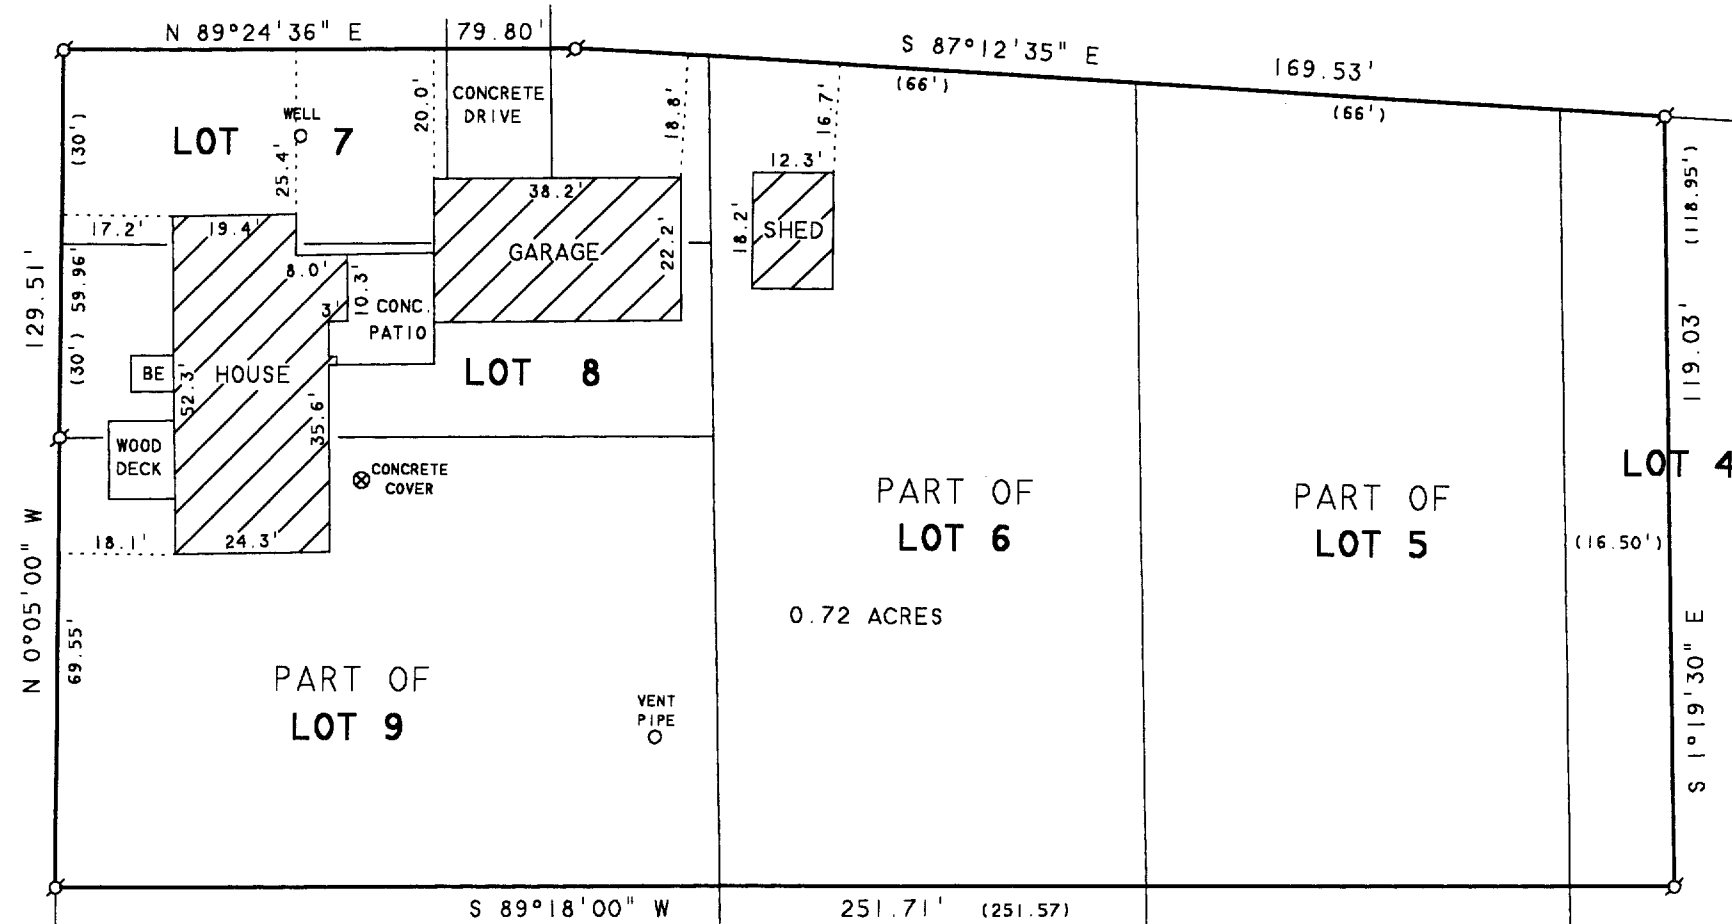

BLOCK

I HEREBY CERTIFY THAT I HAVE SURVEYED THE ABOVE DESCRIBED PROPERTY AND THAT THE ABOVE MAP IS A TRUE REPRESENTATION THEREOF AND SHOWS THE SIZE AND LOCATION OF THE PROPERTY, ITS EXTERIOR BOUNDARIES, THE LOCATION OF ALL VISIBLE STRUCTURES AND DIMENSIONS OF ALL PRINCIPAL BUILDINGS THEREON, BOUNDARY FENCES, APPARENT EASEMENTS, ROADWAYS AND VISIBLE ENCROACHMENTS, IF ANY, TO THE BEST OF MY KNOWLEDGE AND BELIEF.

THIS SURVEY IS MADE FOR THE USE OF THE PRESENT OWNERS OF THE PROPERTY, AND ALSO THOSE WHO PURCHASE. MORTGAGE. OR GUARANTEE THE TITLE THERETO WITHIN ONE (1) YEAR FROM DATE HEREON.

David F. Rhell

DAVID F. ABELL
WISCONSIN REGISTERED LAND SURVEYOR. S-1596

DATE January 16, 2002

DATE 1/1/79 JOB NUMBER - 02005
NOTE: THIS IS NOT A CERTIFIED COPY UNLESS SEALED.

AAC-181 115-266