
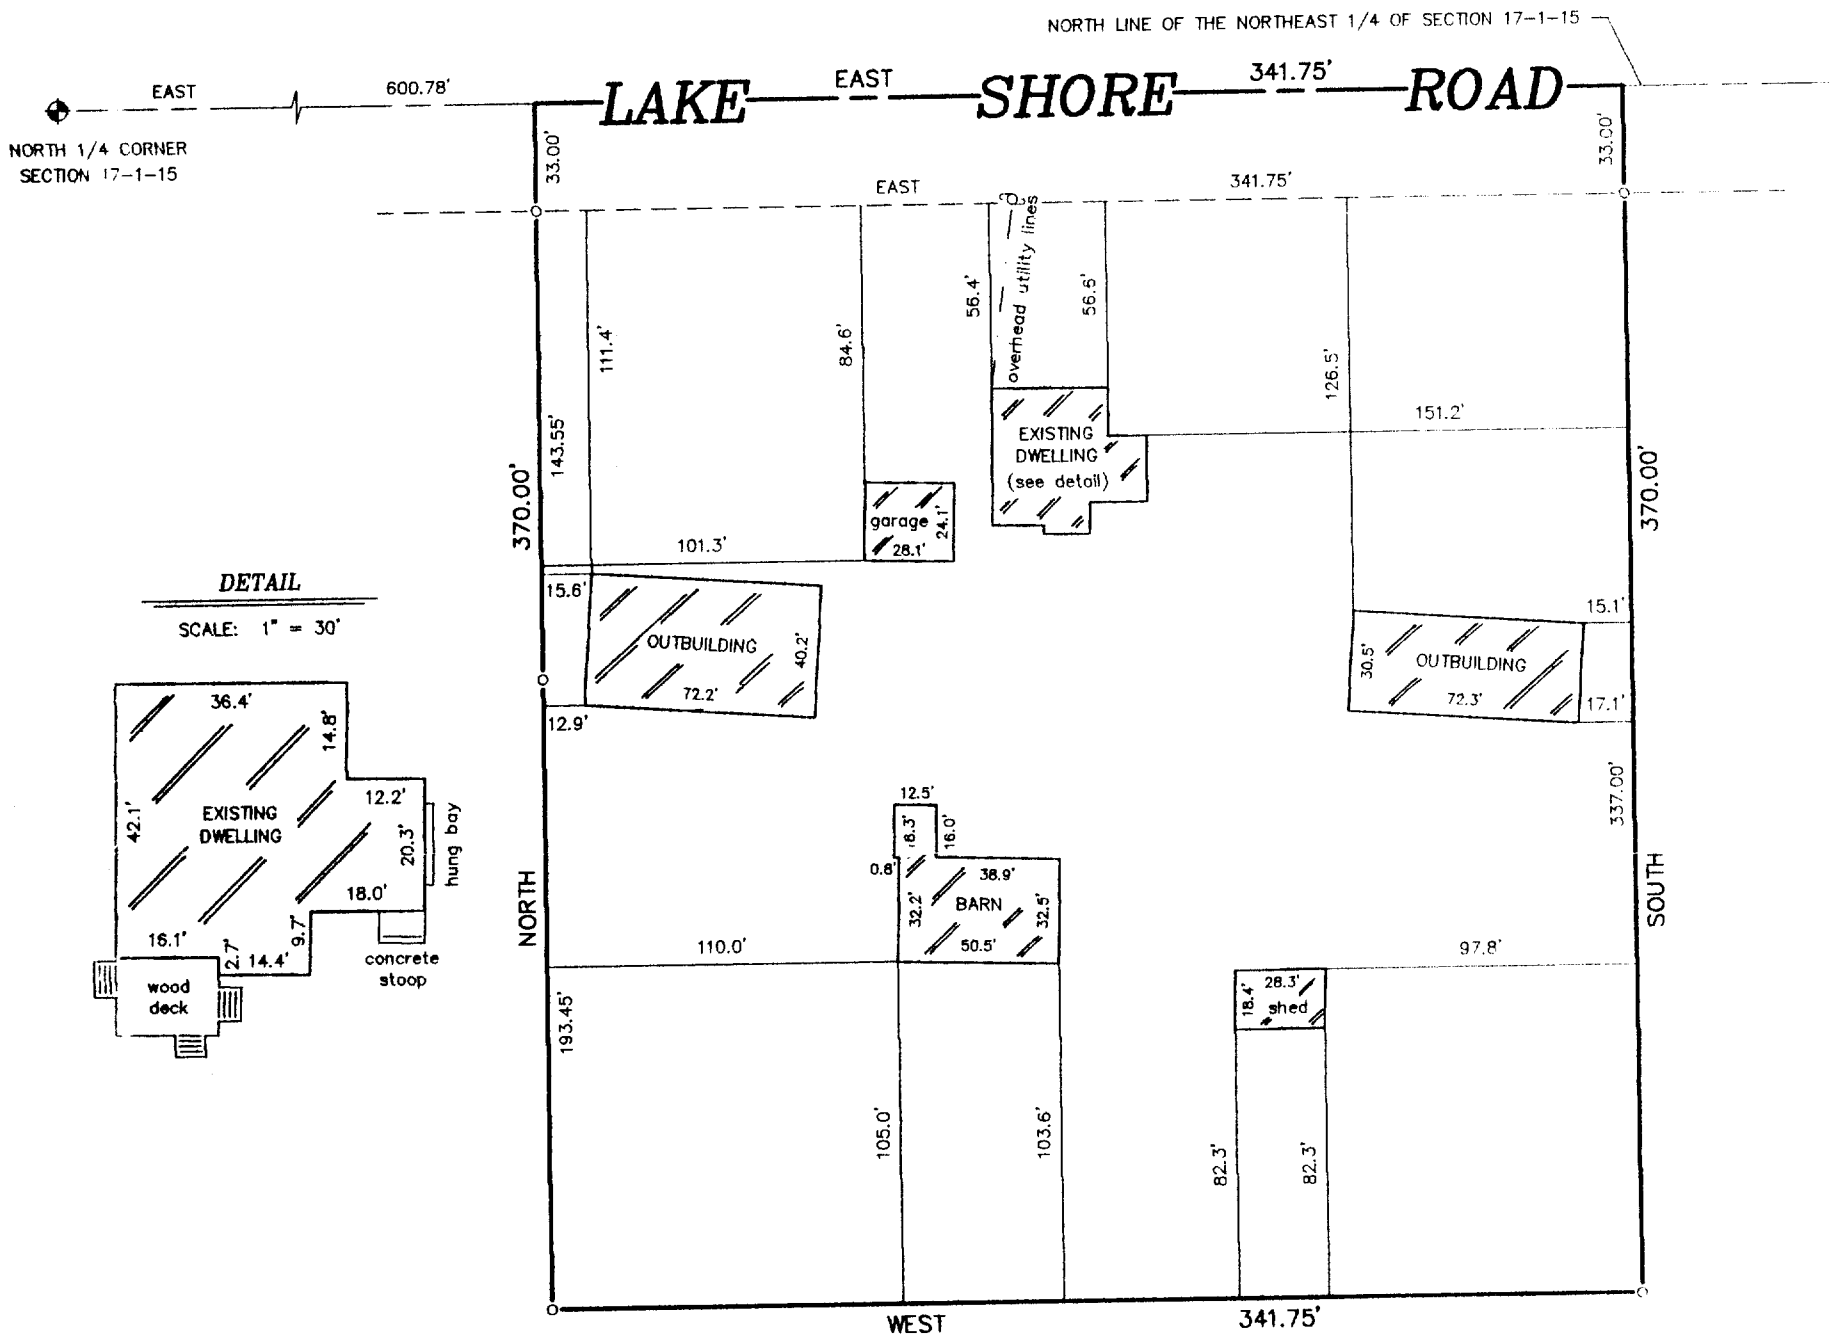


PLAT OF SURVEY

-OF-


LOT 1, CERTIFIED SURVEY MAP NO. 68 ACCORDING TO THE RECORDED PLAT THEREOF, RECORDED IN VOLUME 1 OF CERTIFIED SURVEYS ON PAGE 68 AS DOCUMENT NO. 637388, LOCATED IN THE NORTHEAST 1/4 OF SECTION 17, TOWNSHIP 1 NORTH, RANGE 15 EAST, TOWN OF SHARON, WALWORTH COUNTY, WISCONSIN.

SURVEY FOR: RE/MAX GENEVA REALTY, LTD.
 SURVEY LOCATION: W9043 LAKE SHORE ROAD

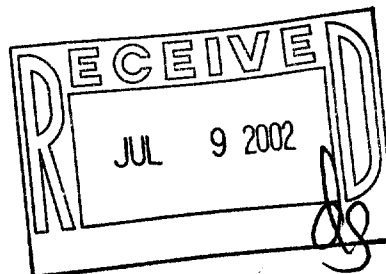

DETAIL

SCALE: 1" = 30'

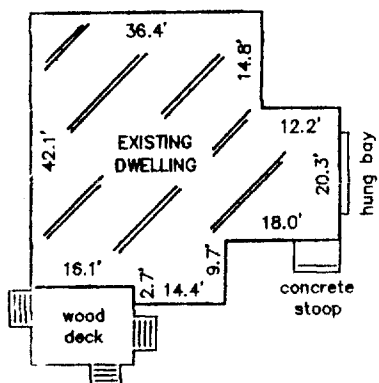

Note: Concrete slabs, aprons, etc. were not located.


LEGEND

- ◆ FOUND STANDARD WALWORTH COUNTY MONUMENT
- FOUND IRON PIPE
- SET IRON PIPE
- ⊕ UTILITY POLE


"I hereby certify that I have surveyed the above described property and that the above map is a correct representation thereof and shows the size and location of the property, its exterior boundaries, the location of all visible structures and dimensions of all principal buildings thereon, boundary fences, apparent easements, roadways and encroachments, if any."

"This survey is made for the use of the present owners of the property, and those who purchase, mortgage, or guarantee the title thereto within one year from date hereof."

SCALE: 1" = 60'

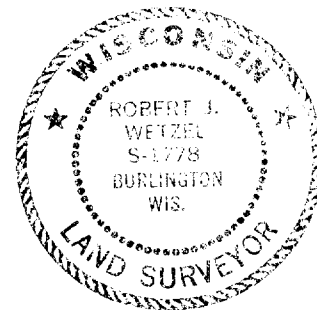

THIS IS NOT AN ORIGINAL PRINT UNLESS THIS SEAL IS RED.

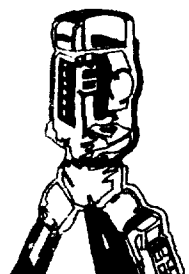

B.W. SURVEYING, INC.

LAND SURVEYS
 MAPPING AND PLANNING
 412 N. PINE STREET
 BURLINGTON, WI 53105
 (262)-767-0225

Robert J. Wetzel
 ROBERT J. WETZEL S-1778

MARCH 27, 2002
 DATE

5331
 JOB NUMBER

115-267