

Tax Parcel  
A S 1500003A

# Plat of Survey


of

Lot 1 of Certified Survey Map No. 3435,

recorded in Vol. 20 of Certified Survey Maps of Walworth County on Page 16 and located in the Southeast 1/4 of the Southwest 1/4 of Section 15, Town 1 North, Range 15 East, Town of Sharon, Walworth County, Wisconsin.

Surveyed for: **Duane Shores**  
N1345 Peters Road  
Sharon, Wisconsin. 53585

Survey Date: July 23, 2003.  
Revisions:

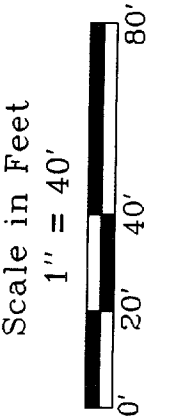




**Jensen & Olson Land Surveying, LLC**  
45 South Wisconsin Street P.O. Box 322  
Elkhorn, Wisconsin. 53121  
Telephone (262) 723-3434  
Facsimile (262) 723-8044

N1°04'53"W 524.00'

**Poured Concrete Foundation**

**Lot 1**  
5.397 Acres  
235,094 Sq.Ft.  
  
5.000 Acres  
217,800 Sq.Ft.  
Exclusive of R.O.W.

**Peters Road (66' Wide)**

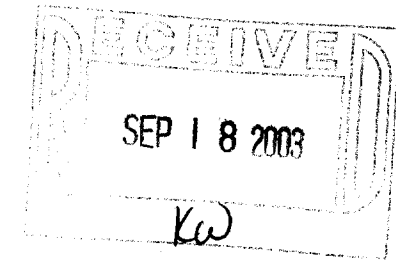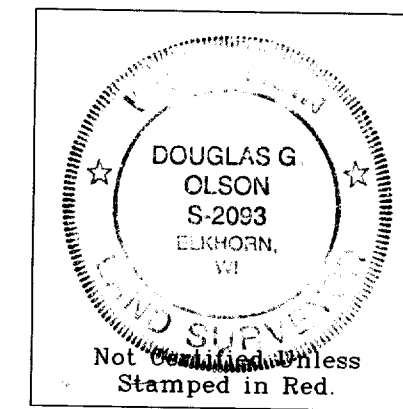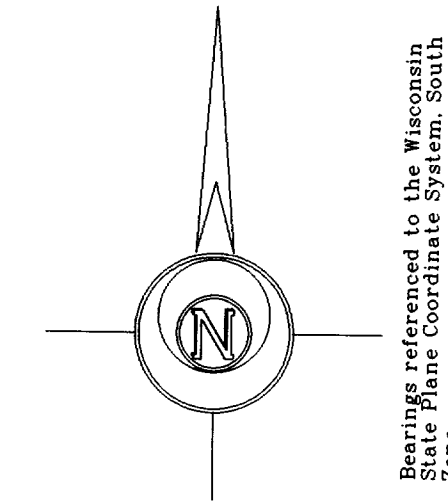

- Notes: 1) This survey plat is not certified unless signed and sealed in red ink.  
2) This survey is subject to Wisconsin lien laws. This Plat of Survey is the notice of intent to file lien. Lien waiver required.

Copyright © 2003 by Jensen & Olson Land Surveying, LLC.

All rights reserved. No part of this survey plat may be reproduced or transmitted in any form by any means - graphic, electronic, or mechanical, including photocopying, tracing, or information storage and retrieval systems - without permission in writing from Douglas G. Olson, Jensen & Olson Land Surveying, LLC.

I, Douglas G. Olson, Wisconsin Registered Land Surveyor, do hereby certify that this survey was performed by me or under my direction in full compliance with the owner's/agent's instructions and Chapter A-E 7 of the Wisconsin Administrative Code "Minimum Standards for Property Surveys"; and that this map is an accurate representation thereof to the best of my knowledge and belief.

Douglas G. Olson  
Wisconsin Registered Land Surveyor - 2093

- Legend**
- Found County Section Corner
  - Found Iron Rod, 3/4" dia.
  - ( ) Recorded Information
  - Concrete Cover
  - PVC Pipe
  - Utility Pole
  - Utility Pedestal
  - Asphalt Surface
  - Gravel

Sheet 1 of 1 Sheets  
Job Reference Number  
**2003.104**

2003.104

AA3435-1

115-288