


ABELL
SURVEYING & MAPPING


1140 SEQUOIA STREET • DELAVAN, WISCONSIN 53115
262-728-6737

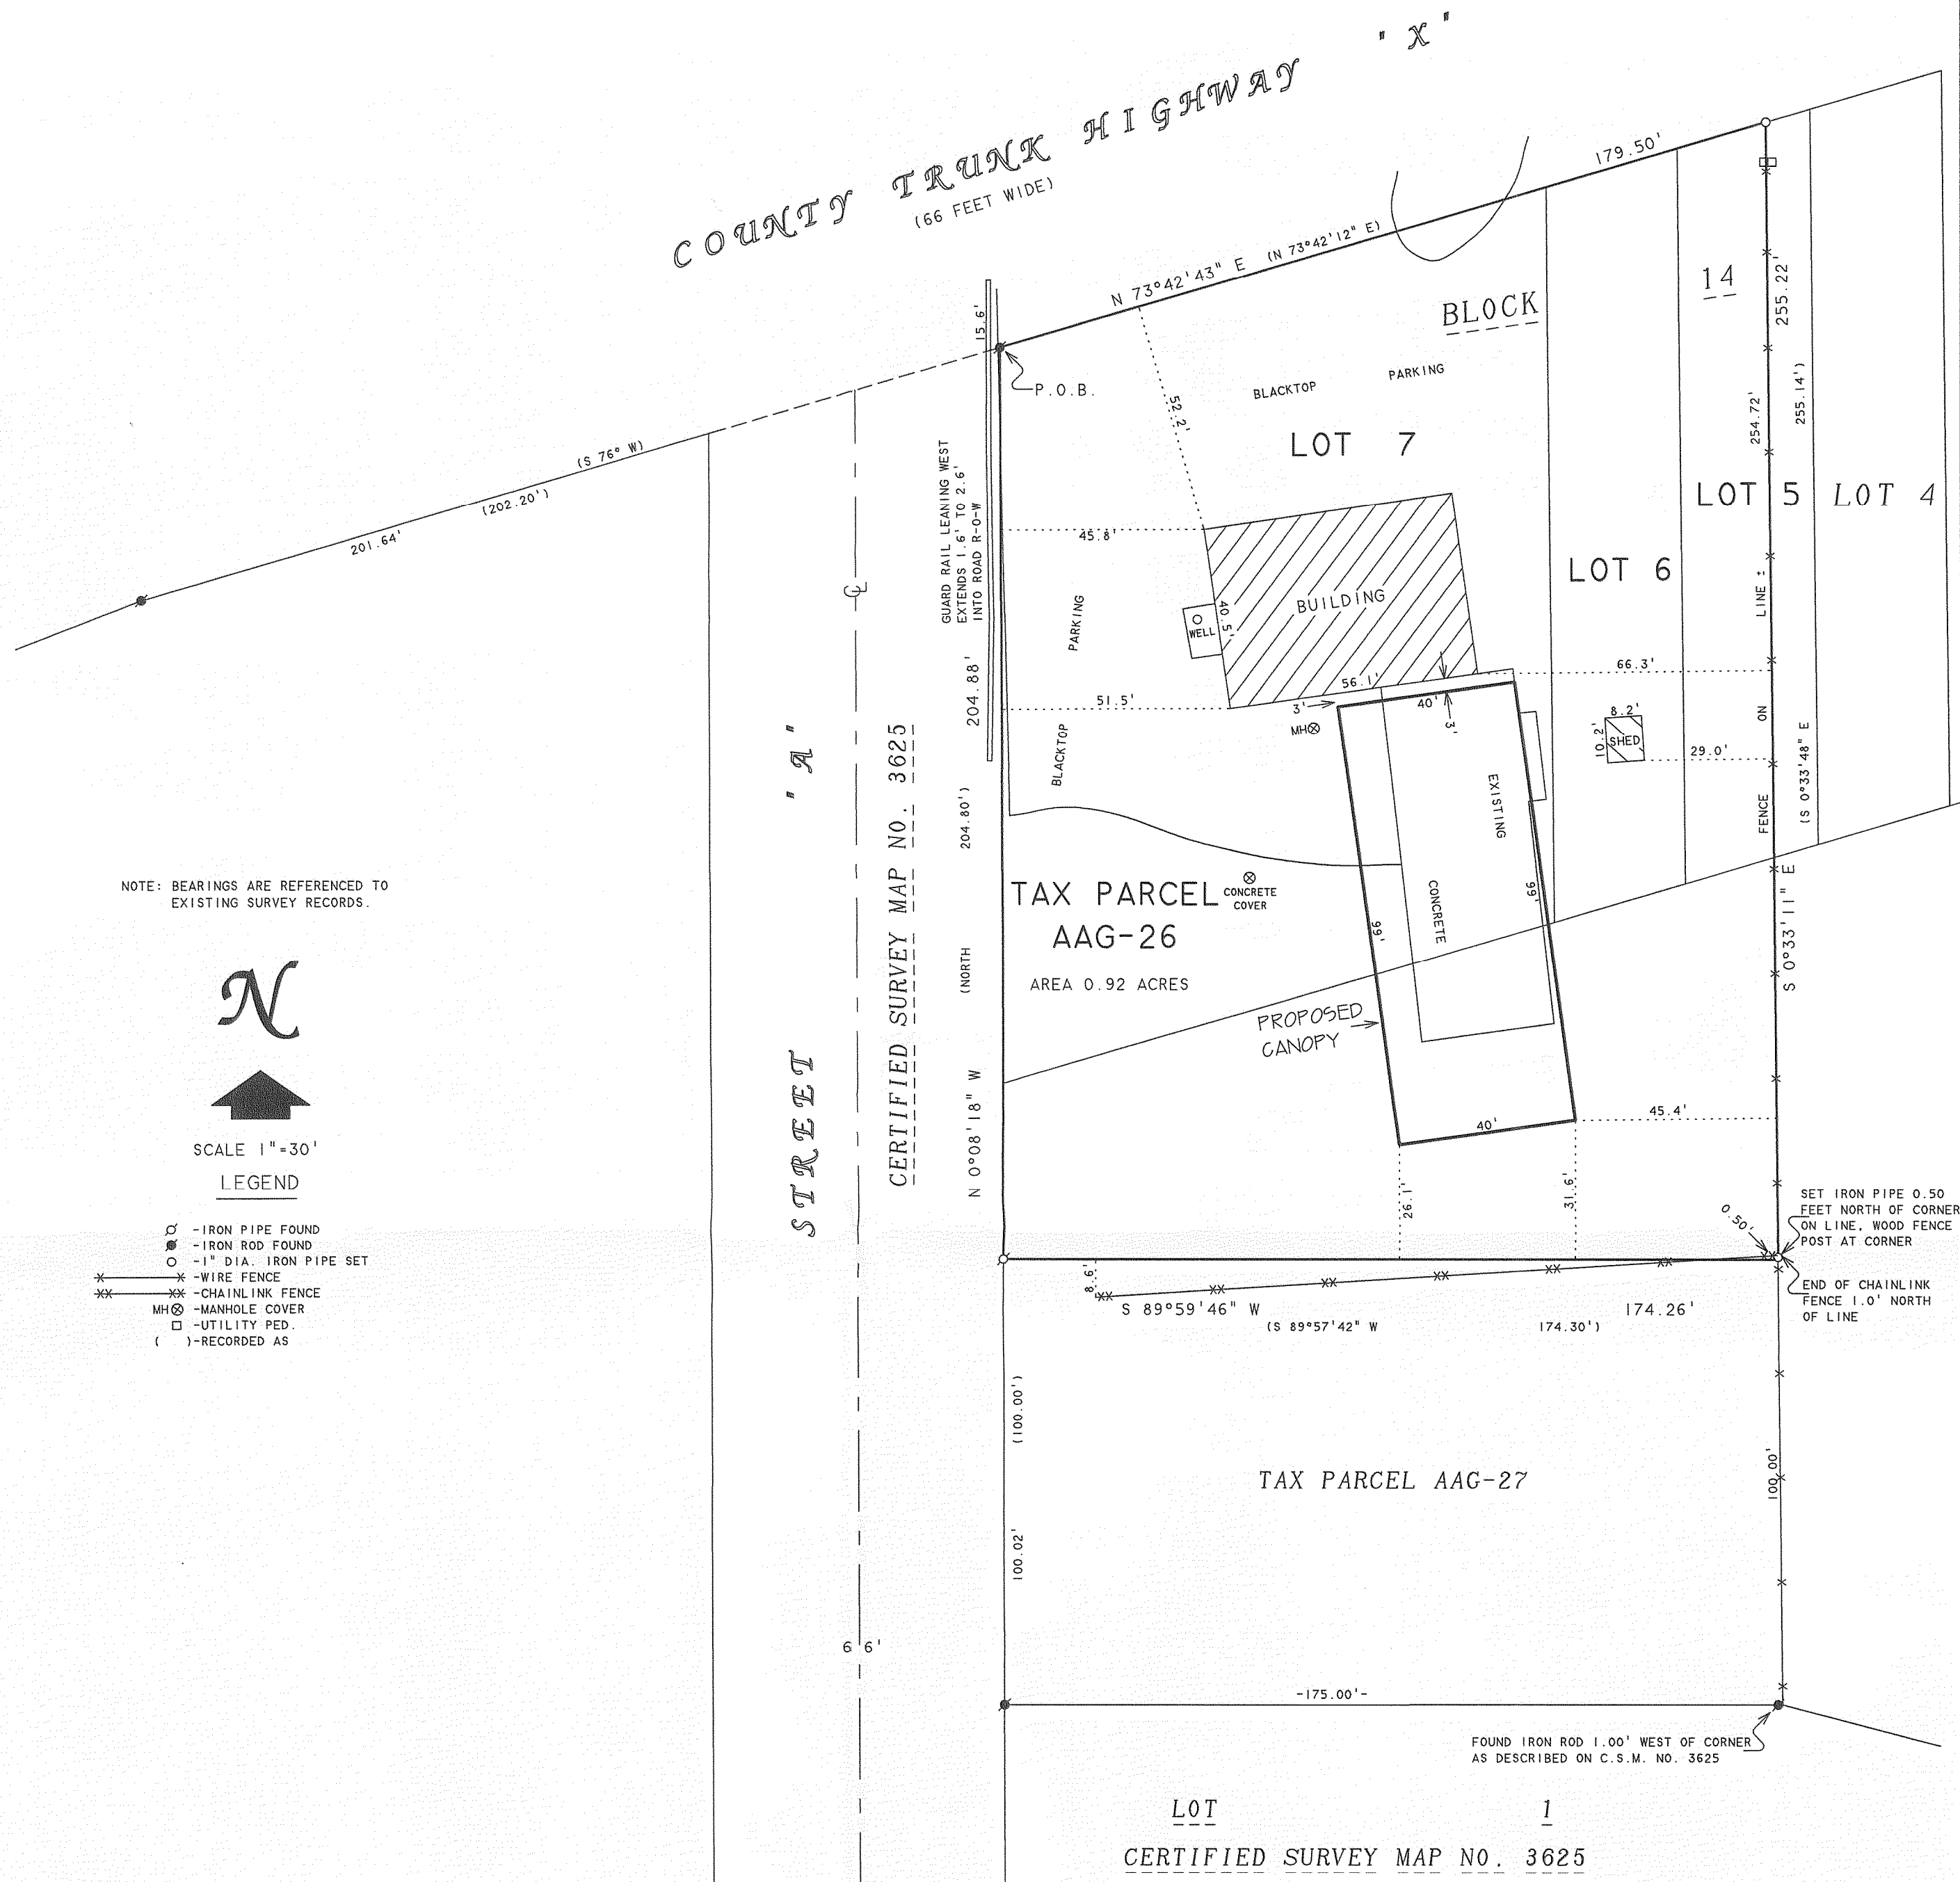

PLAT OF SURVEY OF

WARRANTY DEED, VOLUME 666, PAGE 5309
DOCUMENT NUMBER 426242

A PARCEL OF LAND LOCATED IN BLOCK 14 OF THE VILLAGE OF ALLEN'S GROVE, IN SECTION 6, T1N, R15E, WALWORTH COUNTY WISCONSIN AND DESCRIBED AS FOLLOWS: COMMENCING AT THE IRON PIPE ON THE SOUTHEASTERLY LINE OF COUNTY TRUNK HIGHWAY "X" AT THE NORTHEASTERLY CORNER OF CERTIFIED SURVEY MAP NO. 963, RECORDED IN VOL. 4 OF CERTIFIED SURVEY MAPS ON PAGE 222, AS DOCUMENT NO. 51028, WALWORTH COUNTY RECORDS: THENCE N 68°33'00" E ALONG THE SOUTHEASTERLY LINE OF SAID COUNTY TRUNK HIGHWAY "X", 708.37 FEET; THENCE N 73°42'12" E 202.20 FEET TO THE PLACE OF BEGINNING; THENCE CONTINUE N 73°42'12" E 179.50 FEET TO AN IRON PIPE LOCATED IN THE SOUTHERLY LINE OF SAID COUNTY TRUNK HIGHWAY "X" AND IN LINE WITH A FARM FENCE RUNNING IN A SOUTHERLY DIRECTION; THENCE S 0°33'48" E (PREVIOUSLY DESCRIBED AS S 2°40'E) ALONG SAID FENCE LINE 255.14 FEET TO AN IRON PIPE; THENCE S 89°57'42" W 174.30 FEET TO AN IRON PIPE; THENCE N 0°08'18" W 204.80 FEET TO THE PLACE OF BEGINNING. BEING PORTIONS OF LOTS 5, 6, AND 7 IN BLOCK 14 AND ADDITIONAL LANDS DIRECTLY SOUTH THEREOF, SITUATED IN THE COUNTY OF WALWORTH AND STATE OF WISCONSIN.

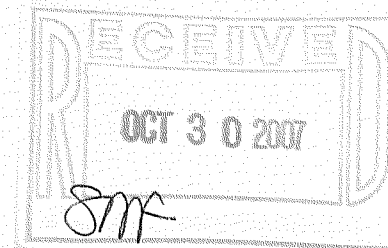

I HEREBY CERTIFY THAT I HAVE SURVEYED THE ABOVE DESCRIBED PROPERTY AND THAT THE ABOVE MAP IS A TRUE REPRESENTATION THEREOF AND SHOWS THE SIZE AND LOCATION OF THE PROPERTY, ITS EXTERIOR BOUNDARIES, THE LOCATION OF ALL VISIBLE STRUCTURES AND DIMENSIONS OF ALL PRINCIPAL BUILDINGS THEREON, BOUNDARY FENCES, APPARENT EASEMENTS, ROADWAYS AND VISIBLE ENCROACHMENTS, IF ANY, TO THE BEST OF MY KNOWLEDGE AND BELIEF.

THIS SURVEY IS MADE FOR THE USE OF THE PRESENT OWNERS OF THE PROPERTY, AND ALSO THOSE WHO PURCHASE, MORTGAGE, OR GUARANTEE THE TITLE THERETO WITHIN ONE (1) YEAR FROM DATE HEREON.

ORDERED BY: MIKE McFARLIN
9334 COUNTY ROAD X
DARIEN, WI 53114

David F. Abell

DAVID F. ABELL
WISCONSIN REGISTERED LAND SURVEYOR, S-1596

April 4, 2007

DATE: April 4, 2007 JOB NUMBER - 07018
NOTE: THIS IS NOT A CERTIFIED COPY UNLESS SEALED.

AAG-26

115-348