


PLAT OF SURVEY

LOT 1 OF CERTIFIED SURVEY MAP # 3935, RECORDED IN VOLUME 24, PAGES 106 THRU 109 OF CERTIFIED SURVEYS OF WALWORTH COUNTY, WISCONSIN, AS DOCUMENT NO. 676048, AND BEING LOCATED IN THE SW 1/4 OF THE NW 1/4 OF SECTION 27, T.1N., R.15E., OF THE 4TH P.M., TOWN OF SHARON, WALWORTH COUNTY, WISCONSIN.

STATE OF WISCONSIN
COUNTY OF ROCK SS.

I HEREBY CERTIFY THAT I HAVE SUPERVISED THE SURVEY OF THE PROPERTY DESCRIBED HEREON FOR THE EXCLUSIVE USE OF WELLNITZ & SAROW BUILDERS, INC. AND THAT TO THE BEST OF MY KNOWLEDGE AND BELIEF THE PLAT HEREON DRAWN CORRECTLY REPRESENTS SAID SURVEY AND ITS LOCATION.



GIVEN UNDER MY HAND AND SEAL THIS 9th DAY OF SEPTEMBER, 2009, AT JANESVILLE, WISCONSIN.
REVISED THIS 13TH DAY OF NOVEMBER, 2009.

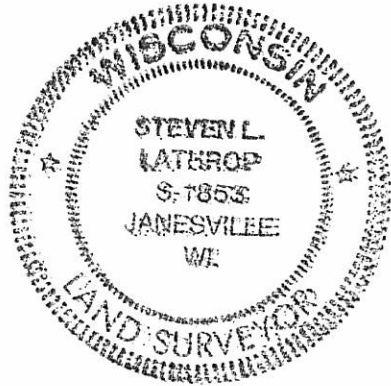

Steven Lathrop


Steven Lathrop
R.L.S. Number 1853
If the surveyor's signature is not red in color, the map is a copy and may contain unauthorized alterations. The certification contained hereon shall not apply to any copies.

CSM #782 LOT 2

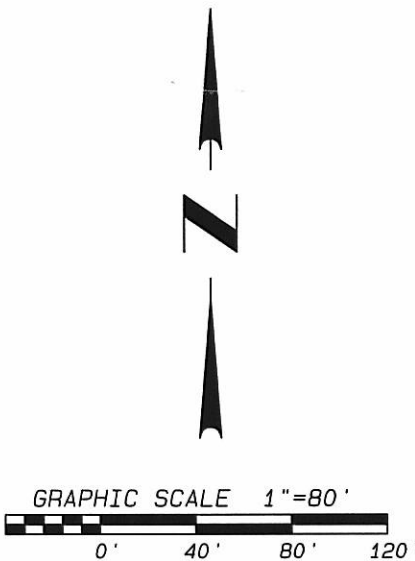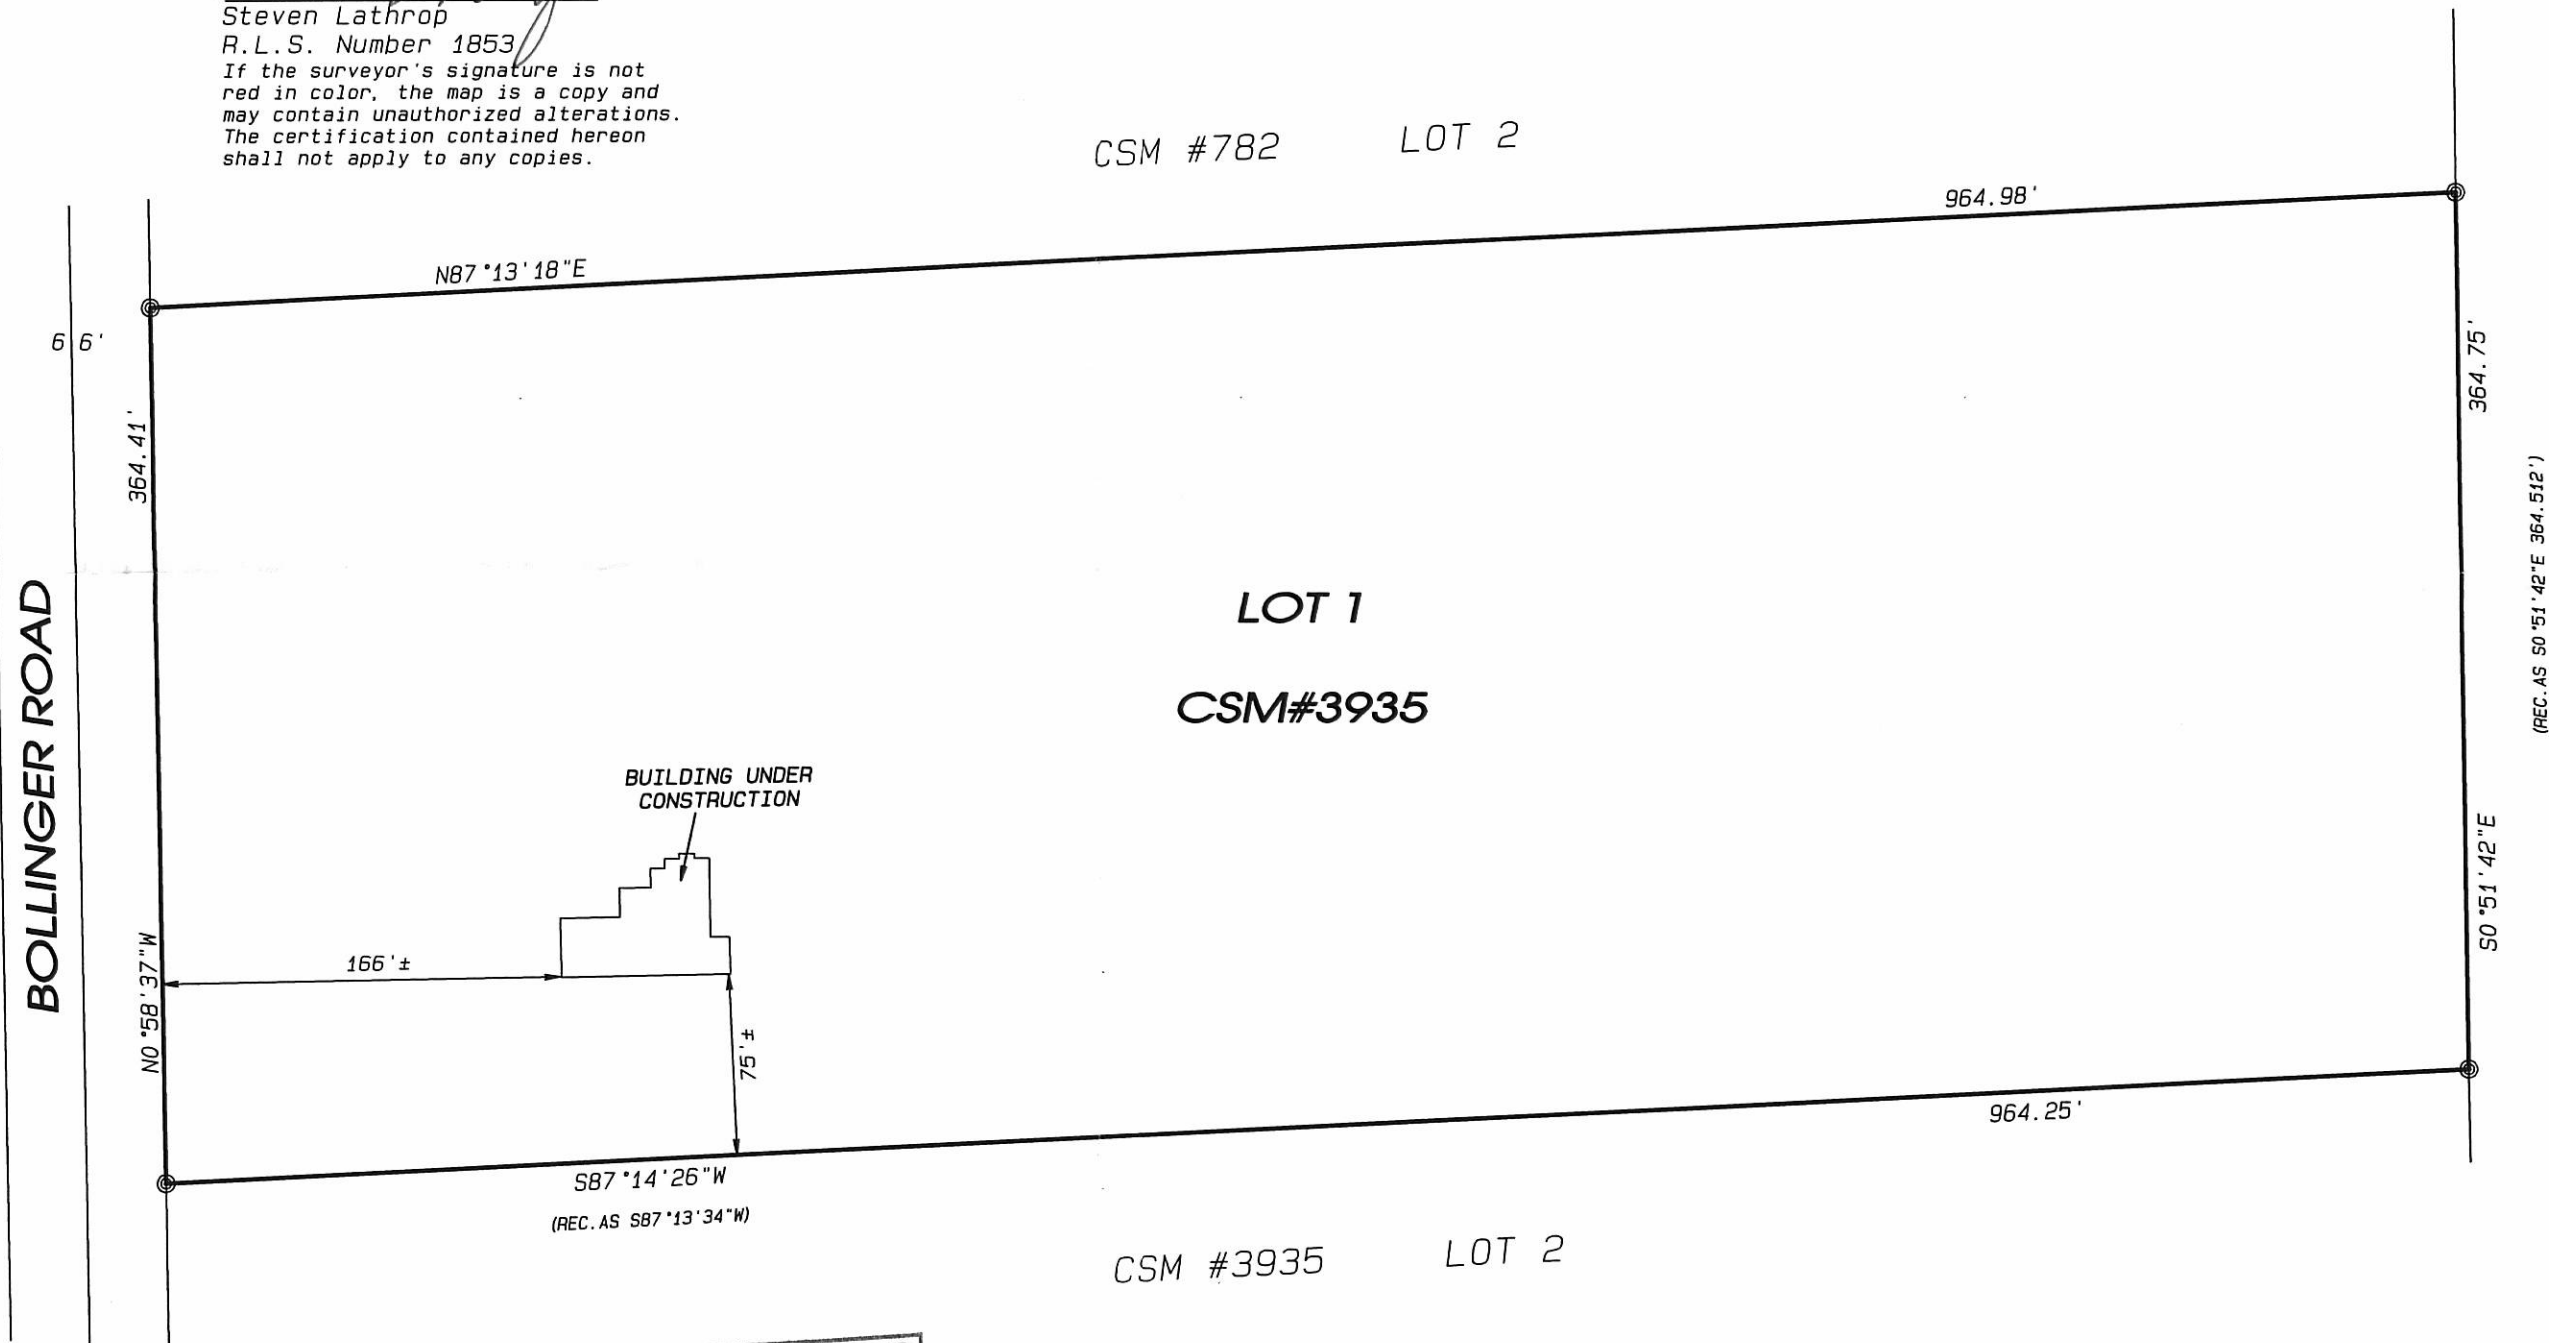

LEGEND:
© FOUND 1" ROUND IRON PIPE

Project No. 109 - 225 For: Wellnitz & Sarow Builders, Inc.

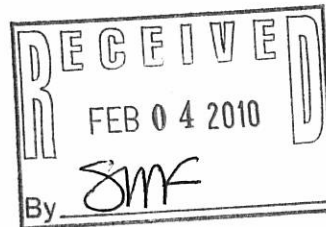

NOTES:

THIS SURVEY IS SUBJECT TO ANY AND ALL EASEMENTS AND AGREEMENTS, RECORDED AND UNRECORDED.

ASSUMED N87°13'18"E ALONG THE NORTH LINE OF LOT 2 OF CSM# 3935.

Combs & ASSOCIATES

- LAND SURVEYING
- LAND PLANNING
- CIVIL ENGINEERING

109 W. Milwaukee St.
Janesville, WI 53548
www.combssurvey.com

tel: 608 752-0575
fax: 608 752-0534

AA3935-1

115-370