

Plat of Survey

of

Lot 1 of Certified Survey Map No. 3625,

recorded in Vol. 21 of Certified Survey Maps of Walworth County on Page 251 and located in the Northwest 1/4 of the Northeast 1/4 of Section 6, Town 1 North, Range 15 East, Town of Sharon, Walworth County, Wisconsin.

Surveyed for: **Shorewest Realtors**


830 East Geneva Street
Delavan, Wisconsin. 53115

Copyright 2010 by Jensen & Olson Land Surveying, LLC.


All rights reserved. No part of this survey plat may be reproduced or transmitted in any form by any means - graphic, electronic, or mechanical, including photocopying, tracing, or information storage and retrieval systems - without permission in writing from Douglas G. Olson, Jensen & Olson Land Surveying, LLC.

I hereby certify that I have surveyed the above described property and the map hereon is correct to the best of my professional knowledge and belief and shows the size and location of the property, its exterior boundaries, the location and dimensions of all visible structures thereon, boundary fences, apparent easements and roadways and visible encroachments, if any.

This survey is made for the exclusive use of the present owners of the property, and also those who purchase, mortgage or guarantee title thereto, within one year from the date hereof.

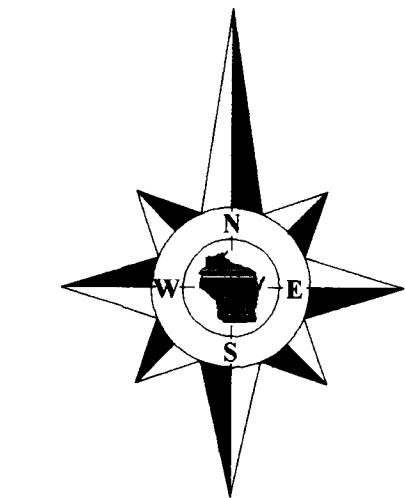

Bearings reference to the Wisconsin State Plane Coordinate System, South Zone.

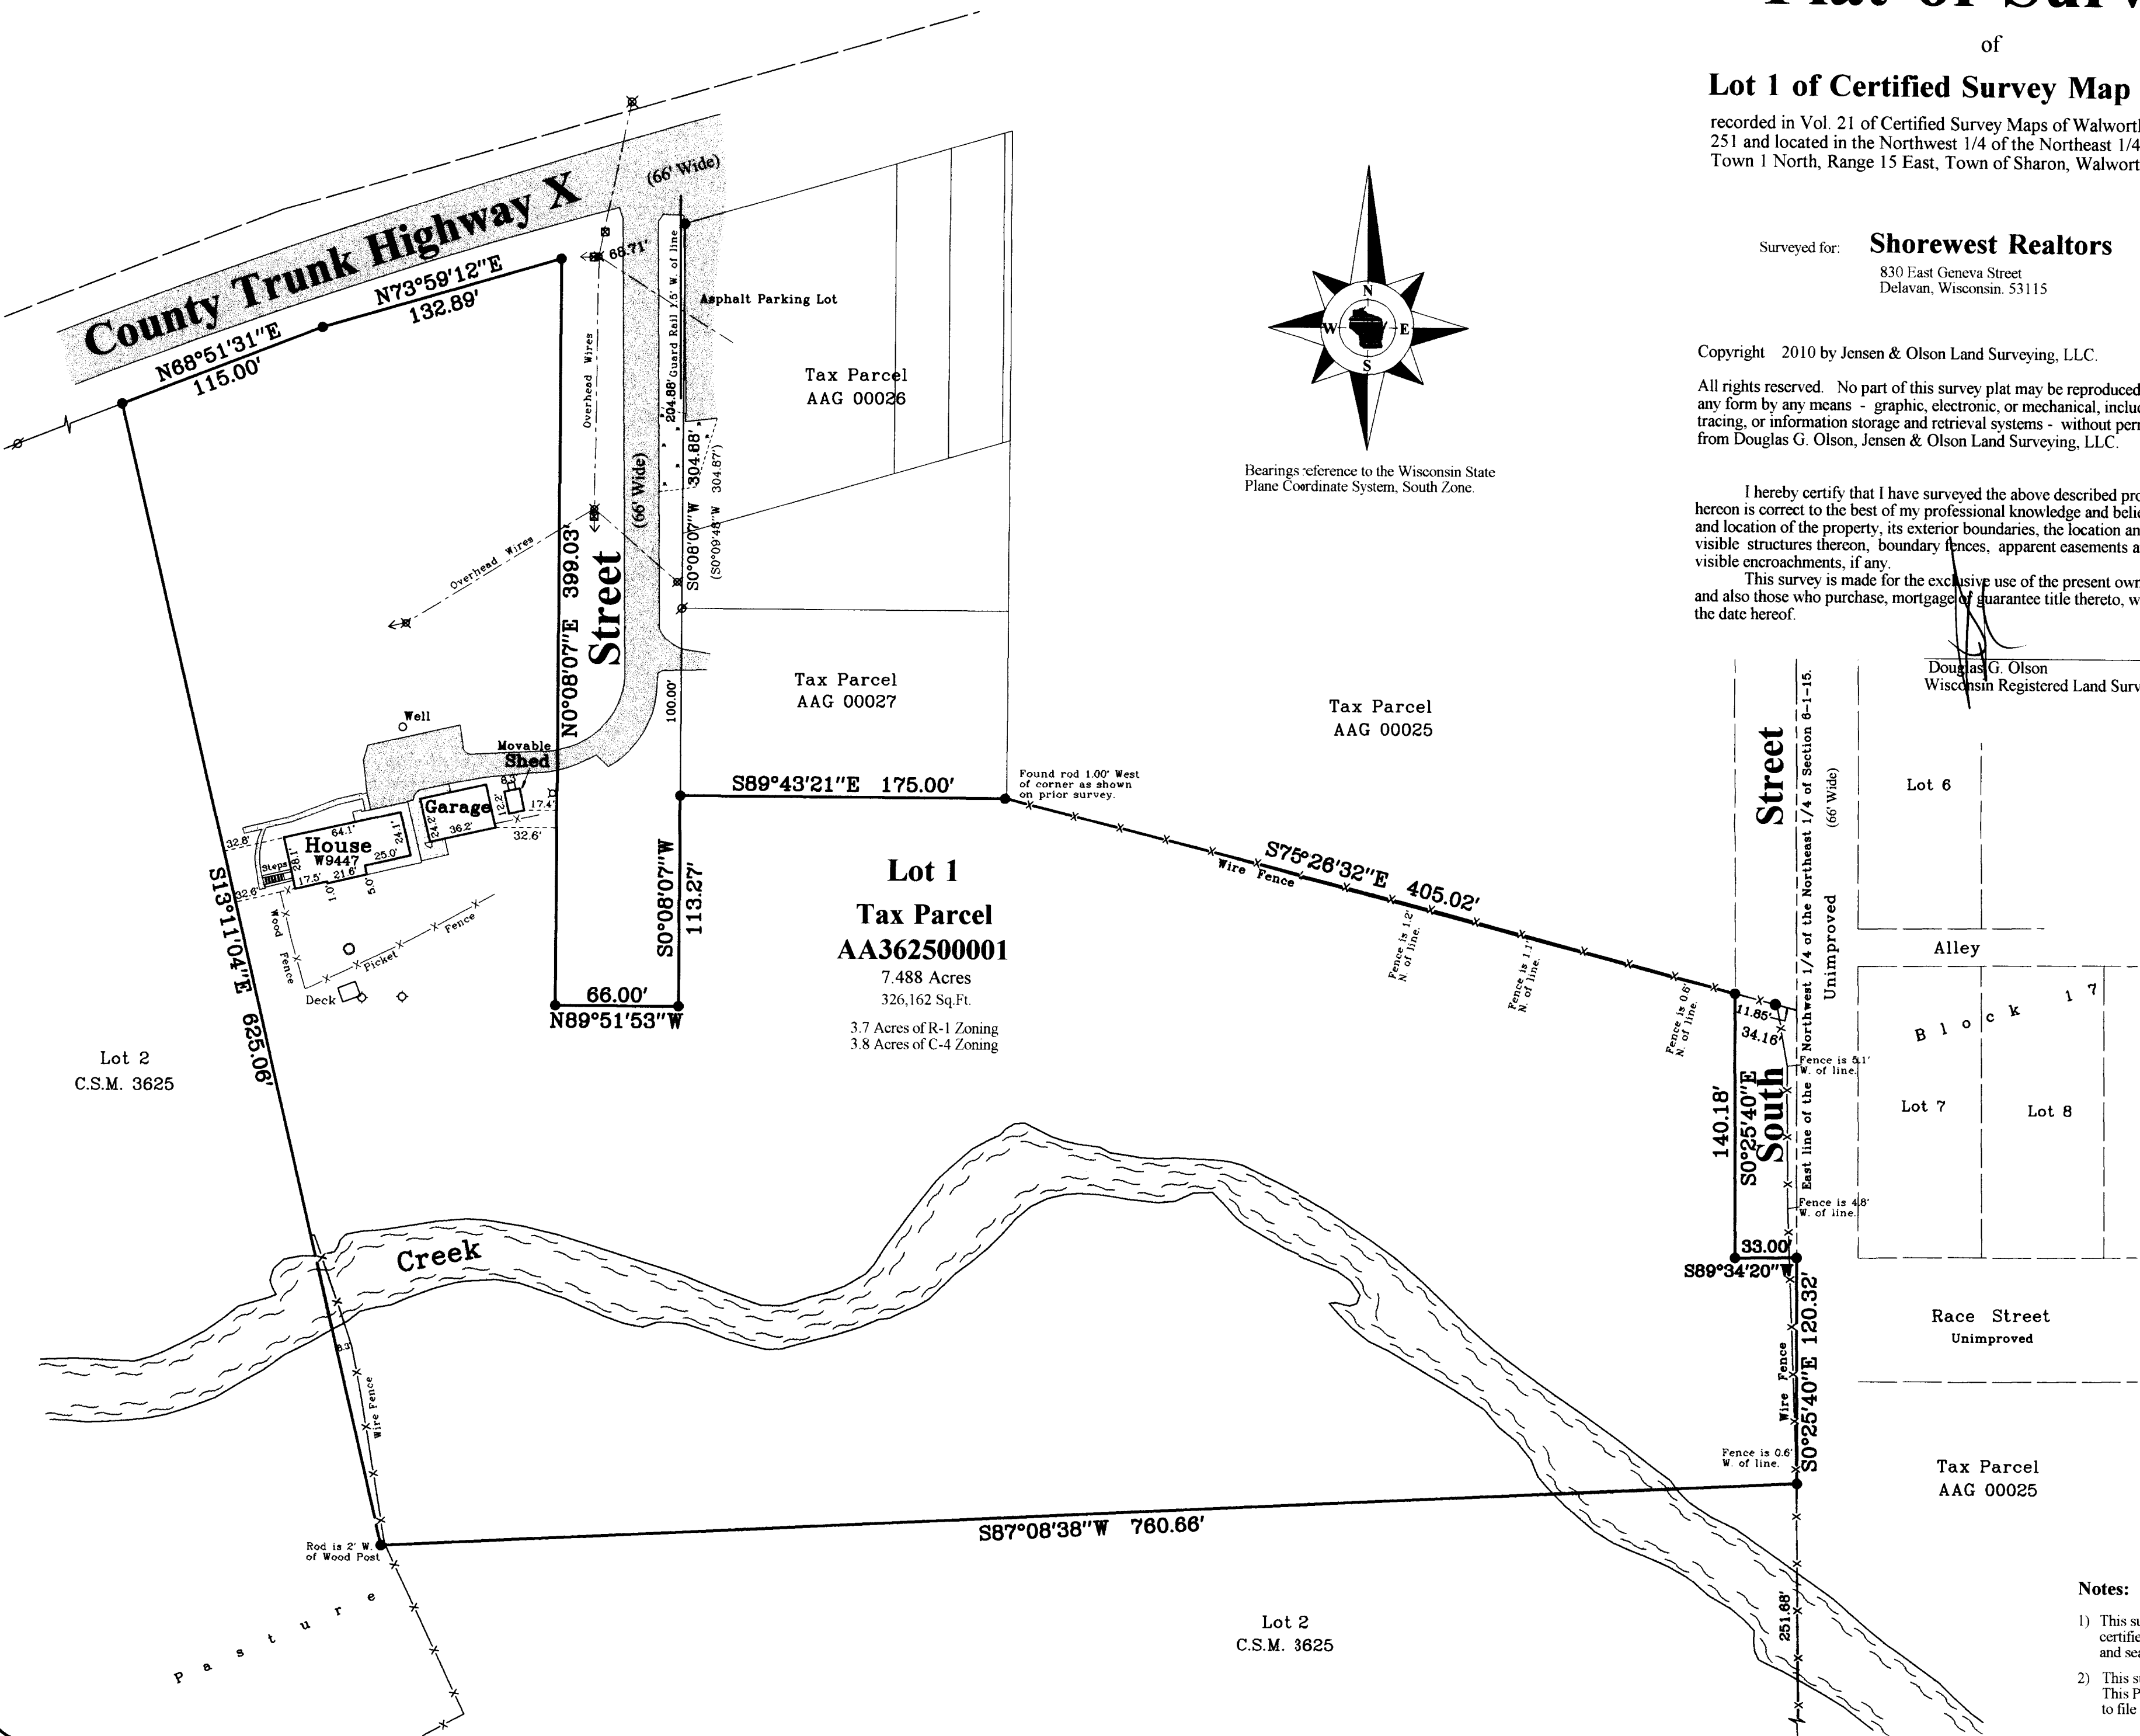

Douglas G. Olson
Wisconsin Registered Land Surveyor - 2093

Lot 6



Alley

Lot 7

Lot 8

Race Street
Unimproved


Tax Parcel
AAG 00025

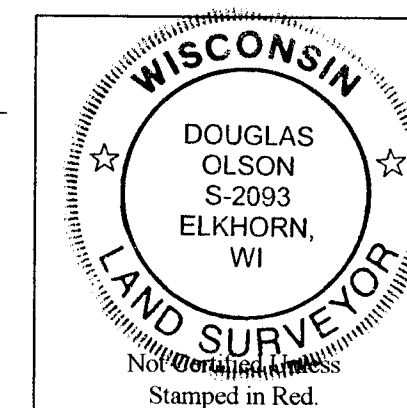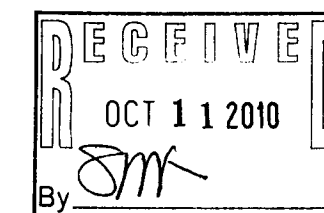

Notes:

- 1) This survey plat is not certified unless signed and sealed in red ink.
- 2) This survey is subject to Wisconsin lien laws. This Plat of Survey is the notice of intent to file lien. Lien waiver required.

Survey Date: Sept. 20, 2010.
Revisions:

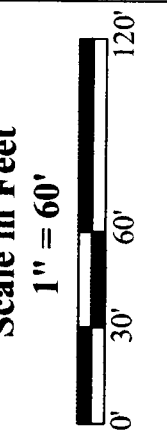

Jensen & Olson Land Surveying, LLC

45 South Wisconsin Street * P.O. Box 322 * Elkhorn, Wisconsin. 53121
Telephone: (262) 723-3434 * Facsimile: (262) 723-8044
Email: jensen.olson@elknet.net

- Legend**
- Concrete
 - Found Iron Pipe
 - Found Iron Rod
 - Recorded Information
 - Utility Pole
 - Asphalt Surface
 - Concrete Surface
 - Gravel
 - Vent
 - Lamp
 - Pedestal
 - Pavers

Sheet 1 of 1 Sheets
Drawing Name: Plat 152-2010090-2010090Plat1.dwg
Job Reference Number
2010.090

2010.090