


LAND-MARK SURVEYING
Mark L. Miritz
Wisconsin Registered Land Surveyor S-2582

N9330 Knuteson Drive
Whitewater, WI 53190
Phone: (262) 495-3284
MARKMIRITZ@
LAND-MARKSURVEYING.COM

**LOT 2 OF CERTIFIED SURVEY MAP NO. 4130, LOCATED
IN PART OF THE SOUTHWEST 1/4 OF THE SOUTHWEST
1/4 OF SECTION 30, TOWN 1 NORTH, RANGE 15 EAST,
TOWN OF SHARON, WALWORTH COUNTY, WISCONSIN**

OWNERS:
WILBUR B. KINGERY
ROBIN E. KINGERY
W5091 HWY 20
EAST TROY, WI 53120

PLAT OF SURVEY

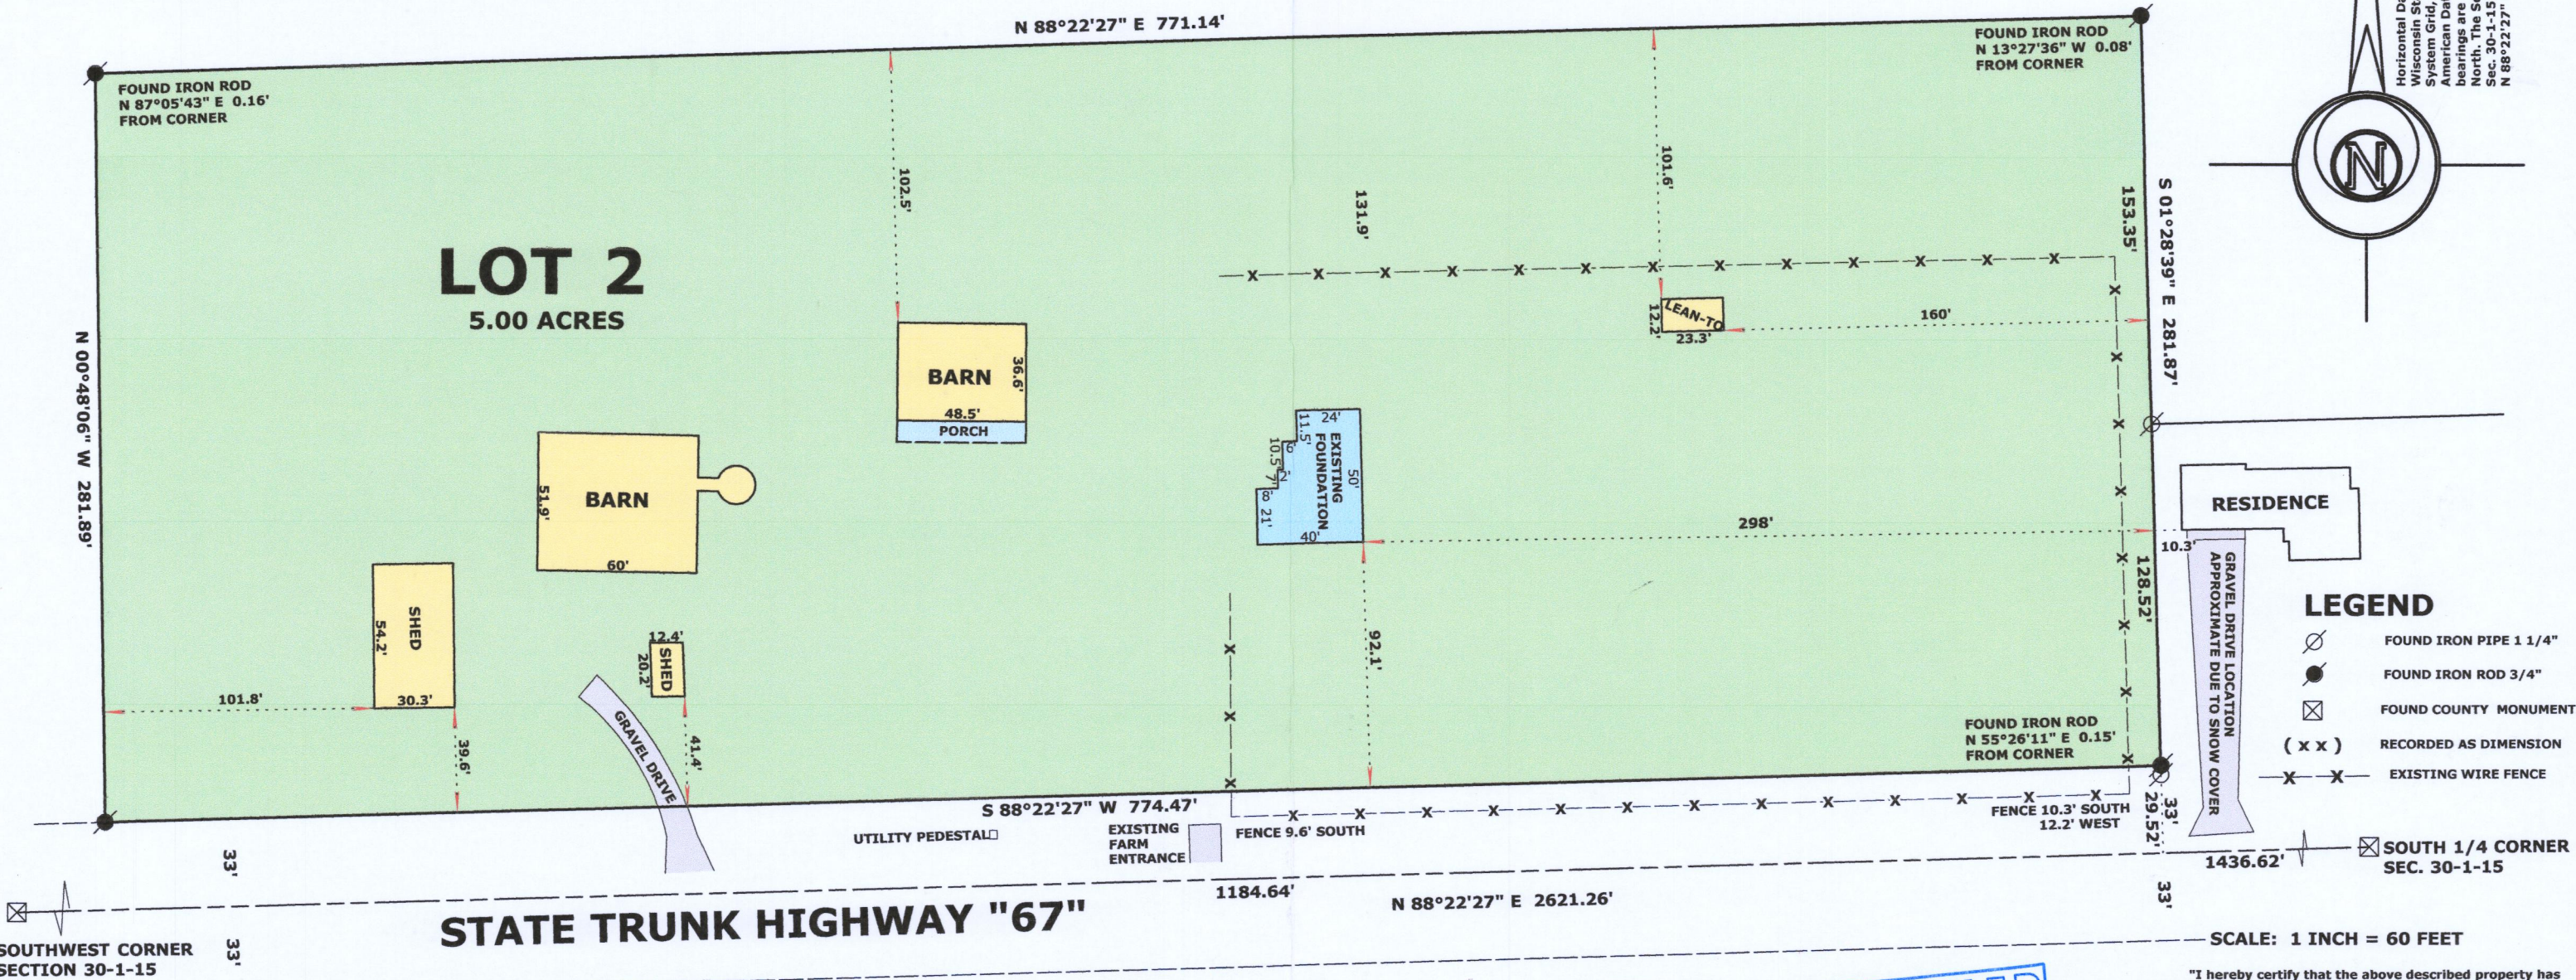

LEGEND

- FOUND IRON PIPE 1 1/4"
- FOUND IRON ROD 3/4"
- FOUND COUNTY MONUMENT
- (x x) RECORDED AS DIMENSION
- EXISTING WIRE FENCE
- GRAVEL DRIVE LOCATION APPROXIMATE DUE TO SNOW COVER
- SOUTH 1/4 CORNER SEC. 30-1-15



REVISED JUNE 17, 2019 TO
SHOW PROPOSED RESIDENCE
REVISED OCT. 16, 2019 TO SHOW
FOUNDATION "AS BUILT"

"I hereby certify that the above described property has been surveyed by me or under my direction and that the above map is a true representation thereof and shows the size and location of the property, its exterior boundaries, the location of all visible structures and dimensions of all principal buildings thereon, boundary fences, apparent easements, roadways and visible encroachments, if any."
"This survey is made for the use of the present owners of the property, and also those who purchase, mortgage, or guarantee the title thereto within one year from date hereof."

Mark L. Miritz
MARK L. MIRITZ
WISCONSIN REGISTERED
LAND SURVEYOR S-2582

DATE: NOV. 26, 2013 JOB NO. 13.1108

AA 4130-2 115-468