
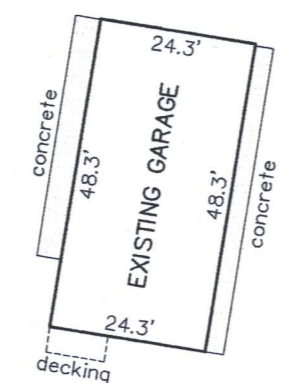


COUNTY TRUNK HIGHWAY "K"


WEST LINE OF THE SOUTHWEST 1/4 OF SECTION 12-1-15 SECTION LINE = N00°37'21"W 2644.41' N00°38'06"W 66.03' N00°16'21"E 66.05'

- LEGEND**
- FOUND IRON PIPE (OUTSIDE DIAMETER AS NOTED)
 - FOUND 3/4" DIA. IRON ROD
 - ⊘ SET 1-5/16" O.D. IRON PIPE
 - () RECORDED AS
 - ▲ UTILITY POLE
 - ▣ UTILITY BOX
 - OVERHEAD UTILITY LINES

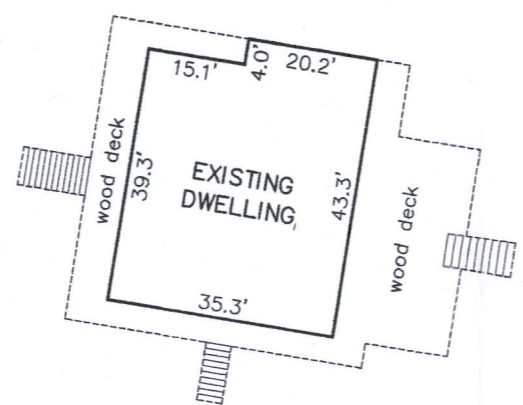

LOT 1 OF C.S.M. NO. 2545

LOT 2 OF C.S.M. NO. 2545
10.476 acres

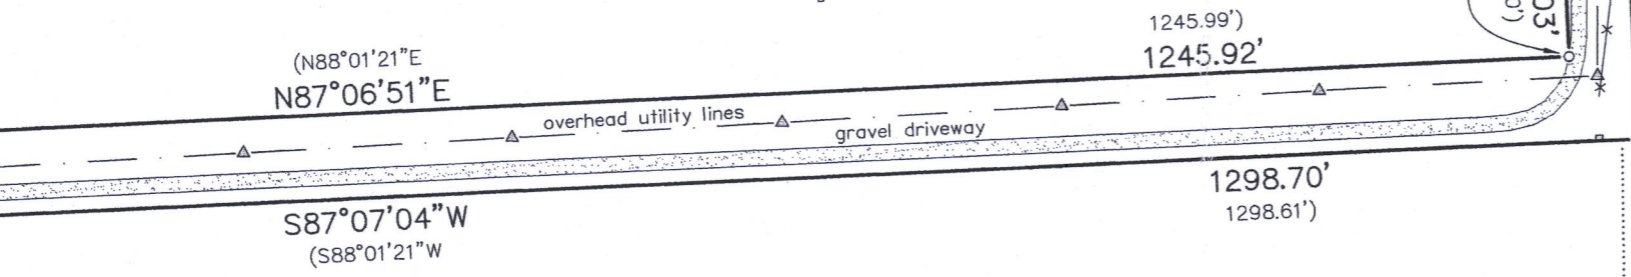

NOTE: REFER TO A CURRENT TITLE REPORT FOR EASEMENTS, RESTRICTIONS OR COVENANTS WHICH MAY AFFECT THIS PROPERTY.

LOT 3 OF C.S.M. NO. 2545

PLAT OF SURVEY
-OF-




LOT 2 OF CERTIFIED SURVEY MAP NO. 2545, AS RECORDED IN THE OFFICE OF THE REGISTER OF DEEDS IN AND FOR WALWORTH COUNTY, WISCONSIN ON DECEMBER 27, 1994 IN VOLUME 12 OF CERTIFIED SURVEY MAPS ON PAGES 321-323 AS DOCUMENT NO. 298777, AND BEING A PART OF THE SOUTHEAST 1/4 AND SOUTHWEST 1/4 OF THE SOUTHWEST 1/4 OF SECTION 12, AND THE NORTHWEST 1/4 OF THE NORTHWEST 1/4 OF SECTION 13, ALL IN TOWNSHIP 1 NORTH, RANGE 15 EAST OF THE FOURTH PRINCIPAL MERIDIAN, IN THE TOWN OF SHARON, COUNTY OF WALWORTH AND STATE OF WISCONSIN.

SURVEY FOR: SEAN AND LAURIE O'DONNELL
SURVEY ADDRESS: N1782 COUNTY ROAD K, SHARON, WI 53585

"I HEREBY CERTIFY THAT I HAVE SURVEYED THE ABOVE DESCRIBED PROPERTY AND THAT THE ABOVE MAP IS A CORRECT REPRESENTATION THEREOF AND SHOWS THE SIZE AND LOCATION OF THE PROPERTY, ITS EXTERIOR BOUNDARIES, THE LOCATION OF ALL VISIBLE STRUCTURES AND DIMENSIONS OF ALL PRINCIPAL BUILDINGS THEREON, BOUNDARY FENCES, APPARENT EASEMENTS, ROADWAYS AND ENCROACHMENTS, IF ANY."

"THIS SURVEY IS MADE FOR THE USE OF THE PRESENT OWNERS OF THE PROPERTY, AND THOSE WHO PURCHASE, MORTGAGE, OR GUARANTEE THE TITLE THERETO WITHIN ONE YEAR FROM DATE HEREOF."

SATTER SURVEYING, LLC
LAND SURVEYS, MAPPING AND PLANNING
272 ORIGIN STREET
BURLINGTON, WI 53105
262-661-4239

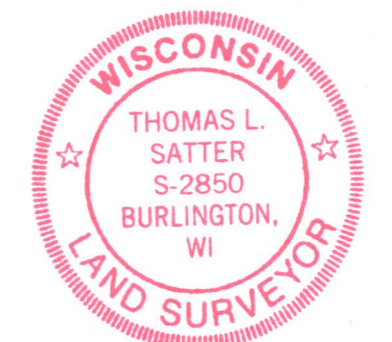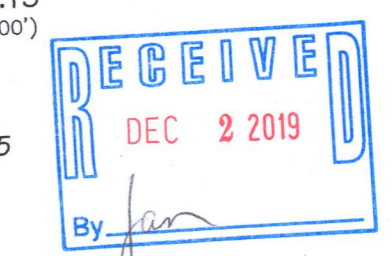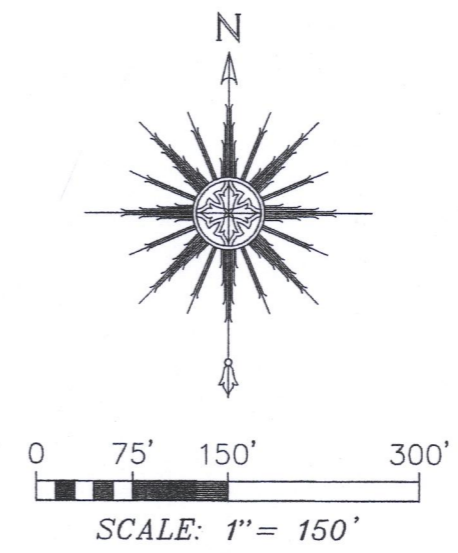

THIS IS NOT AN ORIGINAL PRINT UNLESS THIS SEAL IS RED.

Thomas L. Satter
THOMAS L. SATTER S-2850

NOVEMBER 7, 2019 DATE 091907 JOB NUMBER

AA2545-2 115-469