


North 1/4 Corner  
Section 5-1-15  
(N. 214,078.24)  
(E. 2,337,498.79)

# Plat of Survey

of

## Lot 1 of Certified Survey Map No. 1298,

recorded in Vol. 6 of Certified Survey Maps of Walworth County on Page 94  
and located in the Northwest 1/4 of the Northeast 1/4 of Section 5, Town 1  
North, Range 15 East, Town of Sharon, Walworth County, Wisconsin.

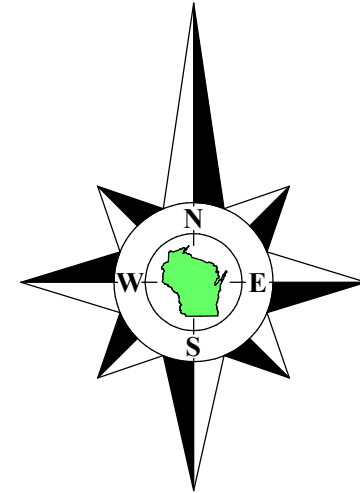

Surveyed for: **Martin Small**  
N2412 Salt Box Road  
Darien, Wisconsin. 53114

Tax Parcel  
A S 500001

Bearings referenced to the West line of the Northeast 1/4 of Section 5-1-15,  
recorded as North on Certified Survey Map No. 1298. A rotation of 0°49'13"  
from the Wisconsin State Plane Coordinate System, South Zone, (NAD-27).

Coordinates are referenced to the Wisconsin State  
Plane Coordinate System, South Zone, (NAD-27).

Edge of Farm Field recorded as (East 428.78')  
**S89°59'24"E 428.73'**

33.04'  
(33.00')

395.69'  
(395.78')

118.9'

Shed  
30.4' x 14.4'

100.8'

140.1'

Lean to Silo Silo  
Barn  
68.0' x 54.4'

Tank

House  
N2412  
Porch 16.3' x 16.3'  
Deck 33.0' x 26.4'

Lot 1  
Tax Parcel  
AA129800001  
3.651 Acres  
159,041 Sq.Ft.  
3.370 Acres  
146,794 Sq.Ft.  
Exclusive of R.O.W.

Well

Shed  
20.3' x 14.4'

Old Foundation

120.0'

146.6'

(395.78')  
395.78'

Edge of Farm Field recorded as (West 428.78')  
**S89°58'31"W 428.75'**

Tax Parcel  
A S 500001

Copyright ©2022 by Olson Land Surveying, LLC.

All rights reserved. No part of this survey plat may be reproduced or transmitted in any form by any means - graphic, electronic, or mechanical, including photocopying, tracing, or information storage and retrieval systems - without permission in writing from Douglas G. Olson, Olson Land Surveying, LLC.

I hereby certify that I have surveyed the above described property in compliance with Chapter A-E 7 of the Wisconsin Administrative Code and that the map hereon is correct to the best of my professional knowledge and belief and shows the size and location of the property, its exterior boundaries, the location and dimensions of all visible structures thereon, boundary fences, apparent easements and roadways and visible encroachments, if any.

This survey is made for the exclusive use of the present owners of the property, and also those who purchase, mortgage or guarantee title thereto, within one year from the date hereof.

Douglas G. Olson  
Wisconsin Professional Land Surveyor - 2093



Not Certified Unless Stamped in Red.

### Notes:

- 1) This Plat of Survey is not certified unless signed and sealed in red ink.
- 2) This survey is subject to Wisconsin lien laws. This Plat of Survey is the notice of intent to file lien. Lien waiver required.
- 3) The Survey Date shown on this Plat of Survey is the completion date of the field work.

Center 1/4 Corner  
Section 5-1-15  
(N. 211,147.32)  
(E. 2,337,540.76)

Salt Box Road  
(66' Wide)

recorded as (North 371.00')  
North 371.08'

recorded as (N0°49'13"W 2831.24') State Plane  
North 2931.22'  
West line of the Northeast 1/4 of Section 5-1-15.  
North 1593.84'

R.O.W.

Overhead Wires

recorded as (North 371.00')  
North 371.06'

Overhead Wires

Driveway

Driveway

R.O.W.

(33.00')  
32.97'

Edge of Farm Field

Edge of Farm Field

recorded as (South 371.00')  
S0°00'11"E 370.82'

Tax Parcel  
A S 500001

Edge of Farm Field

Sheet 1 of 1 Sheets

Drawing Name:

Job Reference Number  
2022.126


### Legend of Symbols & Abbreviations

- Found County Section Corner
  - Found Iron Pipe
  - Recorded Information
  - Utility Pole
  - Utility Pedestal
  - Concrete Cover
  - Septic Vent
  - Asphalt Surface
  - Concrete Surface
  - Gravel Surface
- N North  
S South  
E East  
W West  
In Bearings  
° Degrees  
' Minutes  
" Seconds  
In Distances  
' Feet  
" Inches



45 South Wisconsin Street | P.O. Box 322  
Elkhorn, Wisconsin. 53121  
Telephone: (262) 723-3434  
Facsimile: (262) 723-8044  
Email: doug@olsonsurveying.com  
Website: www.olsonsurveying.com

Scale in Feet  
1" = 30'

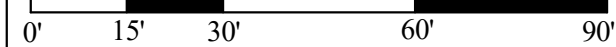

Survey Date: October 15, 2022.

Revisions:

2022.126