

North 1/4 Corner
Section 5-1-15
(N. 214,078.24)
(E. 2,337,498.79)

Plat of Survey


of

Lot 1 of Certified Survey Map No. 1298,

recorded in Vol. 6 of Certified Survey Maps of Walworth County on Page 94 and located in the Northwest 1/4 of the Northeast 1/4 of Section 5, Town 1 North, Range 15 East, Town of Sharon, Walworth County, Wisconsin.


Surveyed for: **Martin Small**
N2412 Salt Box Road
Darien, Wisconsin. 53114

Tax Parcel
A S 500001

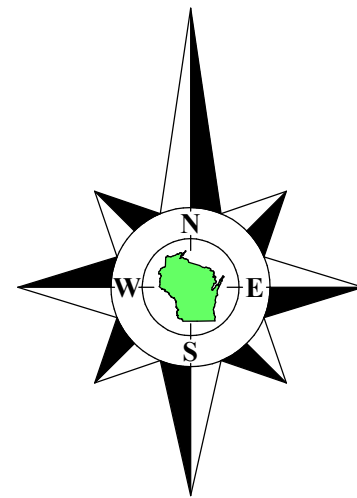

Bearings referenced to the West line of the Northeast 1/4 of Section 5-1-15, recorded as North on Certified Survey Map No. 1298. A rotation of 0°49'13" from the Wisconsin State Plane Coordinate System, South Zone, (NAD-27).

Coordinates are referenced to the Wisconsin State Plane Coordinate System, South Zone, (NAD-27).

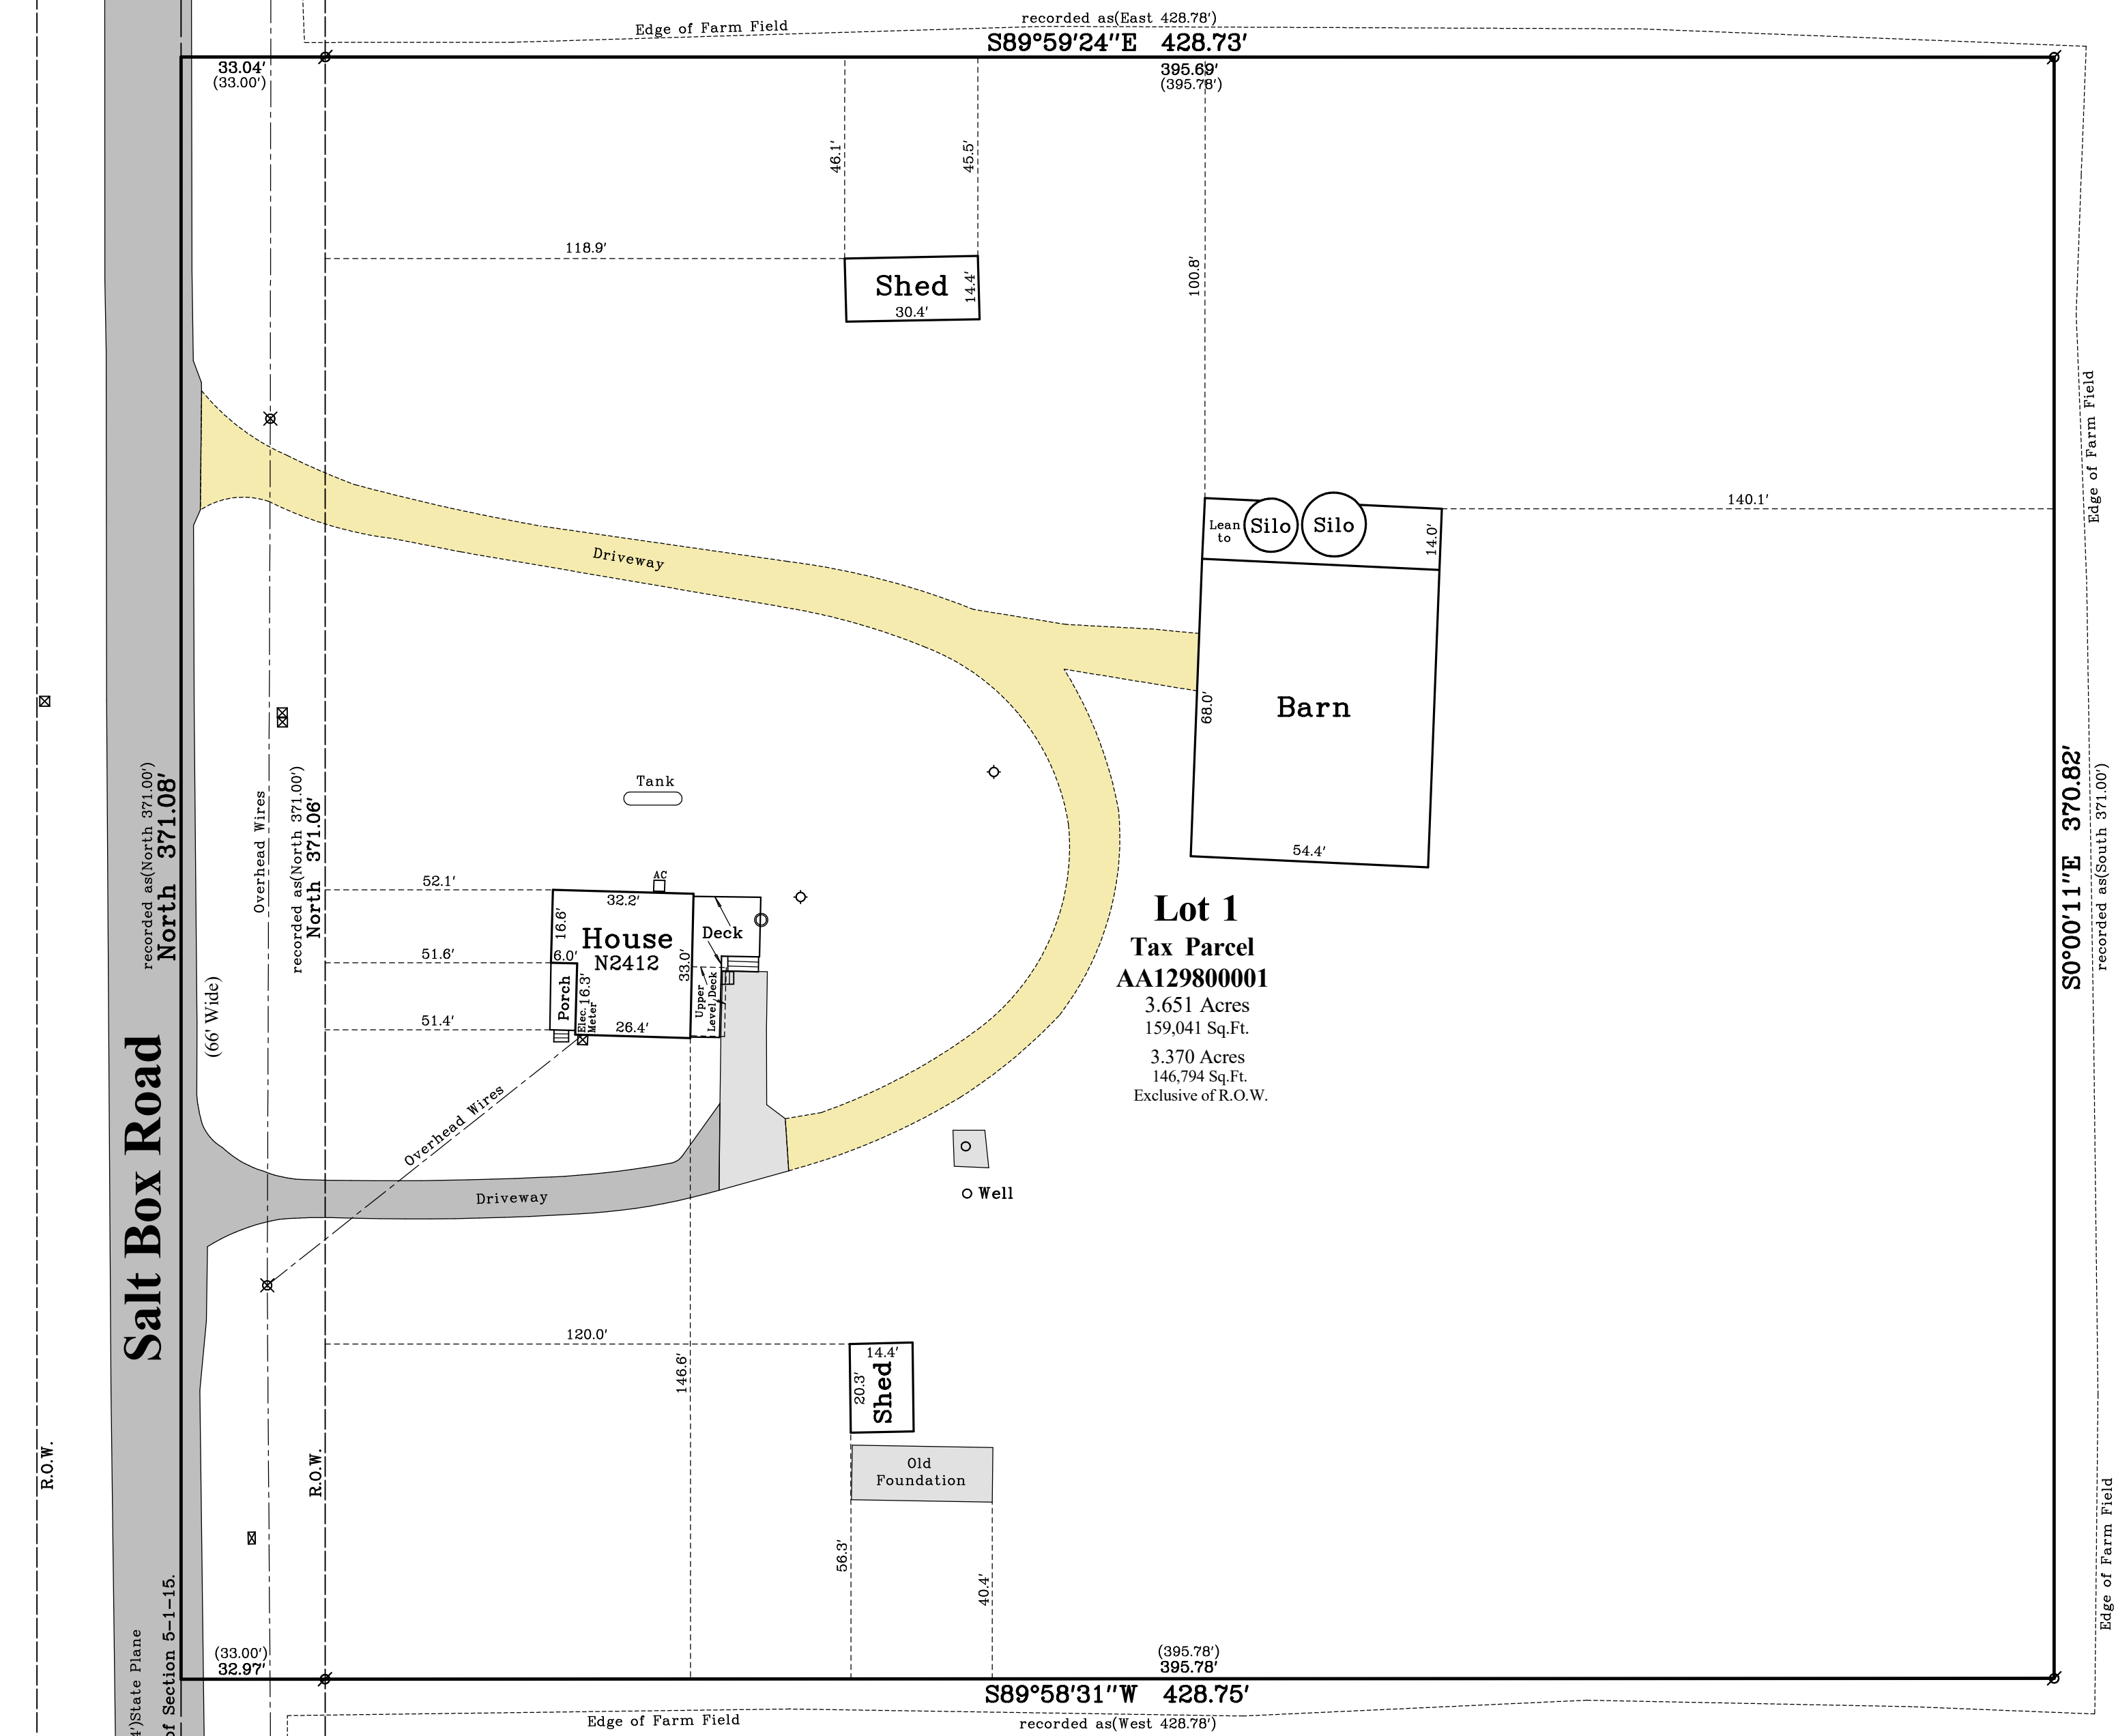

Tax Parcel
A S 500001

Lot 1
Tax Parcel
AA129800001
3.651 Acres
159,041 Sq.Ft.
3.370 Acres
146,794 Sq.Ft.
Exclusive of R.O.W.

Tax Parcel
A S 500001


Copyright ©2022 by Olson Land Surveying, LLC.

All rights reserved. No part of this survey plat may be reproduced or transmitted in any form by any means - graphic, electronic, or mechanical, including photocopying, tracing, or information storage and retrieval systems - without permission in writing from Douglas G. Olson, Olson Land Surveying, LLC.

I hereby certify that I have surveyed the above described property in compliance with Chapter A-E 7 of the Wisconsin Administrative Code and that the map hereon is correct to the best of my professional knowledge and belief and shows the size and location of the property, its exterior boundaries, the location and dimensions of all visible structures thereon, boundary fences, apparent easements and roadways and visible encroachments, if any.

This survey is made for the exclusive use of the present owners of the property, and also those who purchase, mortgage or guarantee title thereto, within one year from the date hereof.

Douglas G. Olson
Wisconsin Professional Land Surveyor - 2093

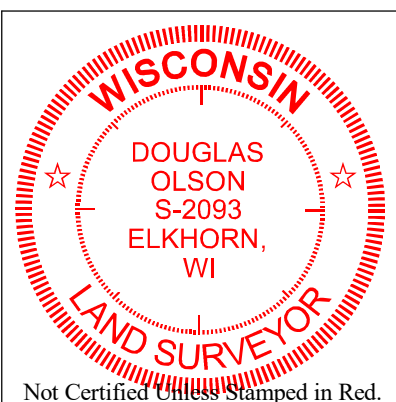

Notes:

- 1) This Plat of Survey is not certified unless signed and sealed in red ink.
- 2) This survey is subject to Wisconsin lien laws. This Plat of Survey is the notice of intent to file lien. Lien waiver required.
- 3) The Survey Date shown on this Plat of Survey is the completion date of the field work.

Center 1/4 Corner
Section 5-1-15
(N. 211,147.32)
(E. 2,337.540.76)

2022.126

Sheet 1 of 1 Sheets

Drawing Name:

Job Reference Number
2022.126

Legend of Symbols & Abbreviations

- | | | | |
|---|-----------------------------|----|-----------|
| ■ | Found County Section Corner | N | North |
| ○ | Found Iron Pipe | S | South |
| ○ | Recorded Information | E | East |
| ○ | Utility Pole | W | West |
| ⊗ | Utility Pedestal | In | Bearings |
| ○ | Concrete Cover | ° | Degrees |
| ○ | Septic Vent | " | Minutes |
| ○ | Asphalt Surface | " | Seconds |
| ○ | Concrete Surface | In | Distances |
| ○ | Gravel Surface | " | Feet |
| ○ | | " | Inches |

Not Certified Unless Stamped in Red.



45 South Wisconsin Street | P.O. Box 322
Elkhorn, Wisconsin. 53121
Telephone: (262) 723-3434
Facsimile: (262) 723-8044
Email: doug@olsonsurveying.com
Website: www.olsonsurveying.com

Scale in Feet
1" = 30'



Survey Date: October 15, 2022.

Revisions: