


DUNHAM SURVEYING, S. C.
 SURVEYING & SUBDIVIDING
 DELAVAN, WISCONSIN 53115

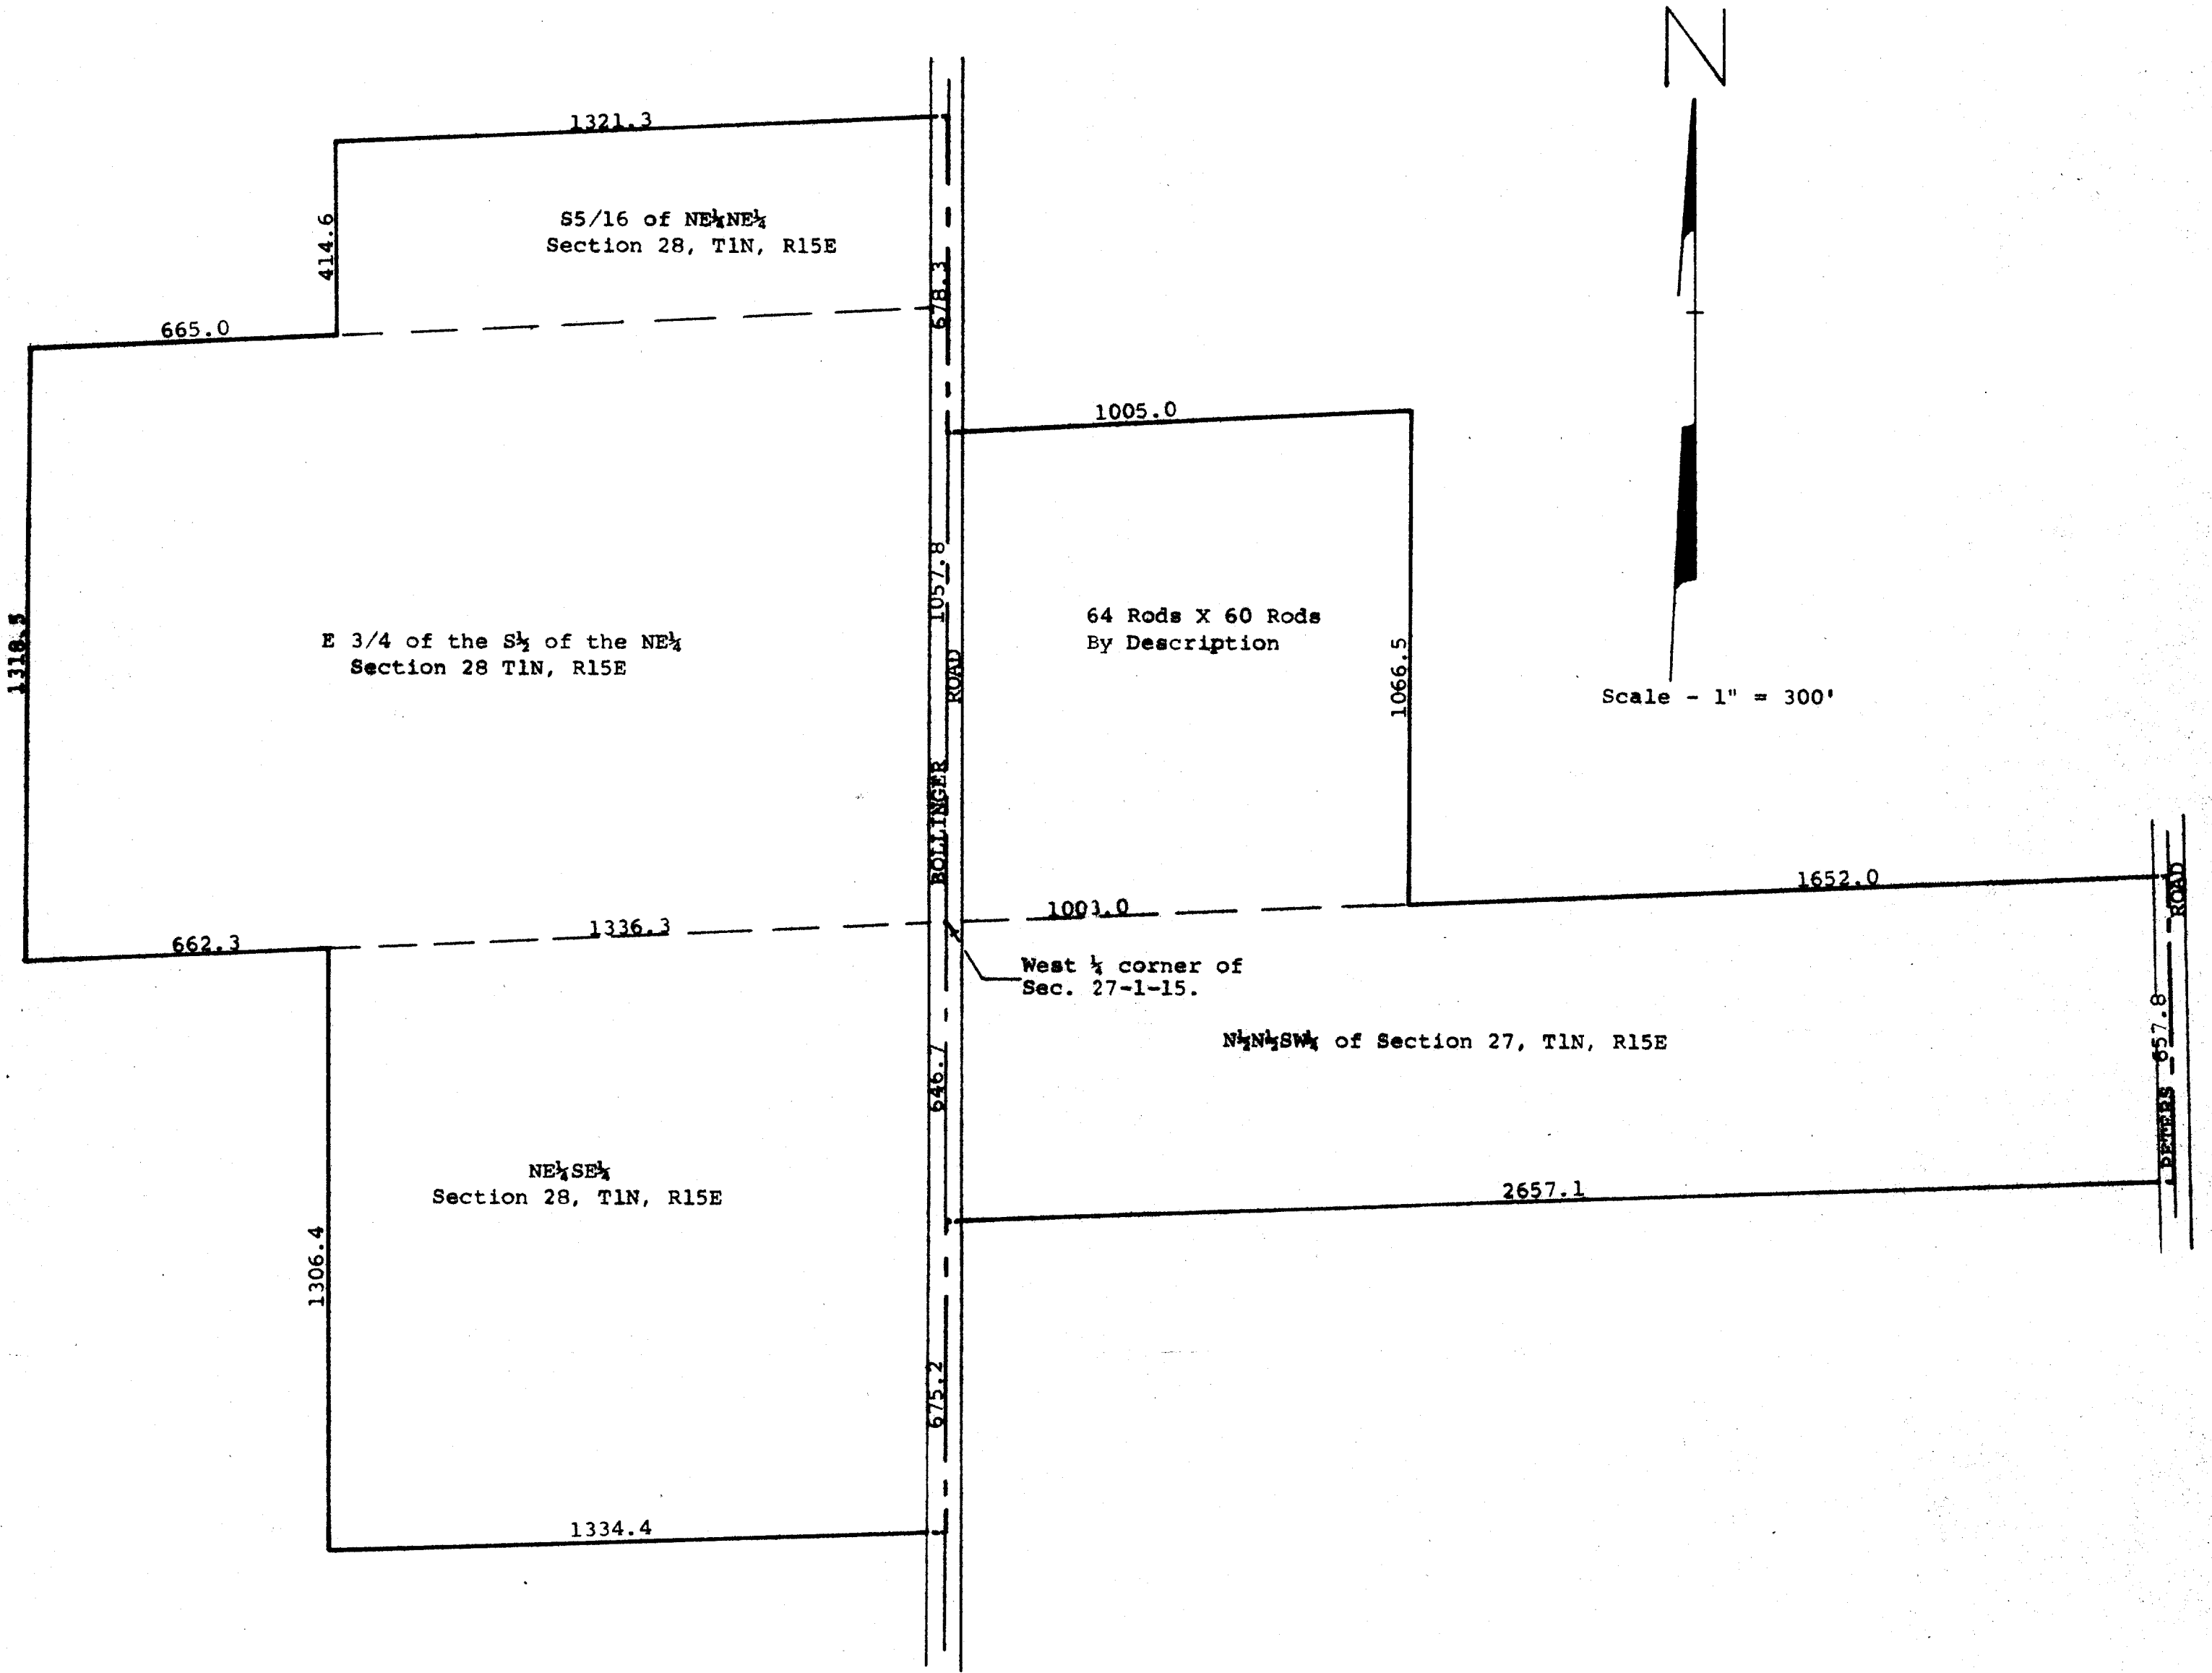

S-27-7 S-27-7B
 S-28-2

Plat of a fence line survey of the George Bollinger
 Farm located in Sections 27 and 28, T 1 N, R 15 E,
 Walworth County, Wisconsin, containing 177.3 acres.
 October 20, 1976

George T. Dunham
 George T. Dunham, Surveyor

