

of

Tax Key No. EW 1600008A Town of Walworth

Tax Key No. EA130700001 Town of Walworth

Said EXCLUDING land described in Vol. 440 of Records on Page 569 as follows:

Surveyed for: **Louise Buchanan**

Coordinates are referenced to the Wisconsin State Plane Coordinate System, South Zone, (NAD-27).




- 1) This Plat of Survey is not certified unless signed and sealed in red ink.
- 2) This survey is subject to Wisconsin lien laws. This Plat of Survey is the notice of intent to file lien. Lien waiver required.
- 3) The Survey Date shown on this Plat of Survey is the completion date of the field work.

This survey is made for the exclusive use of the present owners of the property, and also those who purchase, mortgage or guarantee title thereto, within one year from the date hereof.

Northwest Corner
Section 16-1-16
(N. 204,537.16)
(E. 2,372,063.88)

West 1/4 Corner
Section 16-1-16,
(N. 201,963.13)
(E. 2,372,152.62)

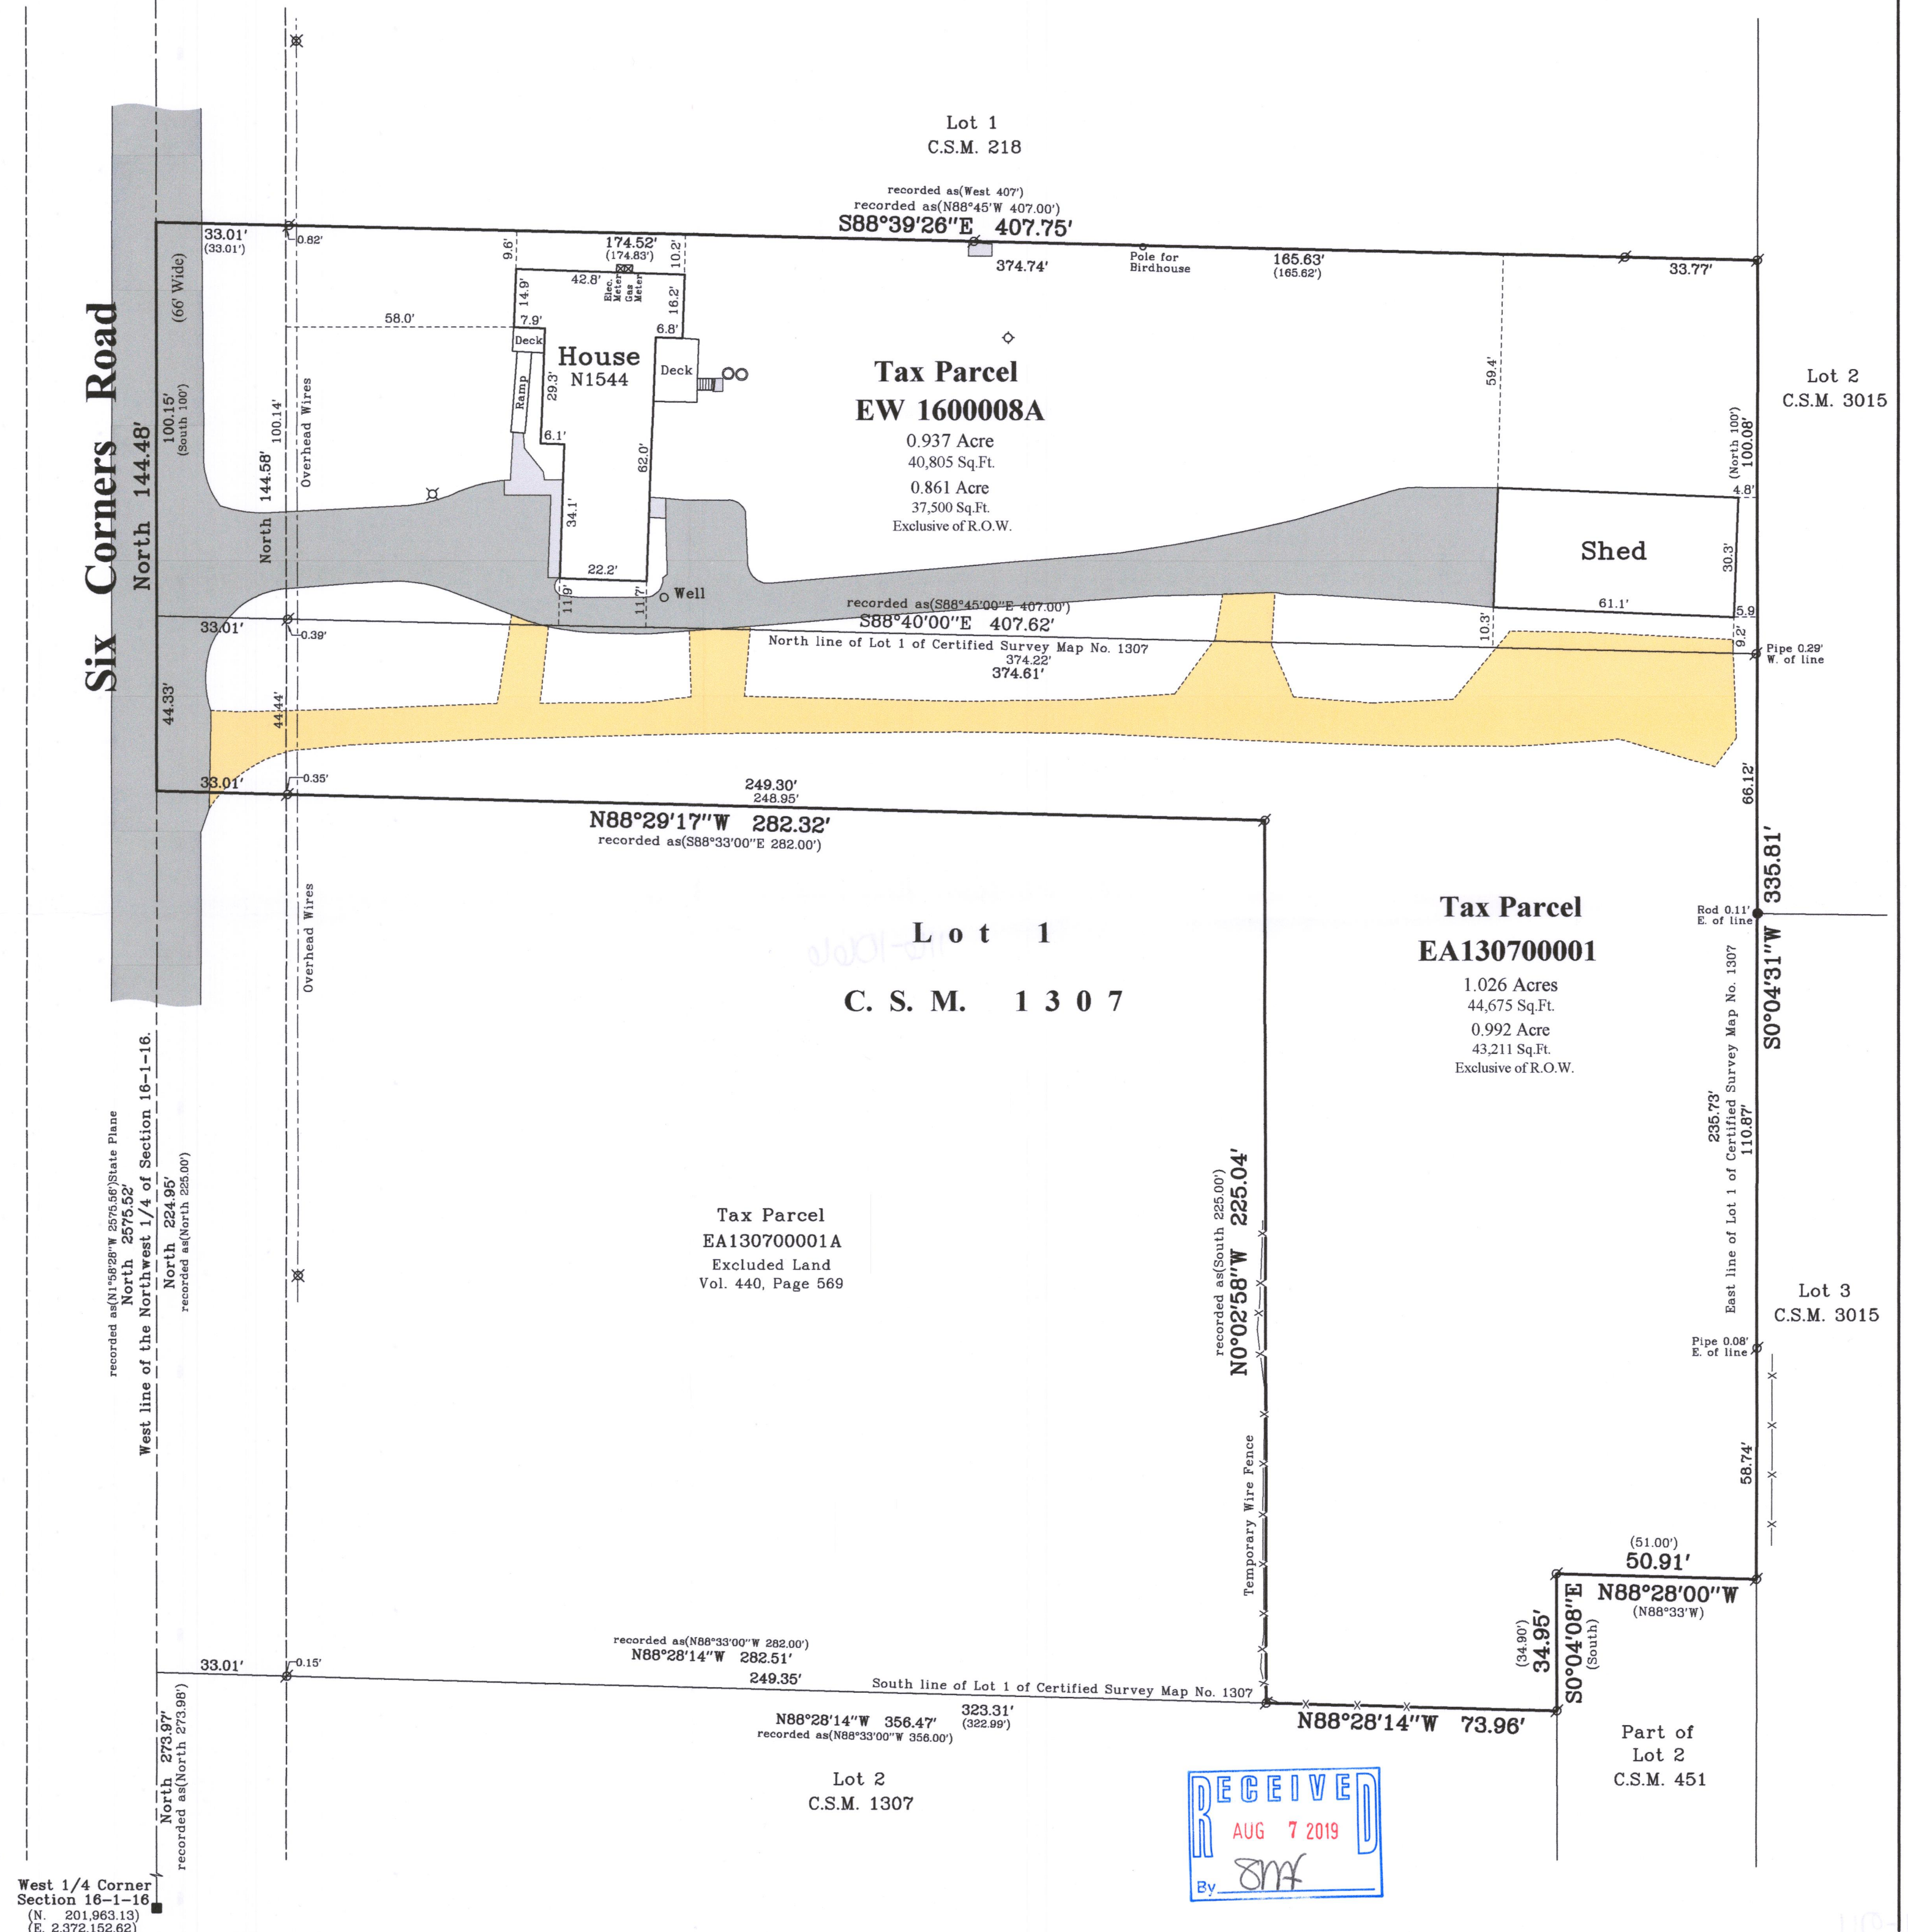

Survey Date: June 23, 2019.

Revisions:

Scale in Feet
1" = 30'

0' 15' 30' 60' 90'

Elkhorn, Wisconsin. 53121
Telephone: (262) 723-3434
Facsimile: (262) 723-8044
Email: doug@olsonsurveying.com
Website: www.olsonsurveying.com



OLSON
LAND SURVEYING, LLC

Rural | Residential | Commercial

■	Found County Section Corner	N	North
●	Found Iron Pipe	S	South
○	Found Iron Rod	E	East
⊗	Recorded Information	W	West
⊙	Utility Pole	°	Degrees
⊗	Utility Pedestal	"	Minutes
⊙	Concrete Cover	"	Seconds
⊗	Asphalt Surface	"	Distances
⊙	Concrete Surface	"	Feet
⊗	Gravel Surface	"	Feet

Sheet 1 of 1 Sheets

Drawing Name:

Job Reference Number

2019.069

2019.069